

268.62 AVE. 235 MIDDLE

Pt. 10-00-014-000-069
Pt. 8.34A.

725.30

677.48

~~Pt. 10-00-014-000-052~~

~~Pt. 13.43A.~~

122 WL

-068
5.09A

OL 7
OL 14

SEE 10-00-000-145.1

751.87

CARLISLE TWP


SCALE: 1" = 100'

Pt. 10-00-014-000-069

8.34A

2503

APPROVED
LORAIN CO.
MAP DEPT.
DATE 3/8/69
P. 10-00-007-E
BY 04-A
R. J. Kelling

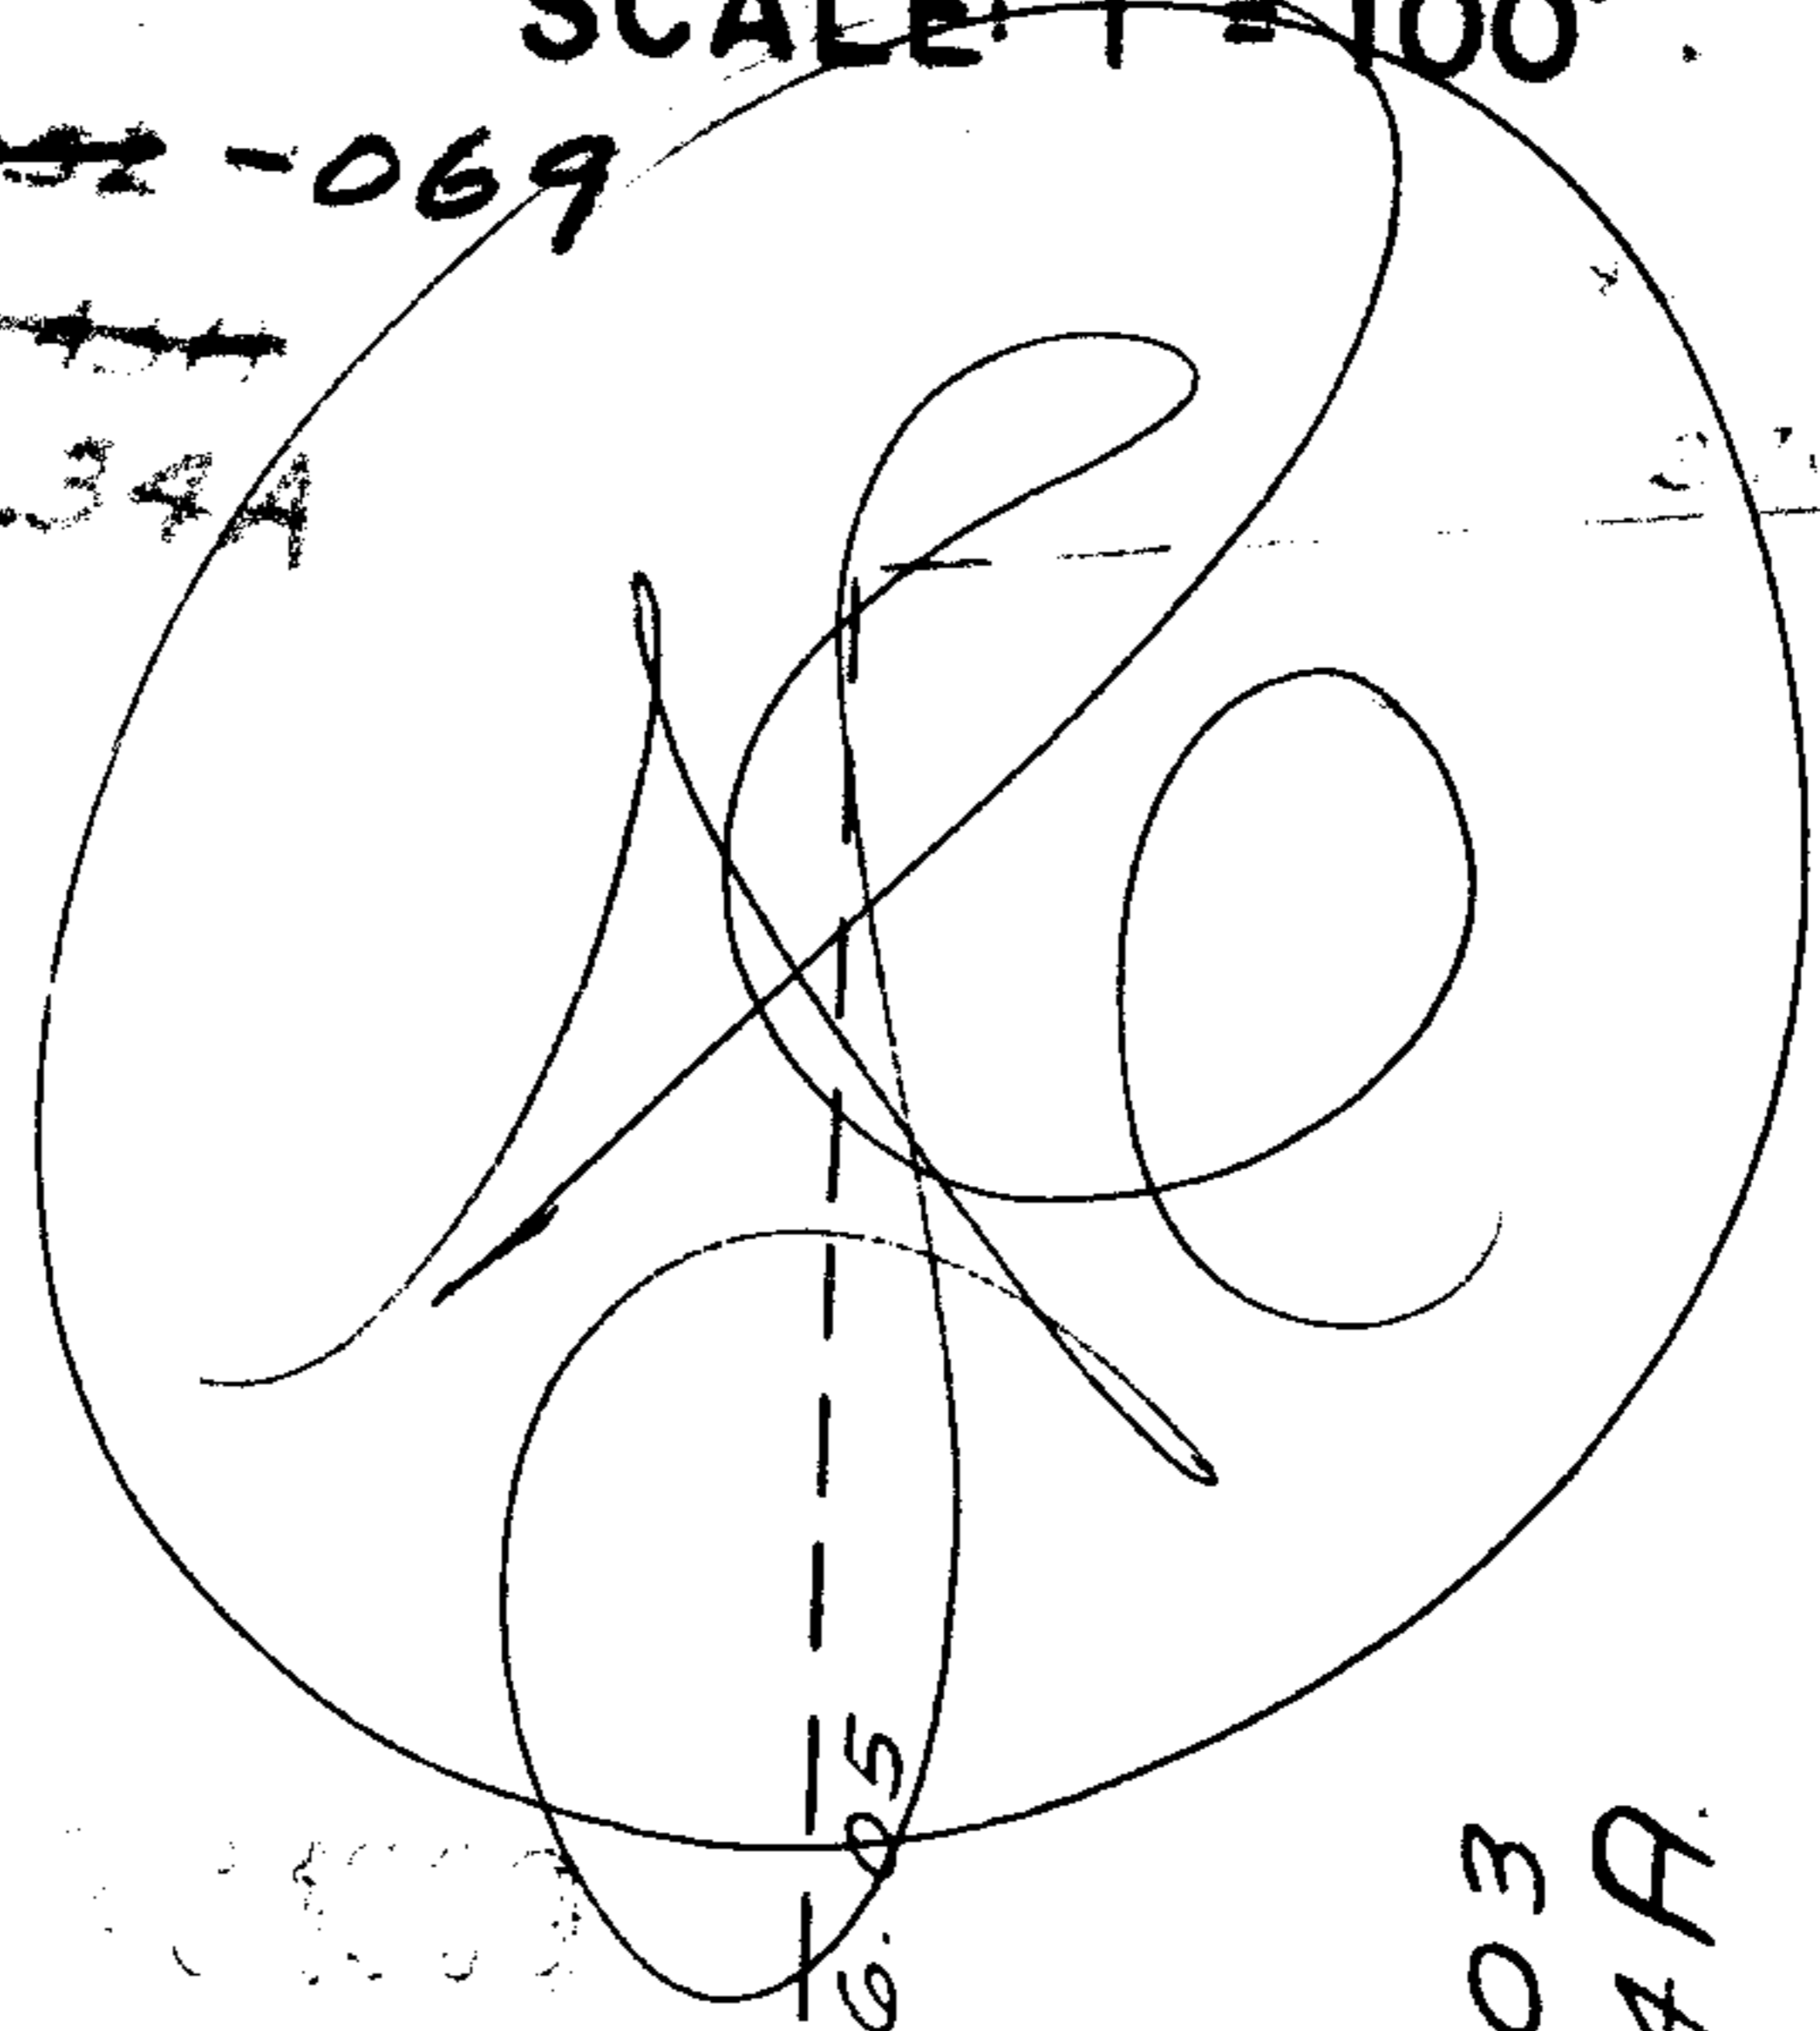

342.97
-002
.98 A.
342.97
238.21 104.76

-003
2.94A.

820.70

Pt. 10-00-014-000-006
Pt. - .99A.

Pt. - C.
Pt. 3

10