

SEE 4-00-022-D

651.86

RD. 60

929.35
411.07

-030
6.06 A.



633.93

1 IN. = 100 FT

~~013~~
~~12.78A~~

880

880.55

2509

-031
6.72 A.


469.48

7-15-86 8.8.

APPROVED
LORAIN CO.
MAP DEPT.
DATE 3-11-69
4-00-022-H.
BY <i>Holliday</i>

APR 29 1969

469.20

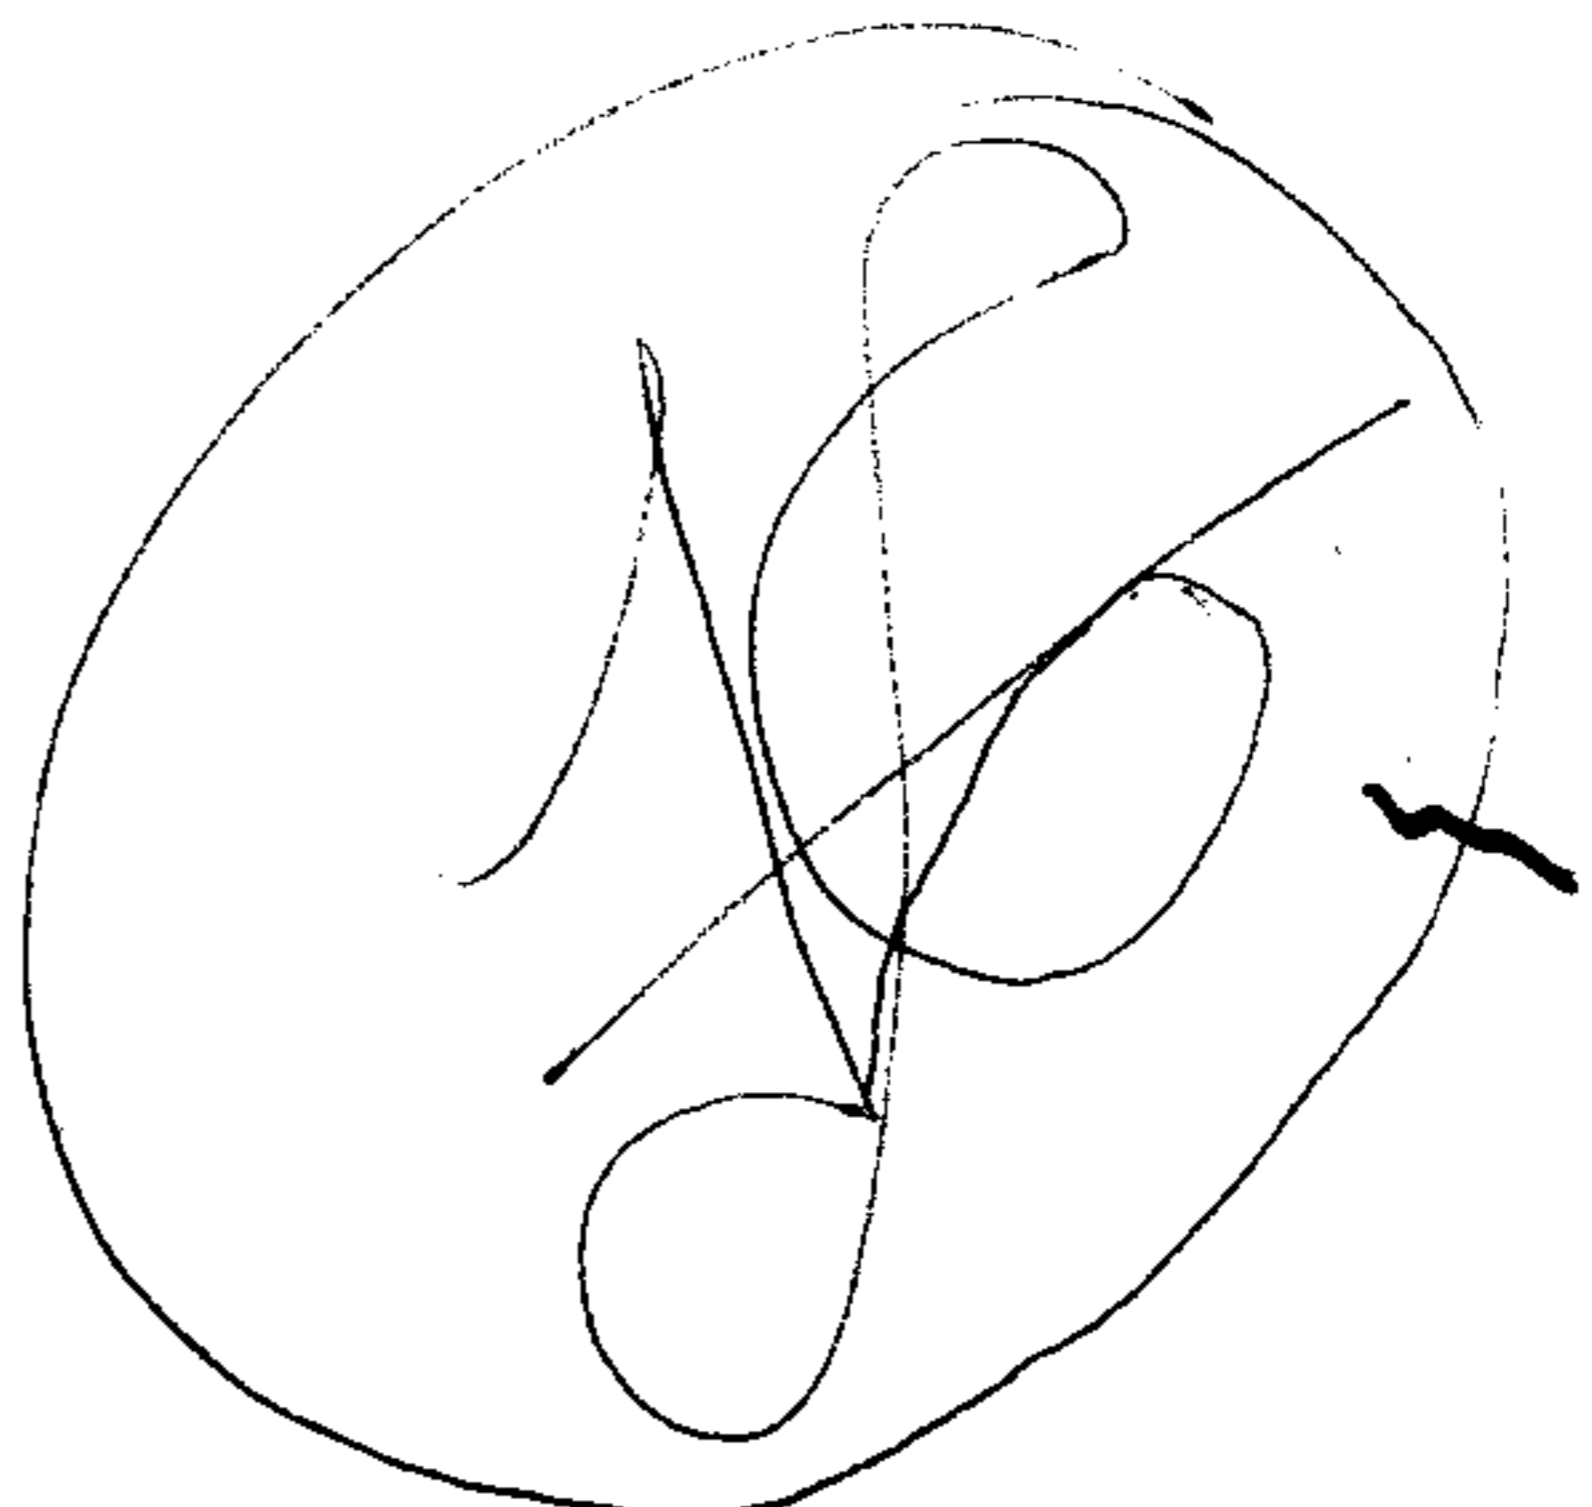

613.45

102

880.55
411.07
469.48

~~2.78~~
~~6.51~~
~~4.72~~