

2512




RD.

(60)



- 001
83.40 A.

8

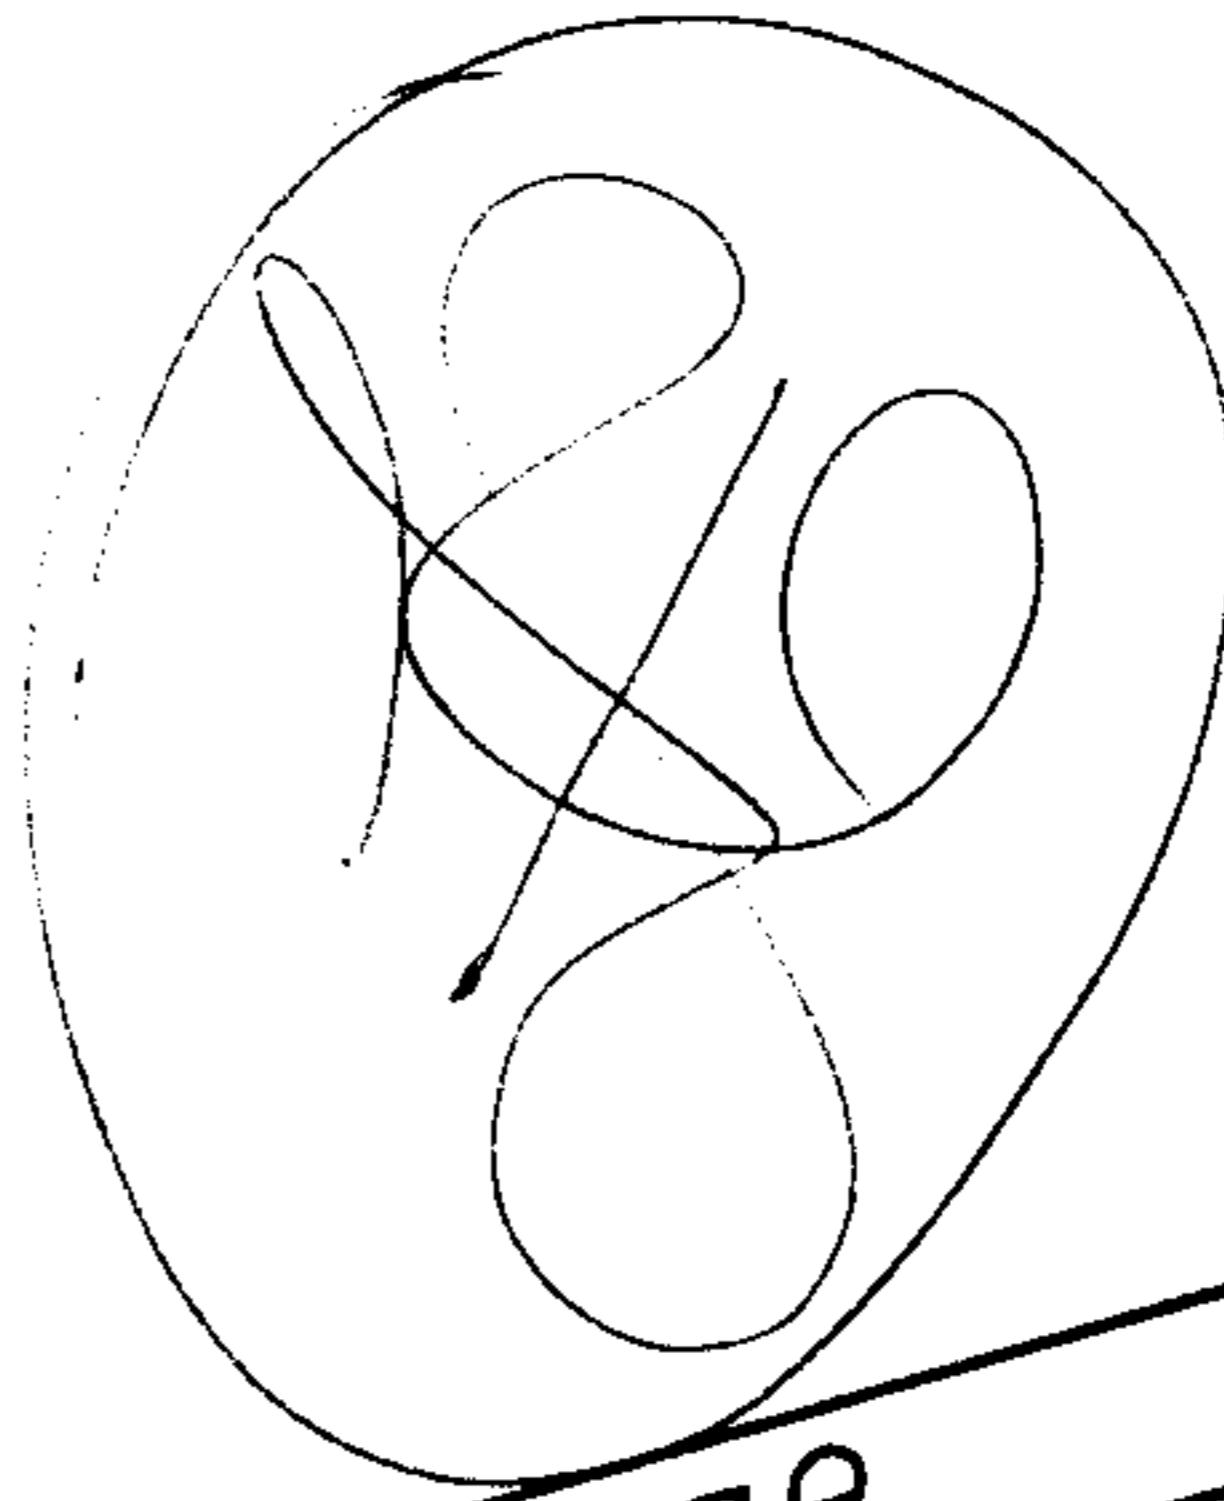

1223.3

N. Y. C.

(500)

- 001

5.37 A.

2335

- 007
- 008
~~27.50 A. Dup.~~
~~29.00 A. D.~~
51.56

902.3

600

- 006

524.4 B

6.44 A.

412.2 A

- 007
- 001
~~30.50 A.~~
~~33.00 A. D.~~

13

- 005
48.93 A

APPROVED
LORAIN CO.
MAP DEPT.
DATE 3/10/69
BY 13-D
BY R. J. Kelling

20
150 678
- 004
1.07 A
217.80

MAR 26 1969

- 003
24.50 A.

C.