


NORTHFIELD DR


NORTHFIELD DR

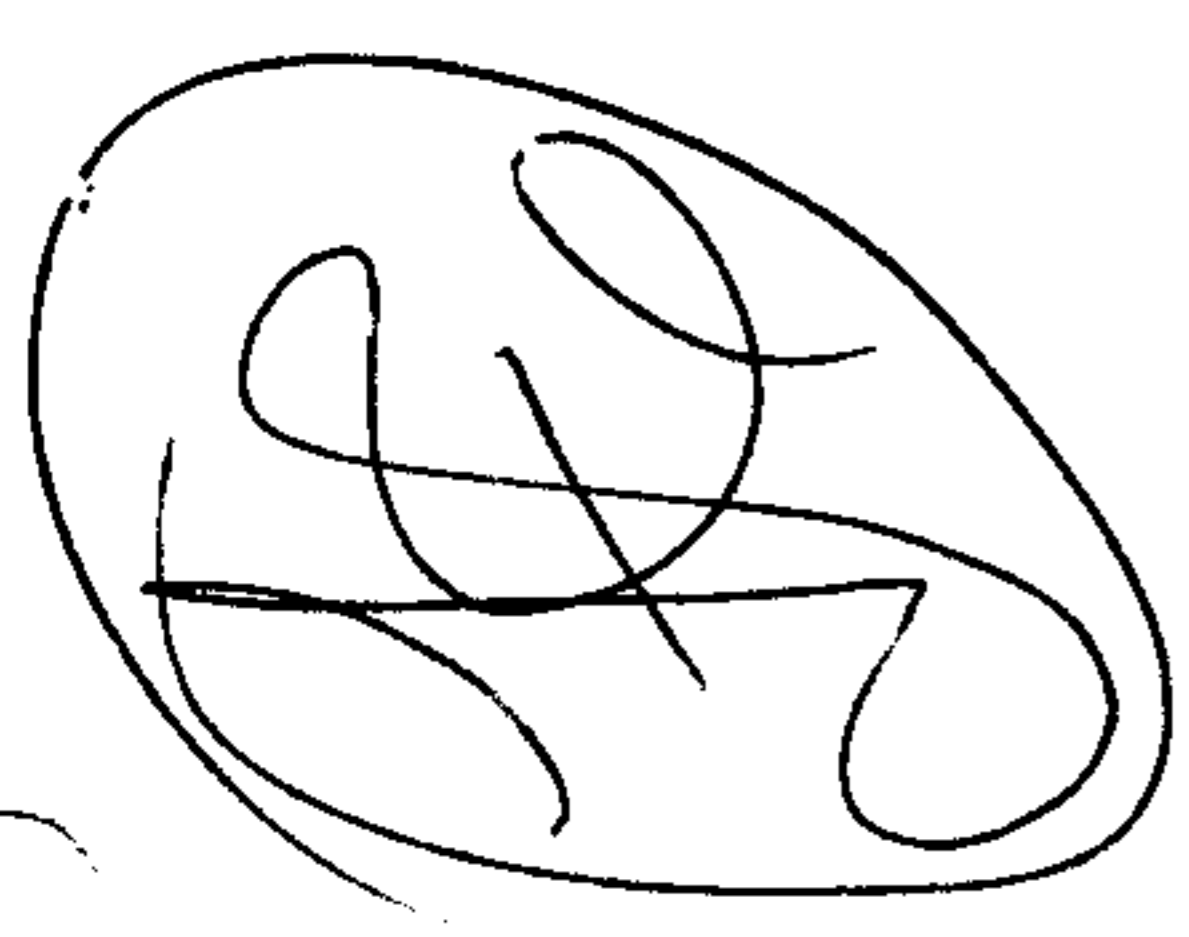


APPROVED  
 LORAIN CO.  
 MAP DEPT.  
 DATE 3/15/69  
 BY R. L. Kelly

APR 5 1969


2534  
 2533  
 2532  
 2531  
 2530

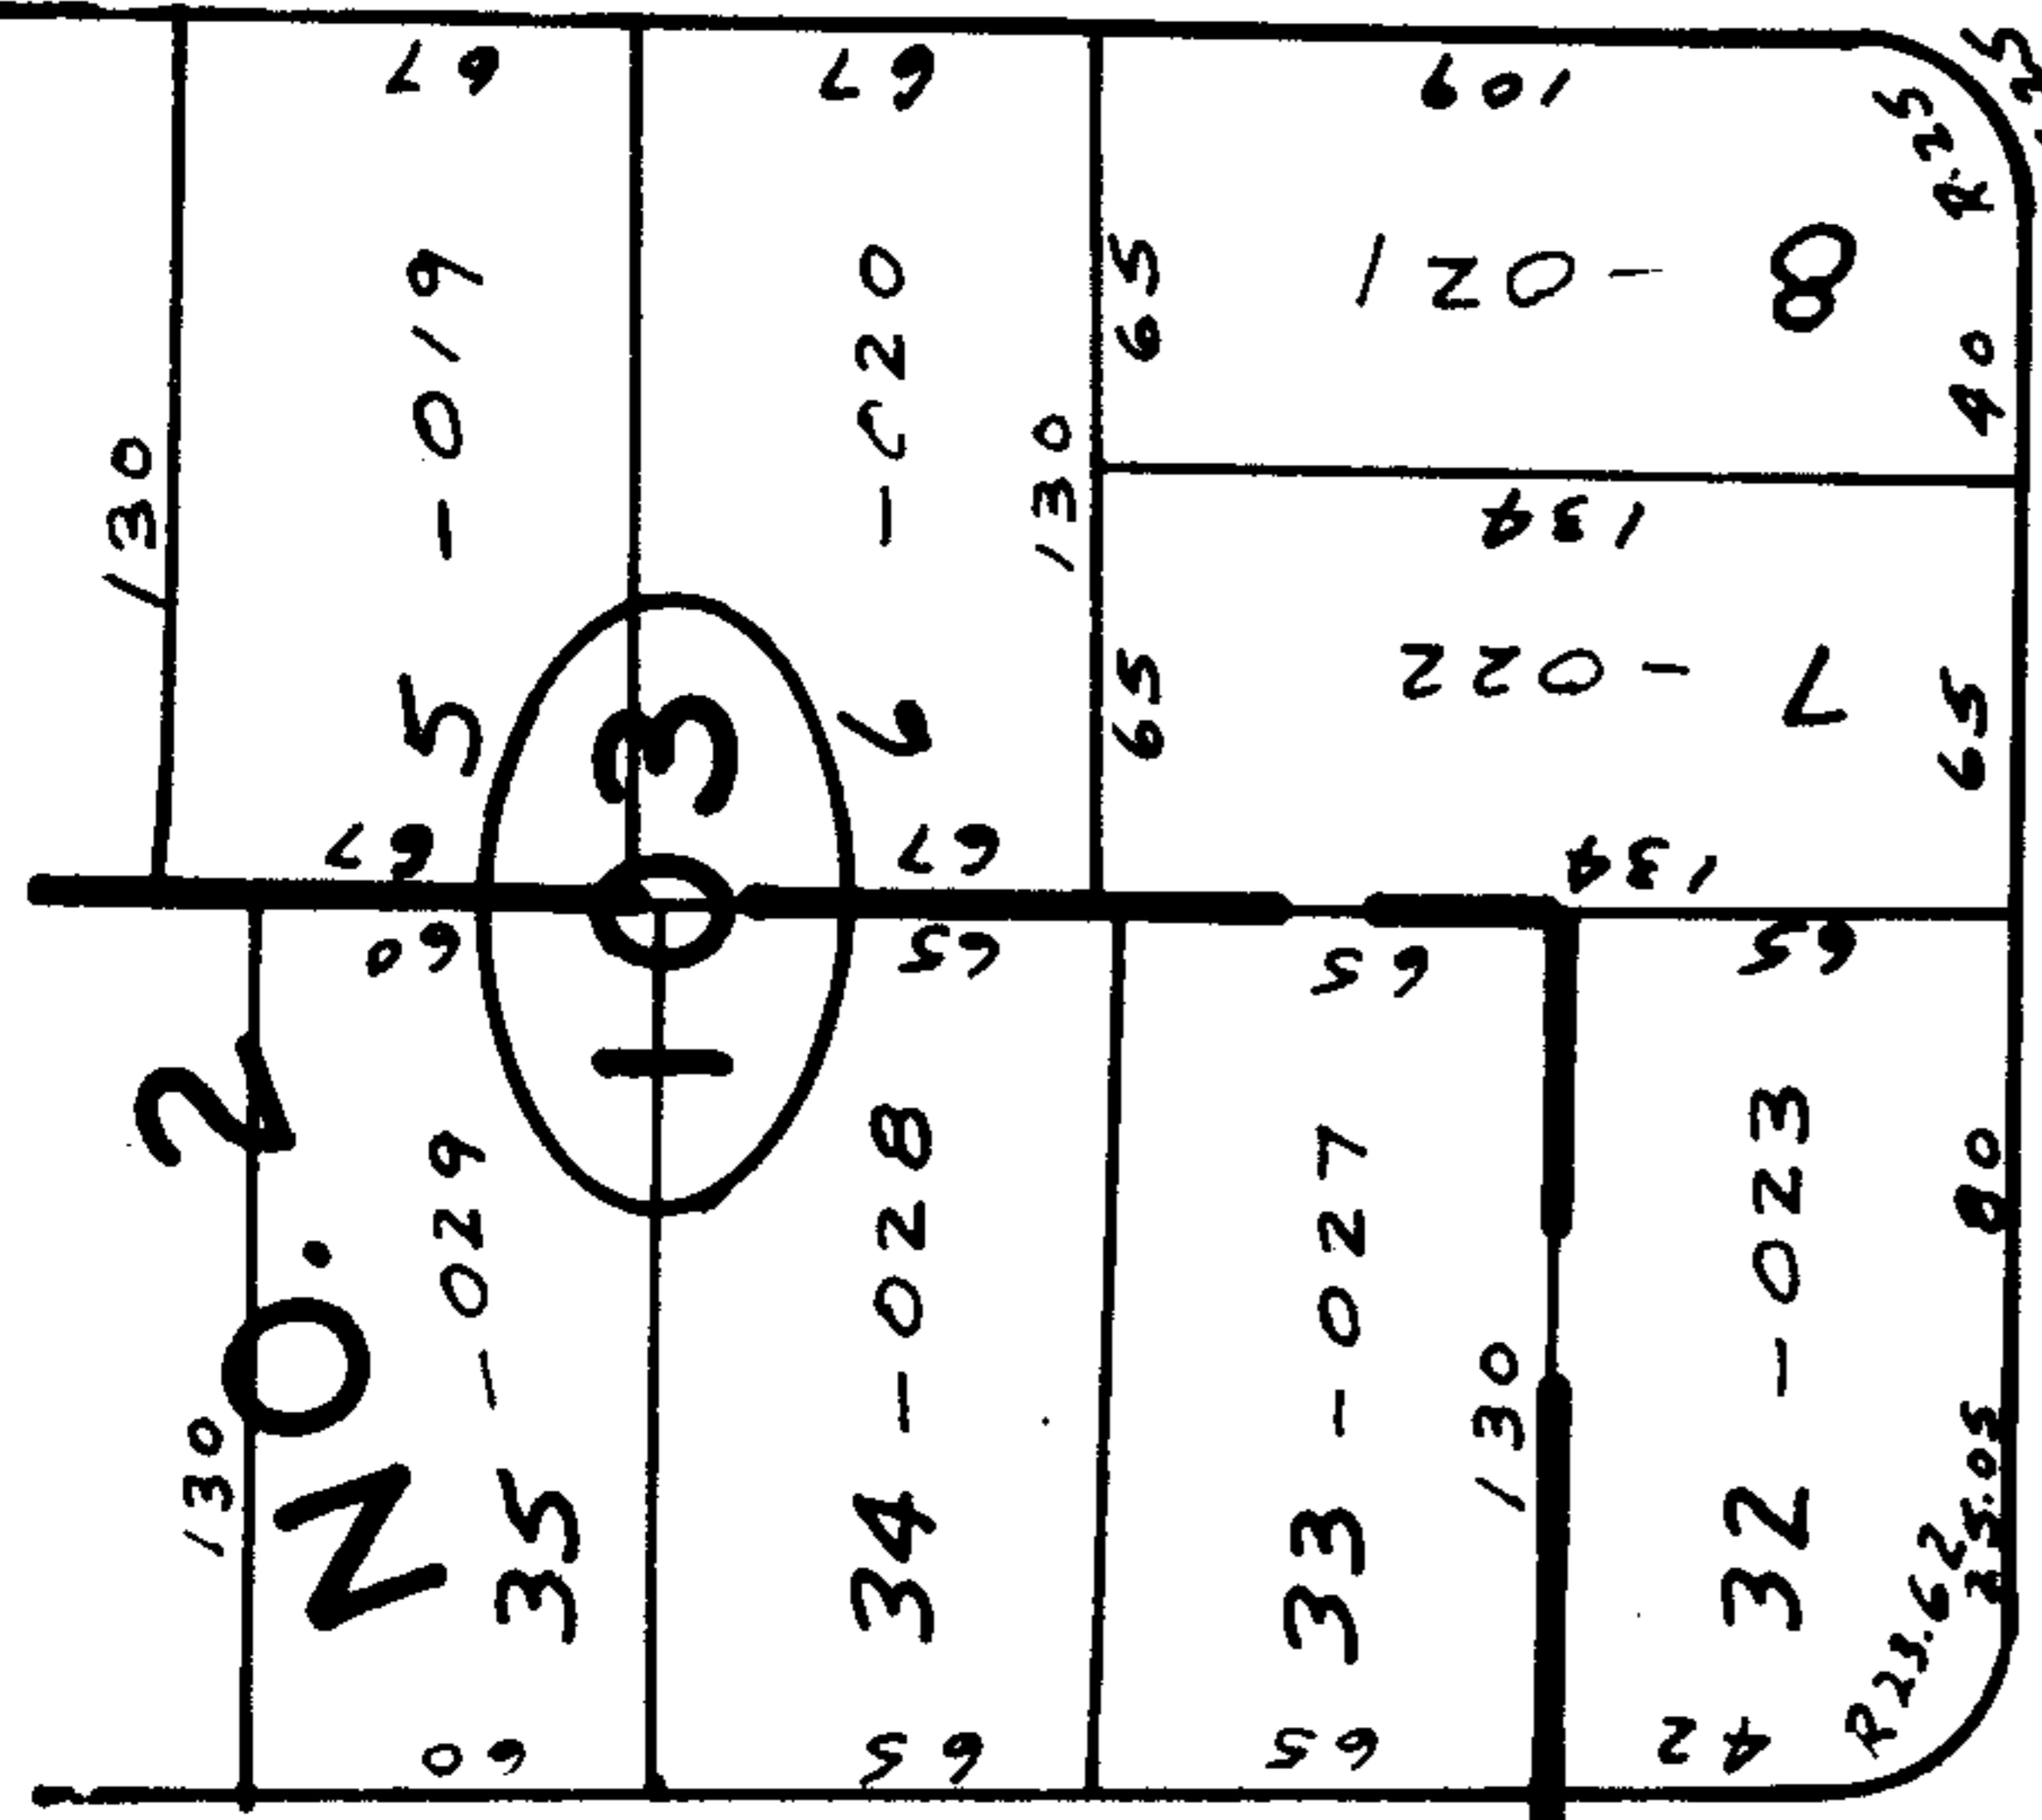

DR.

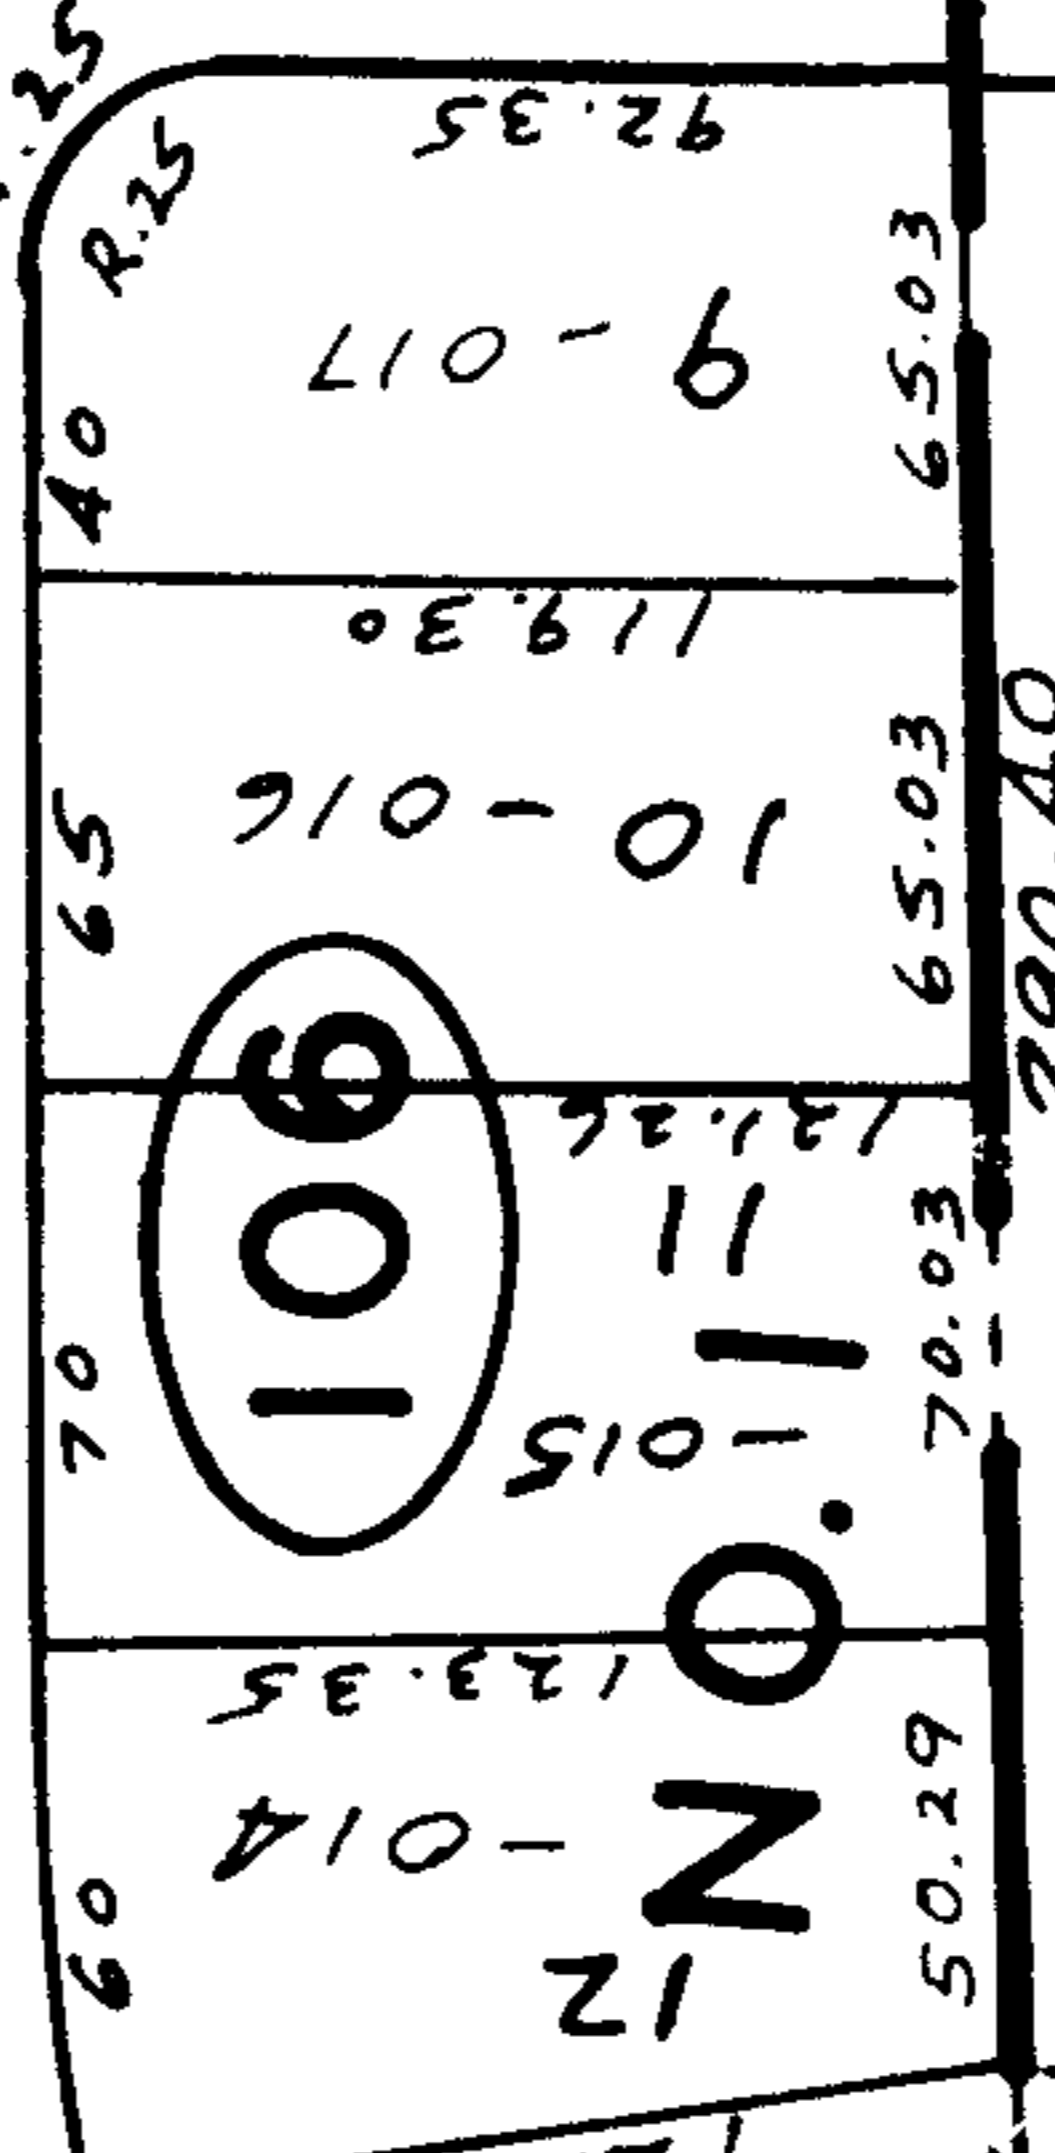

SUB.

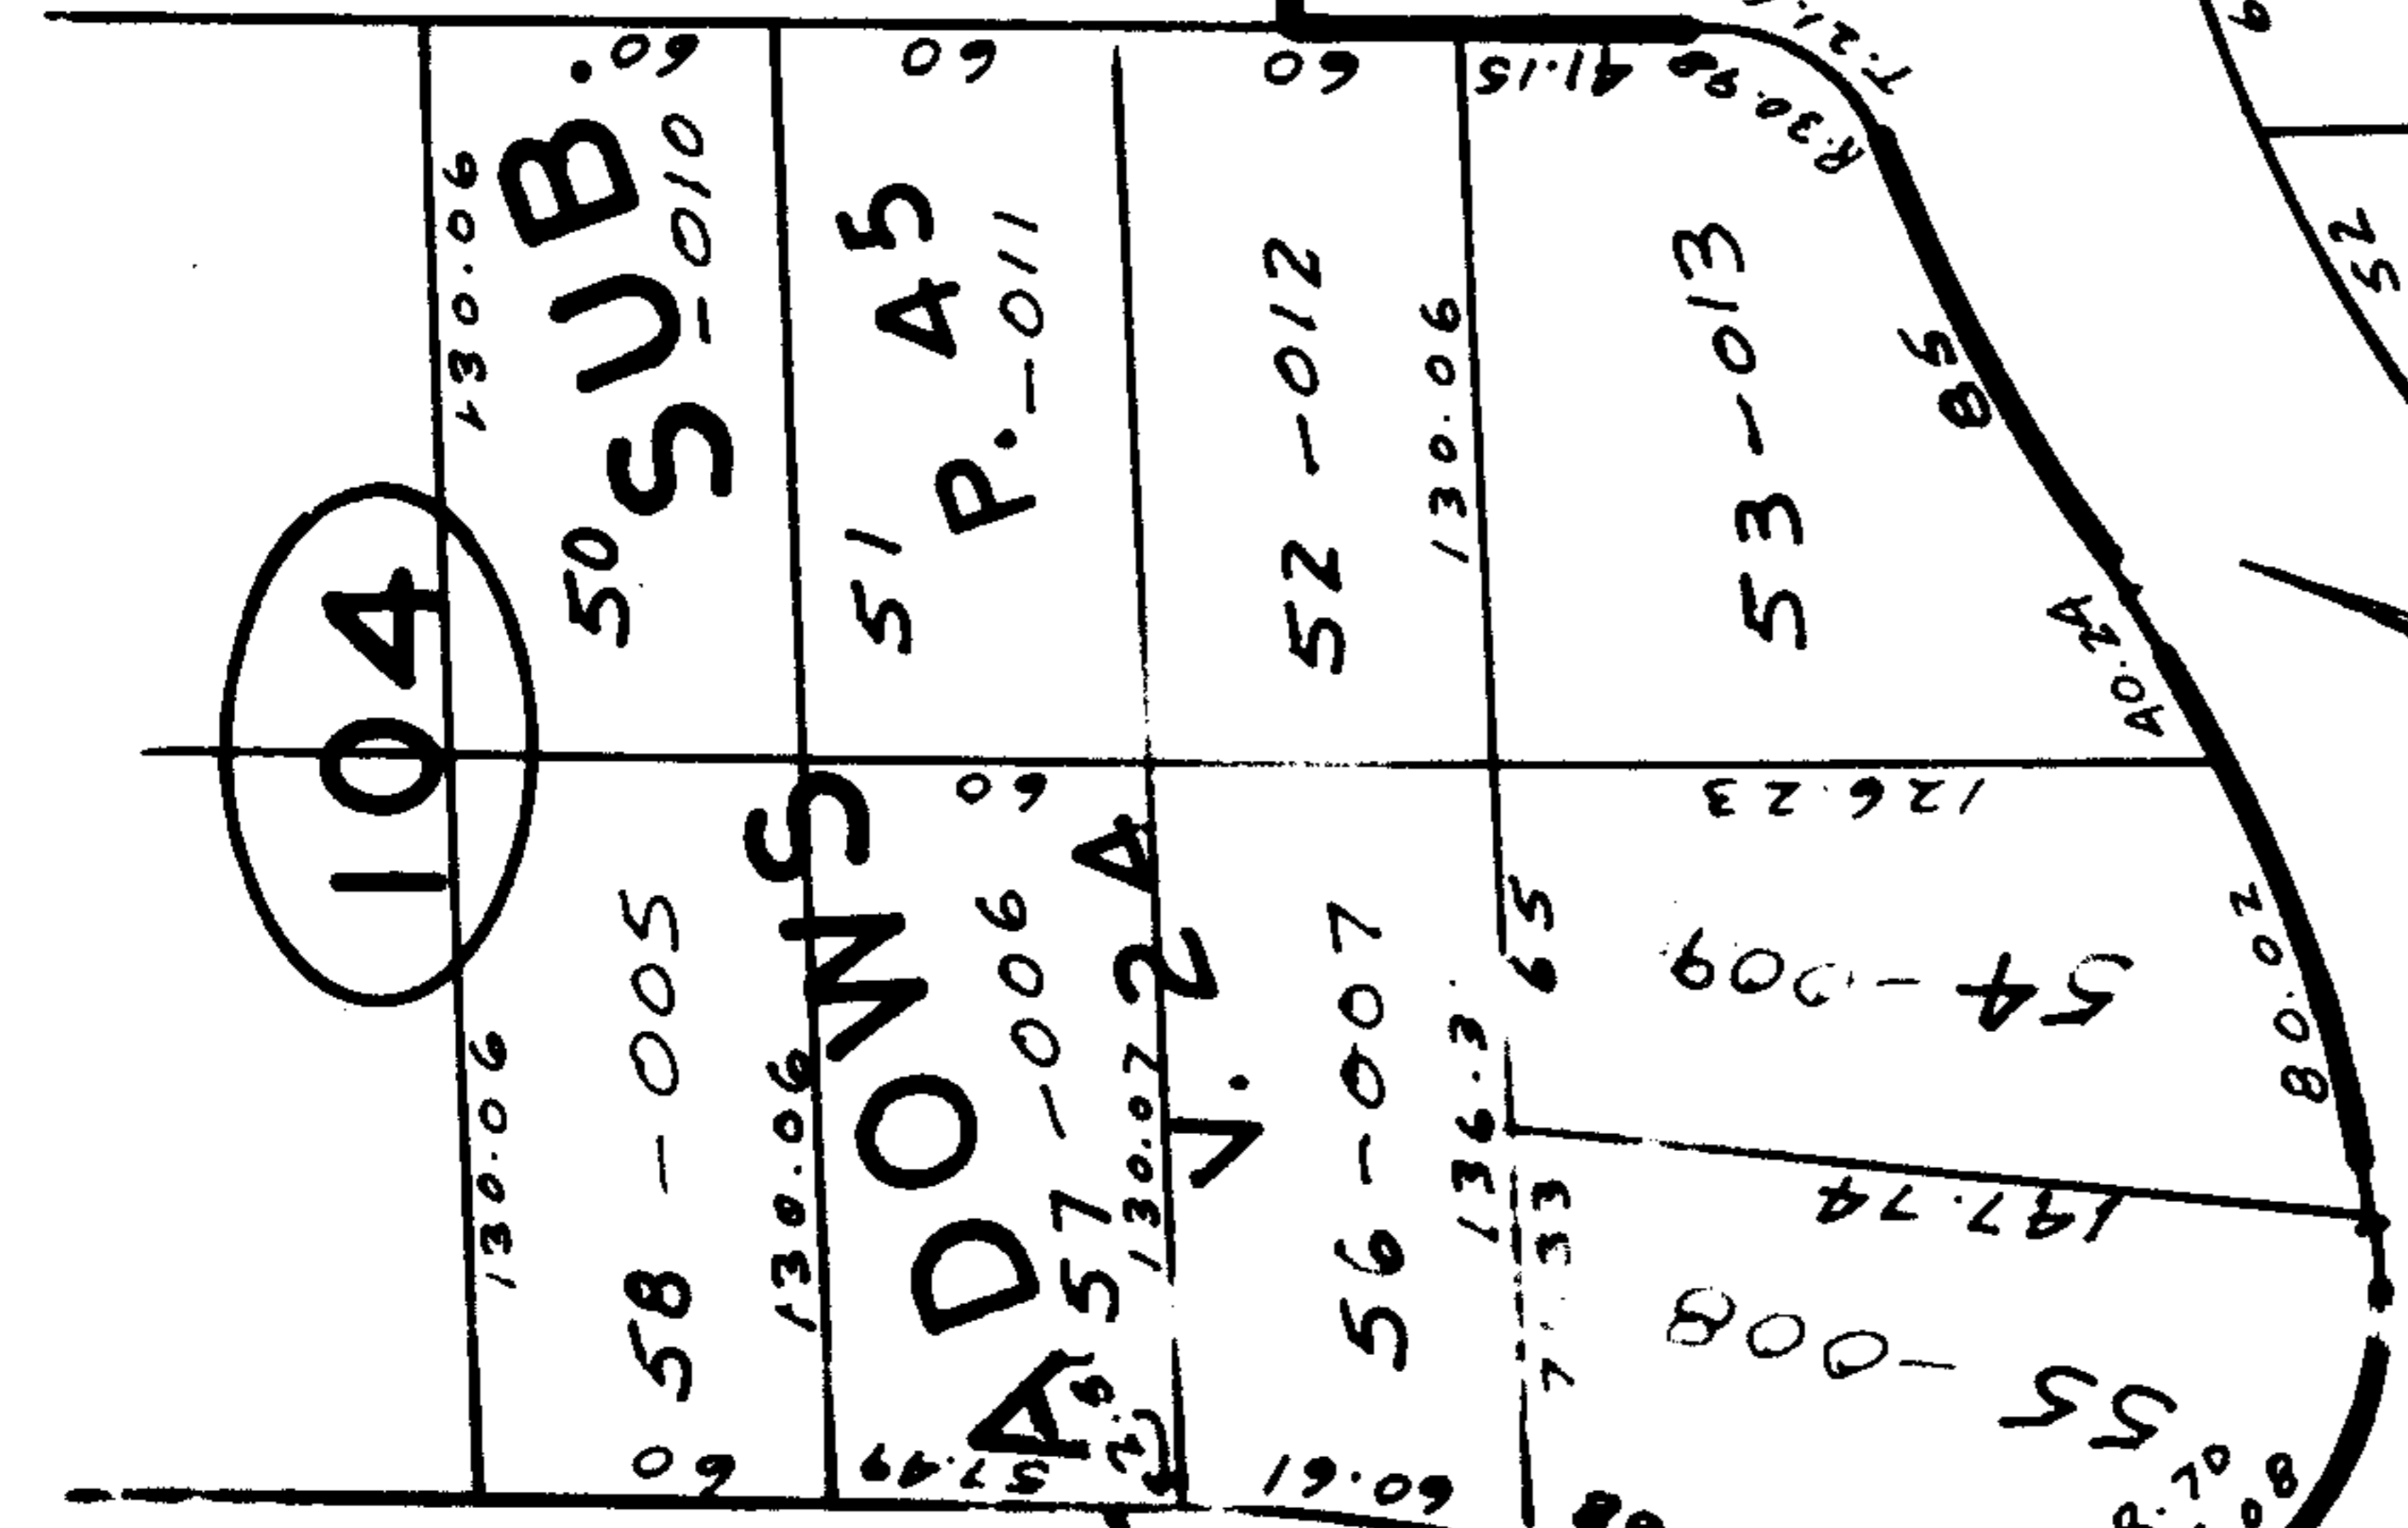


EDGEFIELD DR

104

50 SUB.


ADOWNS  
V. 2A

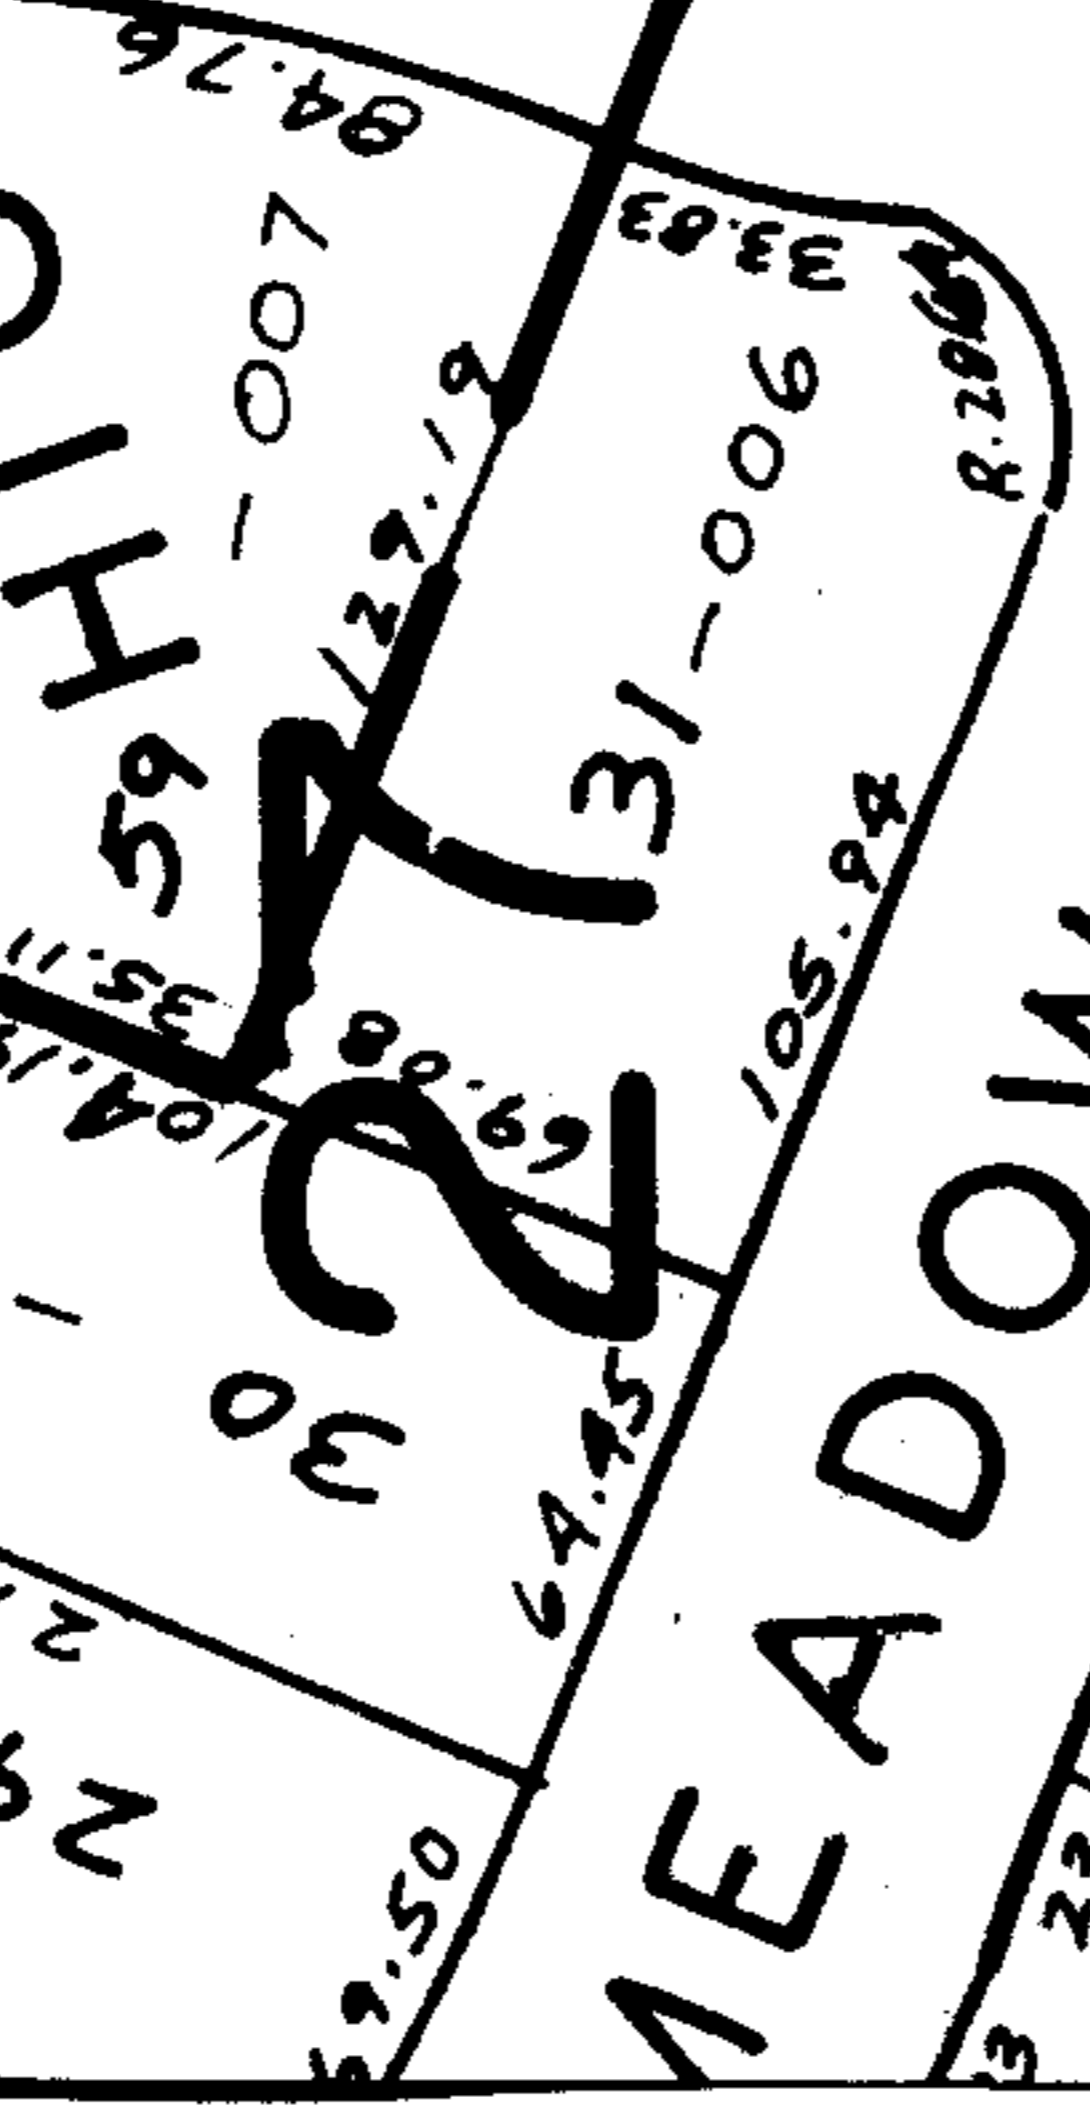

MEADOW

ADOWNS

BRACE

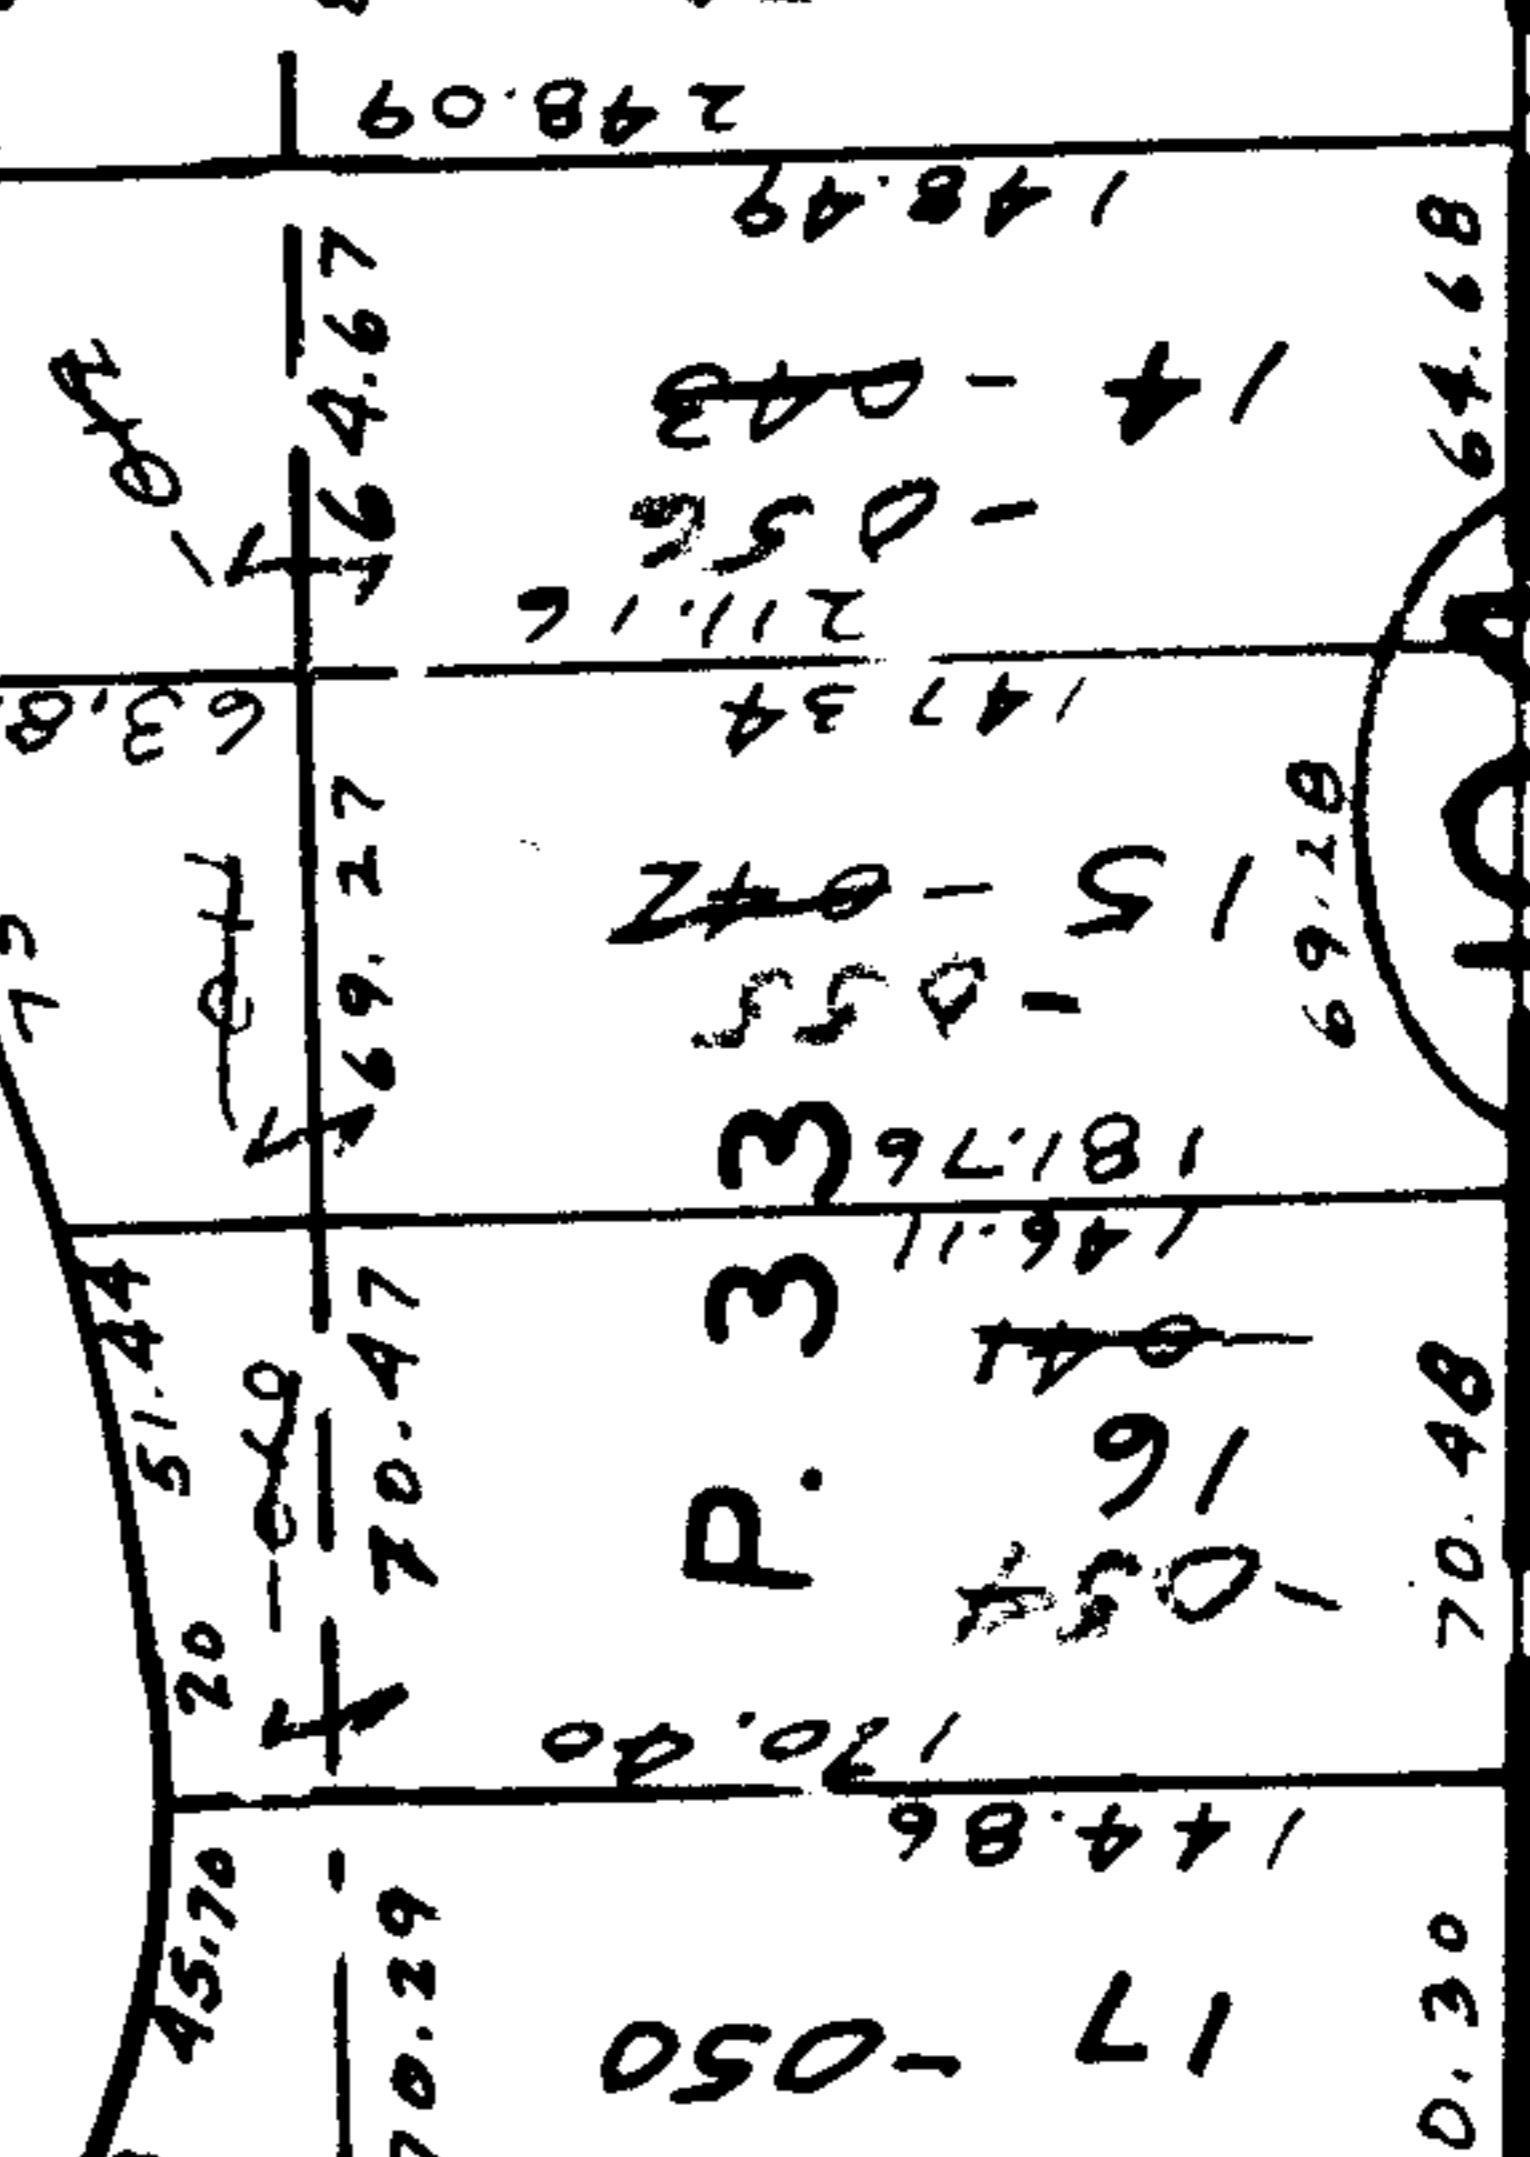

104

92-001

12-045

11-18.81

10-022

9-021

8-020

7-019

6-018

5-017

4-015

3-016

2-015

1-014

0-013