


748.60  
NOON

-031  
5.92A.

-030  
35A.  
75  
180

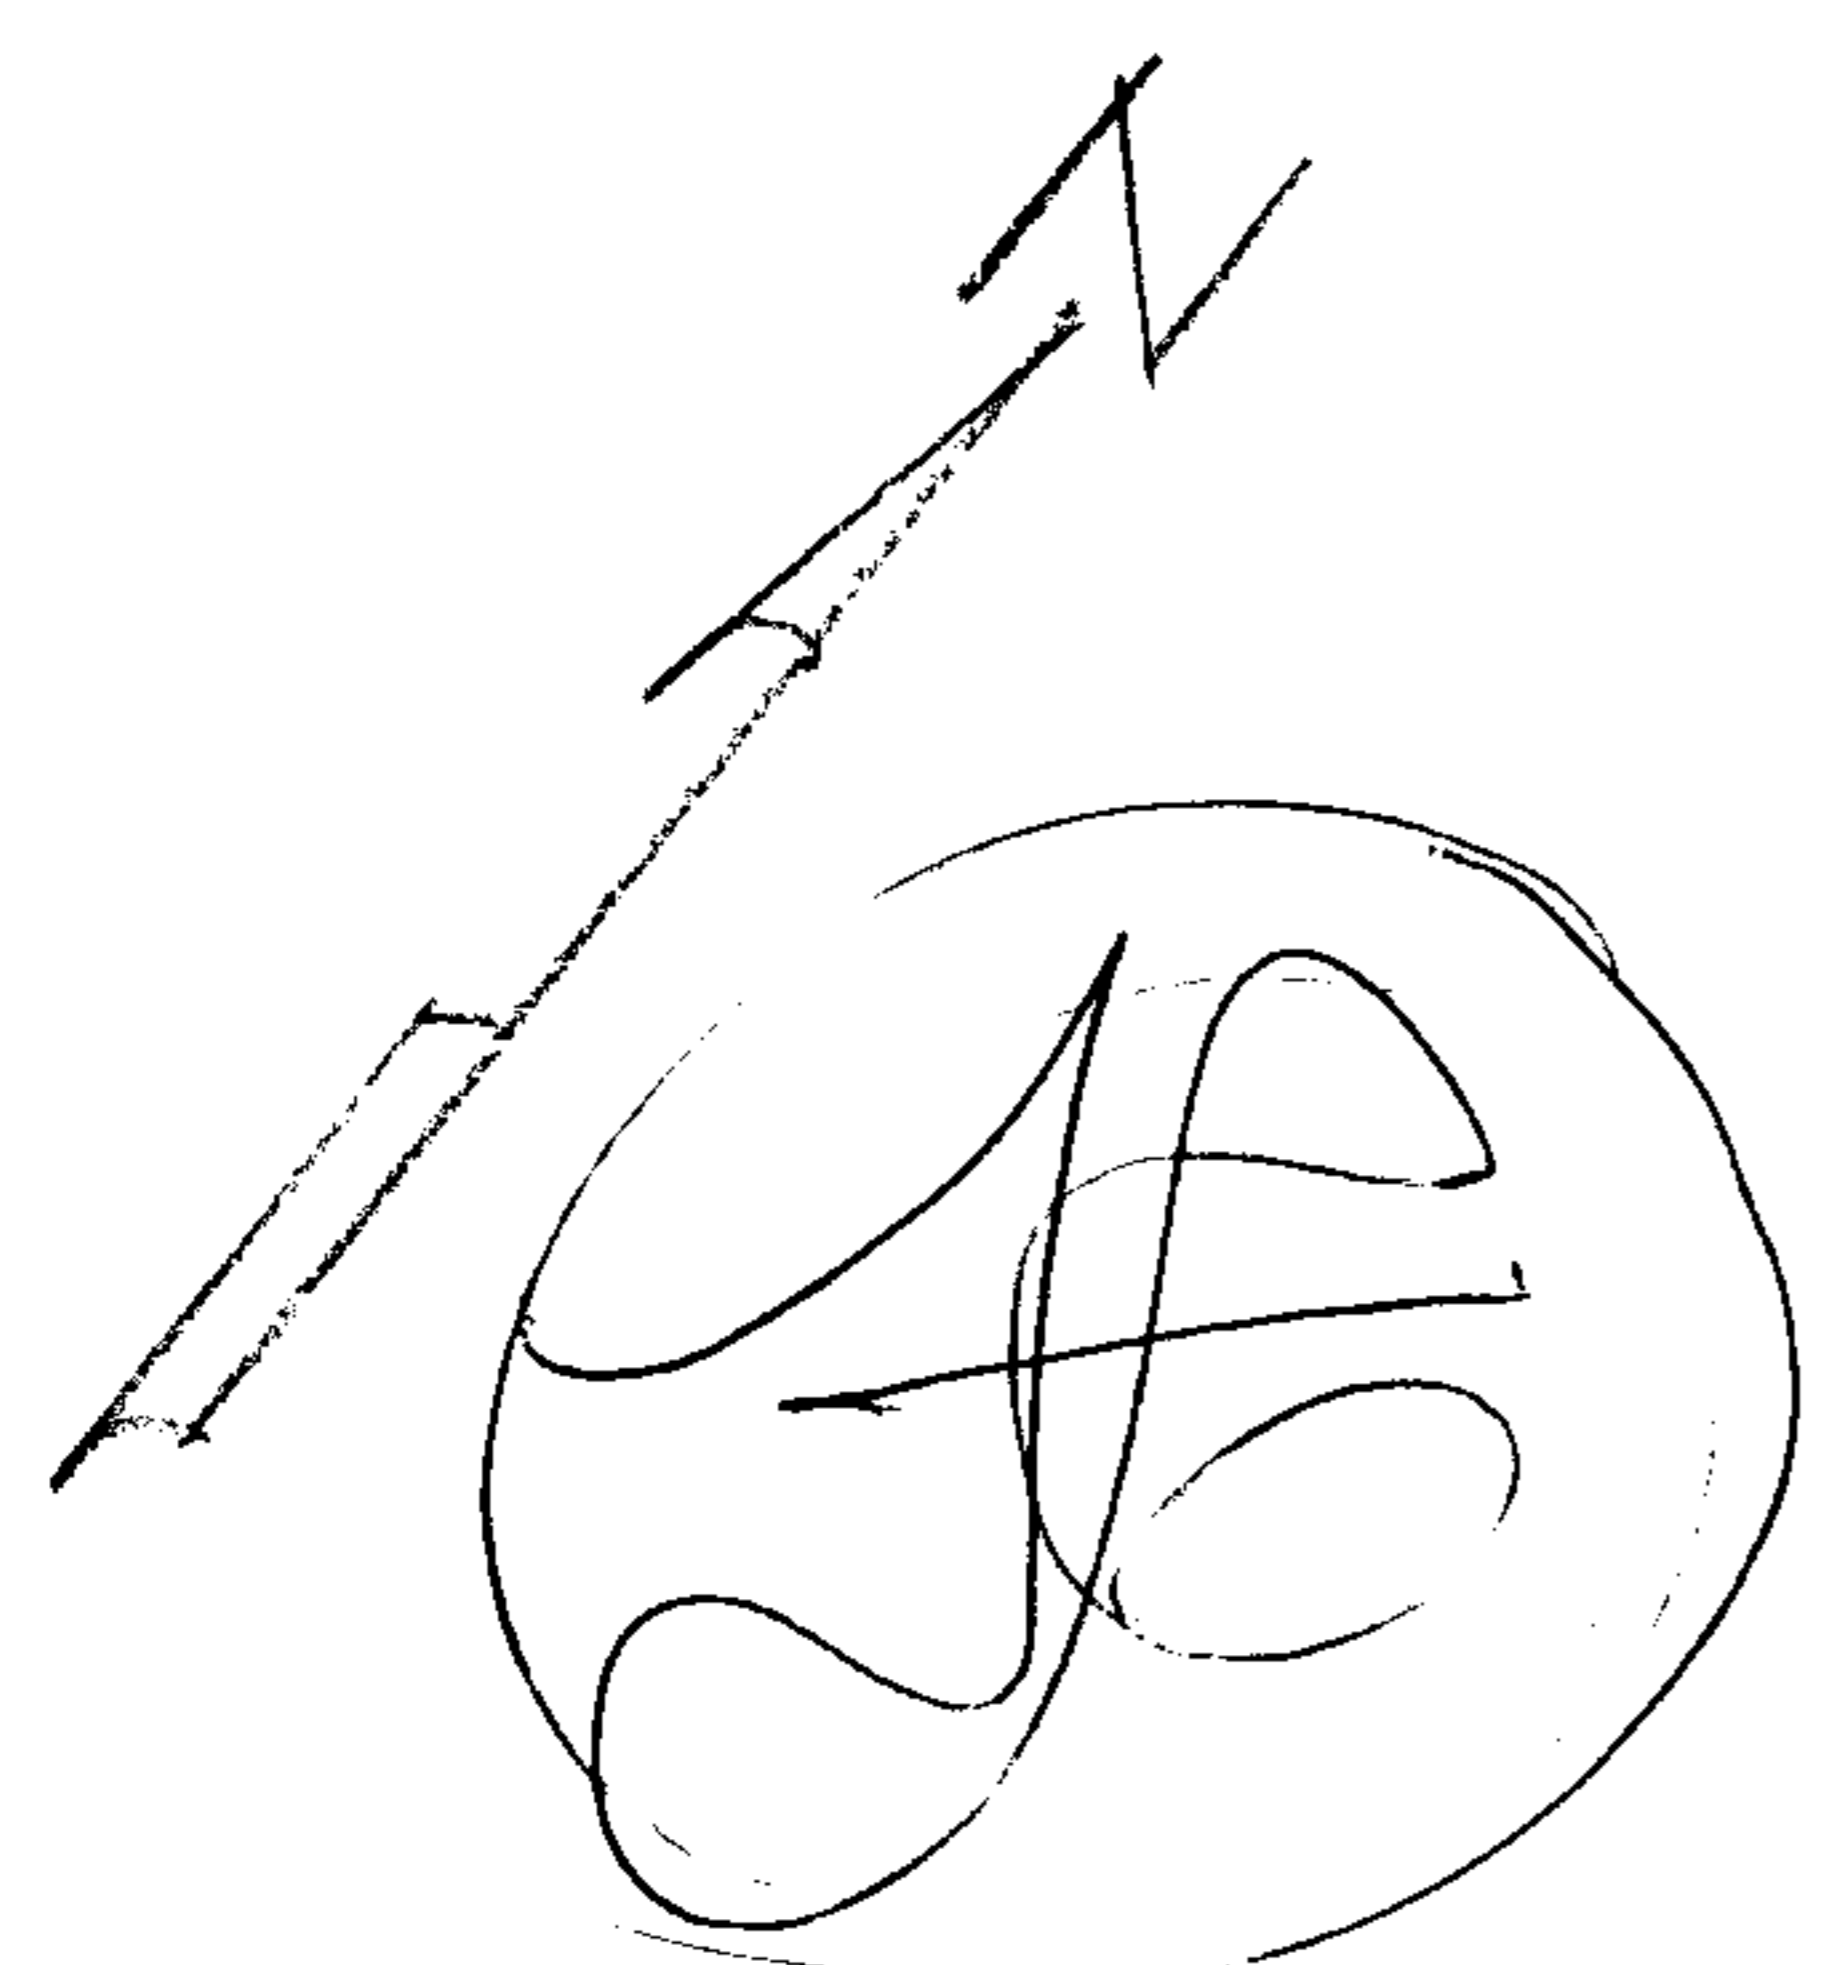

95.02  
NORTH RIDGE

140 66 68 483.57 89.85 60.68

-001  
.28A.

-002  
.52A.

Pt. 04-00-001-103-010  
Pt. 51.28

-004  
1.69A.

598.22  
258.20  
-025  
.41A.  
269

455

-028  
.31  
42 Total  
275.02

-030  
~~-024~~  
2.69A.

1.49  
1.02  
1.51 Total

-029  
0.75A

733.86

2549

APPROVED  
LORAIN CO.  
MAP DEPT.  
DATE 3/21/69  
BY 4-10-002-G  
Rev. Helling

8.8 978-51-6

54-1  
68.18

156.86  
426.25

61.15

-006  
3

198.6