


Pt. -007
Pt. 3738 A.


157-1-1
Twp. 7. N. R. 25. W.
A 115

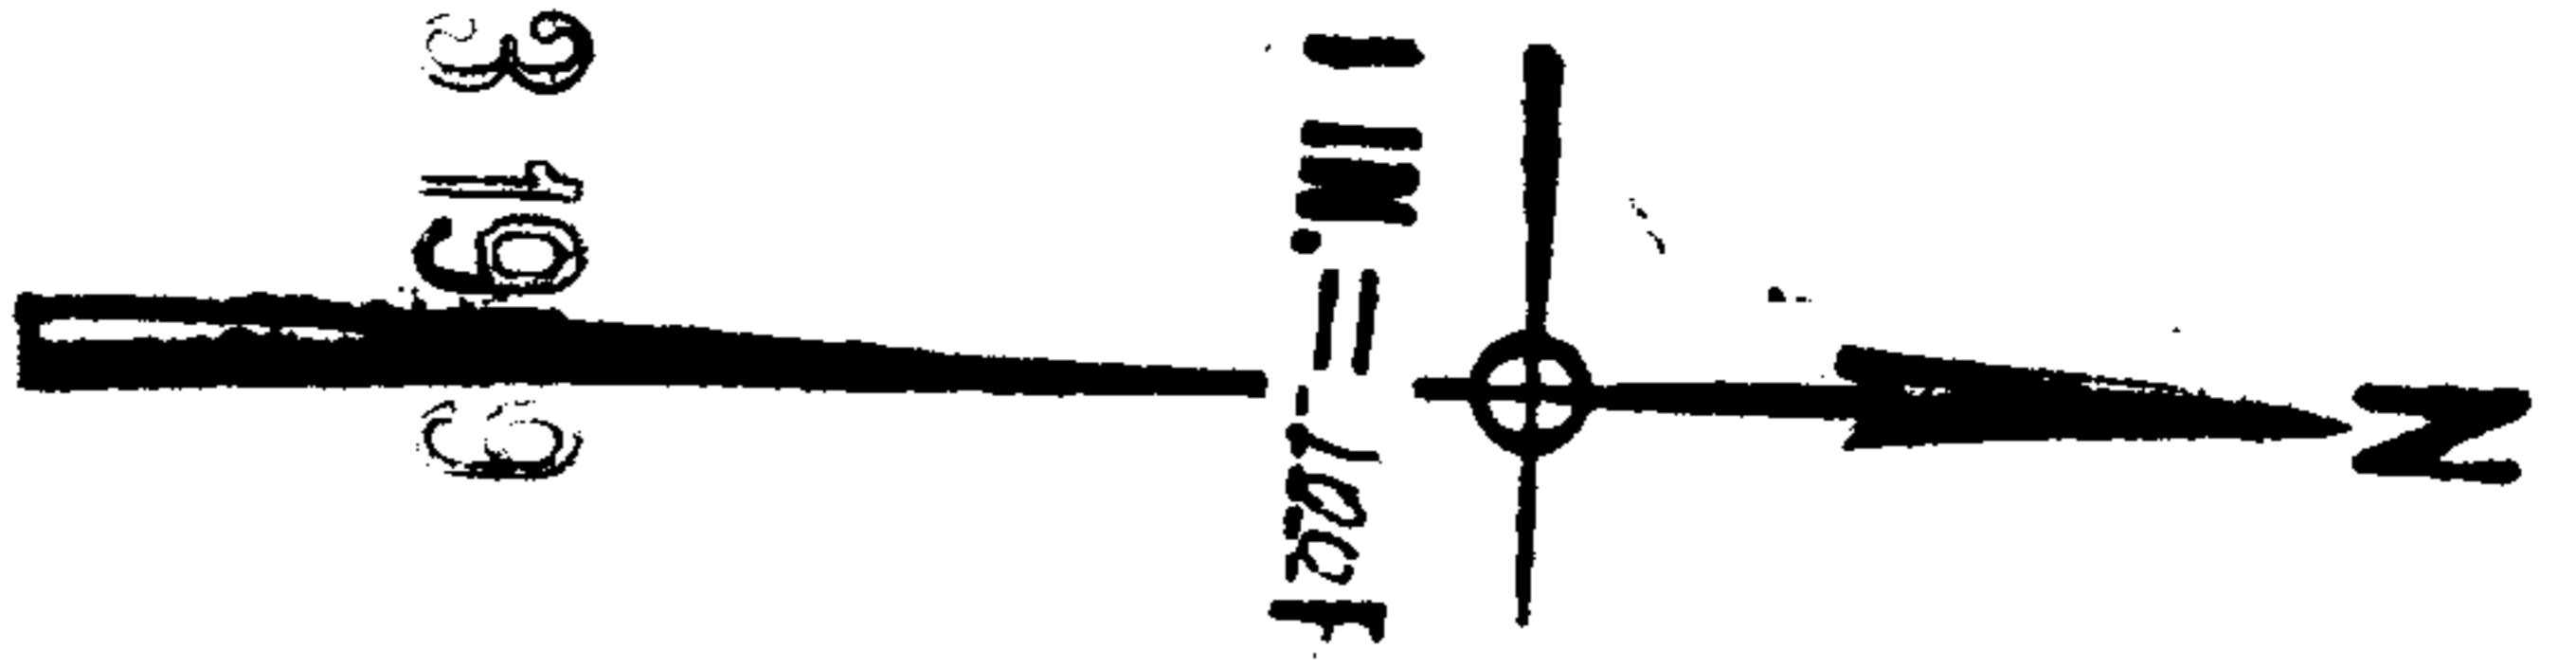

APR 23 1969

2591

APPROVED
LORAIN CO.
MAP DEPT.
DATE 4-8-69
BY 2-02-005-B
W. Colwell

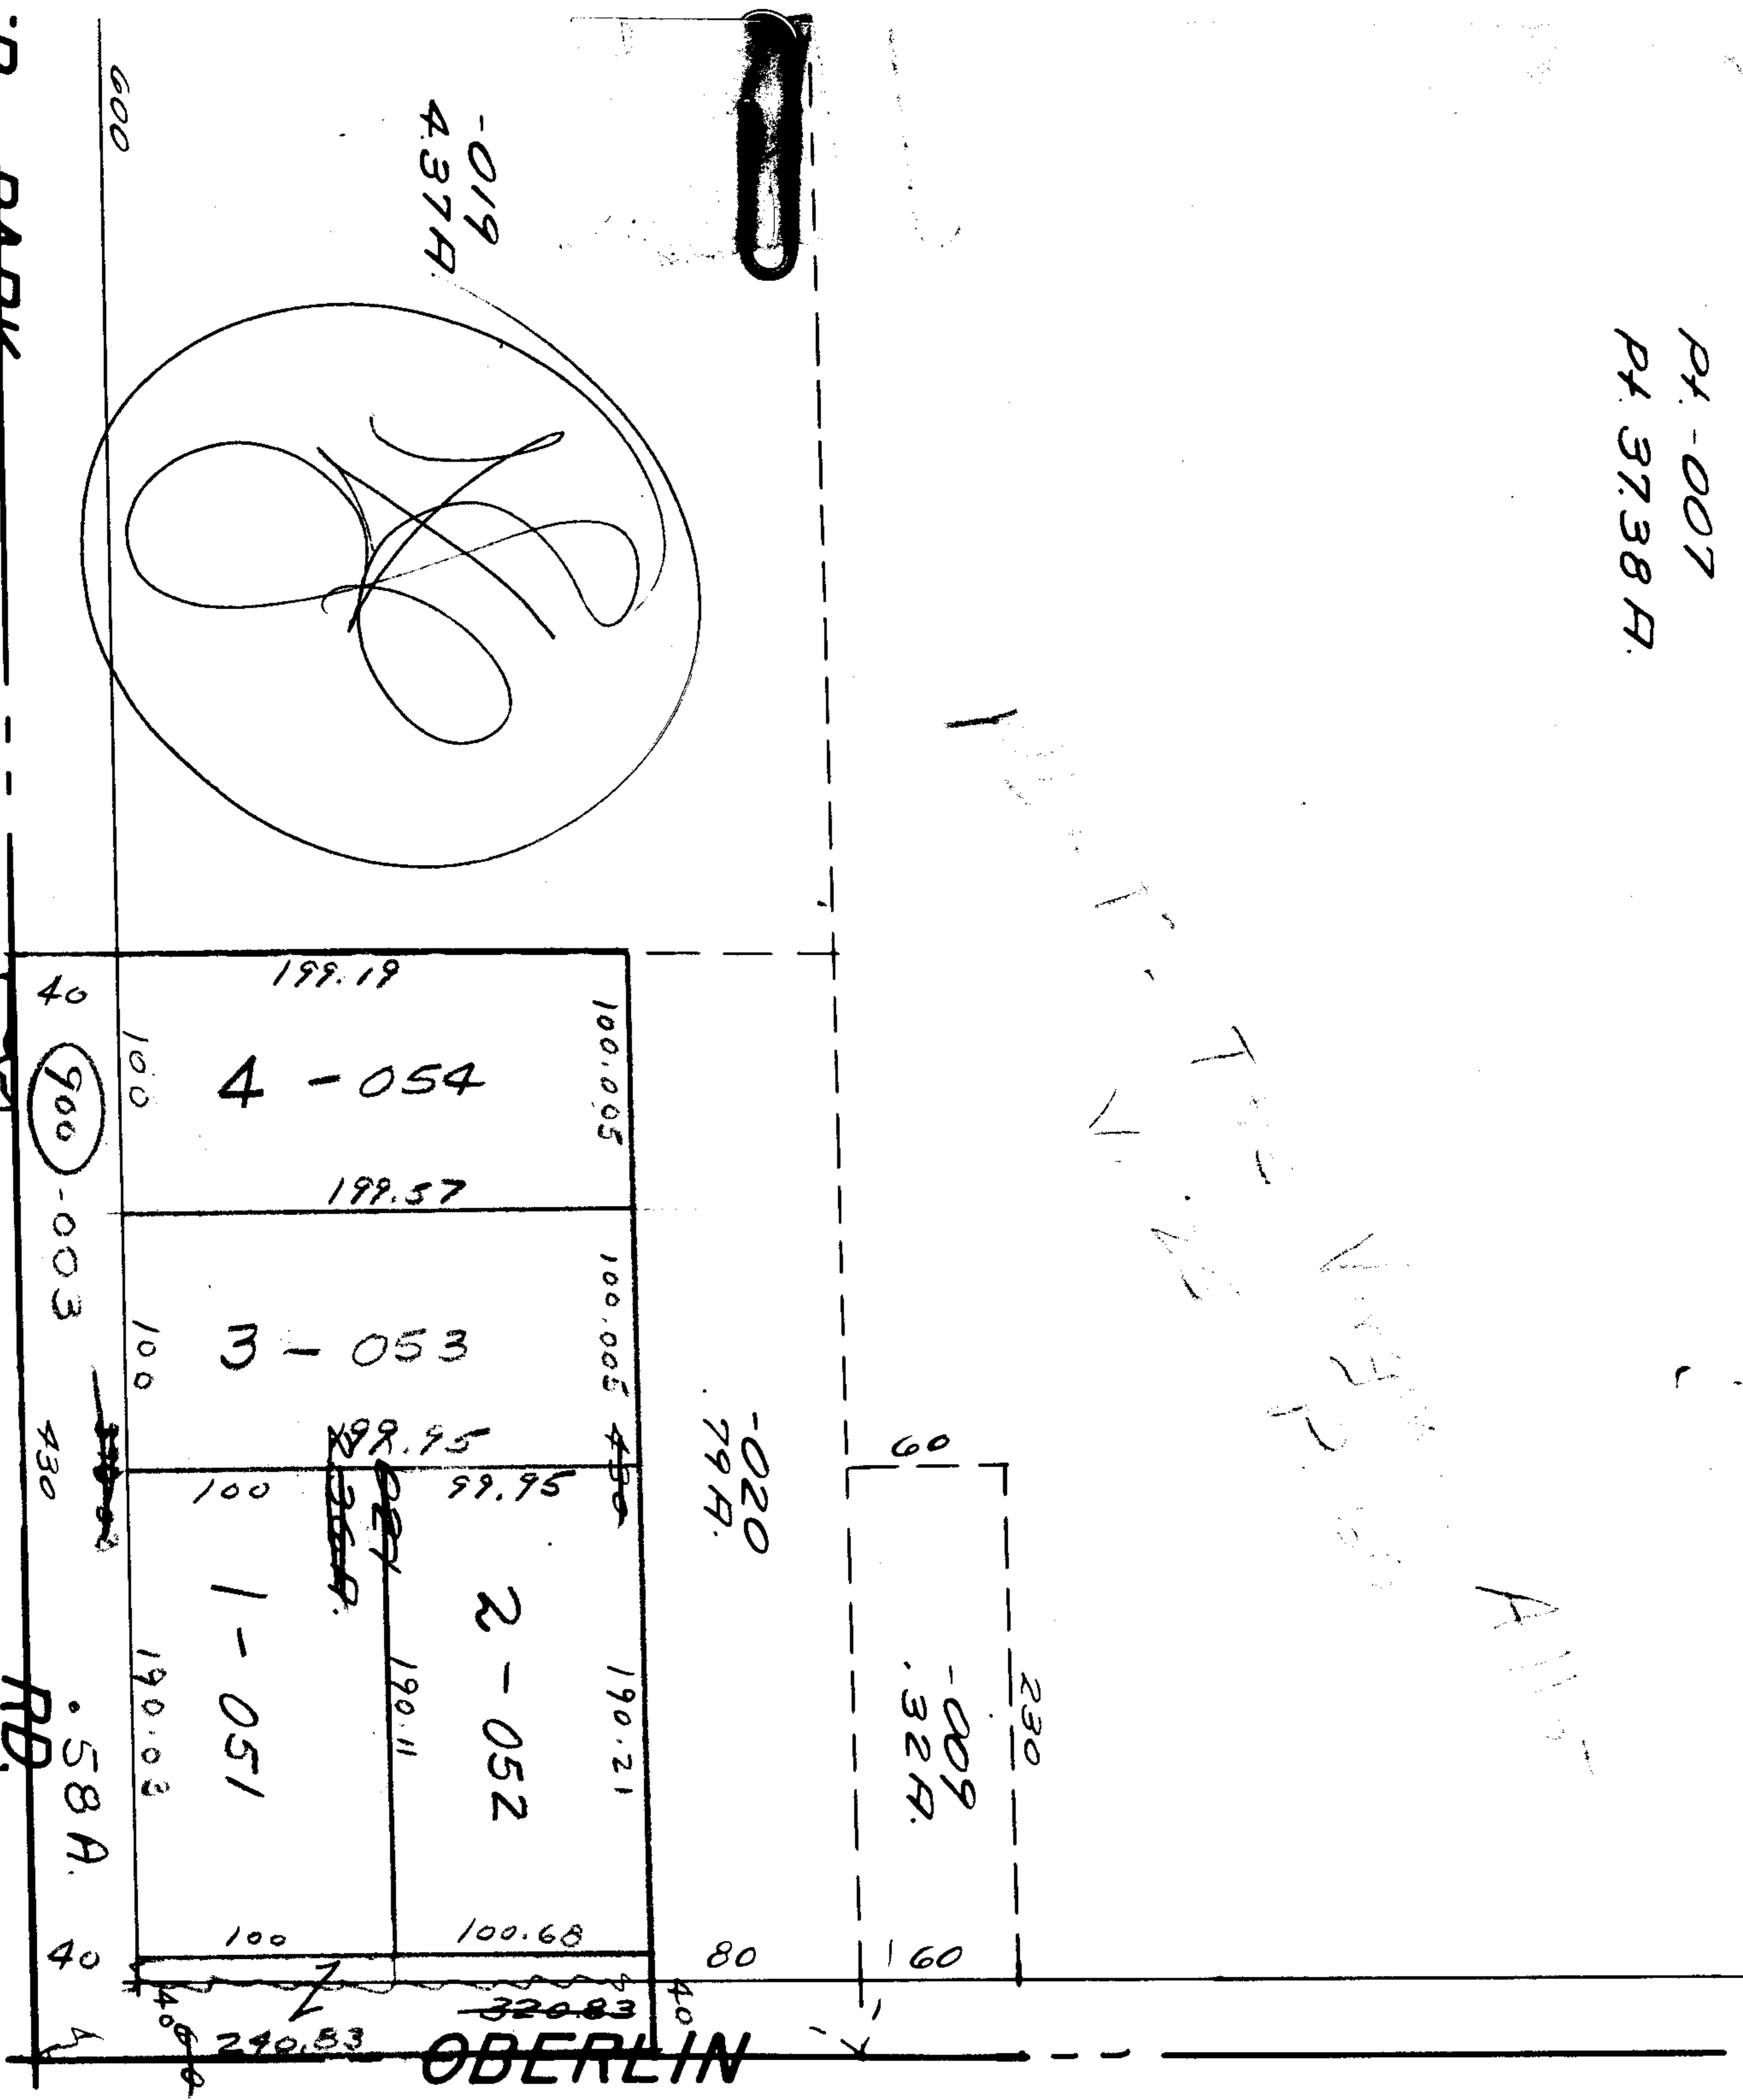

PARK
SEE 5-00-061-A

