

80.75

154.85

RD.

SEE 17-07-007-B
Pt. 1.32 A.

-005
.66 A.

209.27

209.27

148.5

148.5

RD.

154.85


-006
.50 A.

148.5

148.5

148.5

Church location
Congregational Church

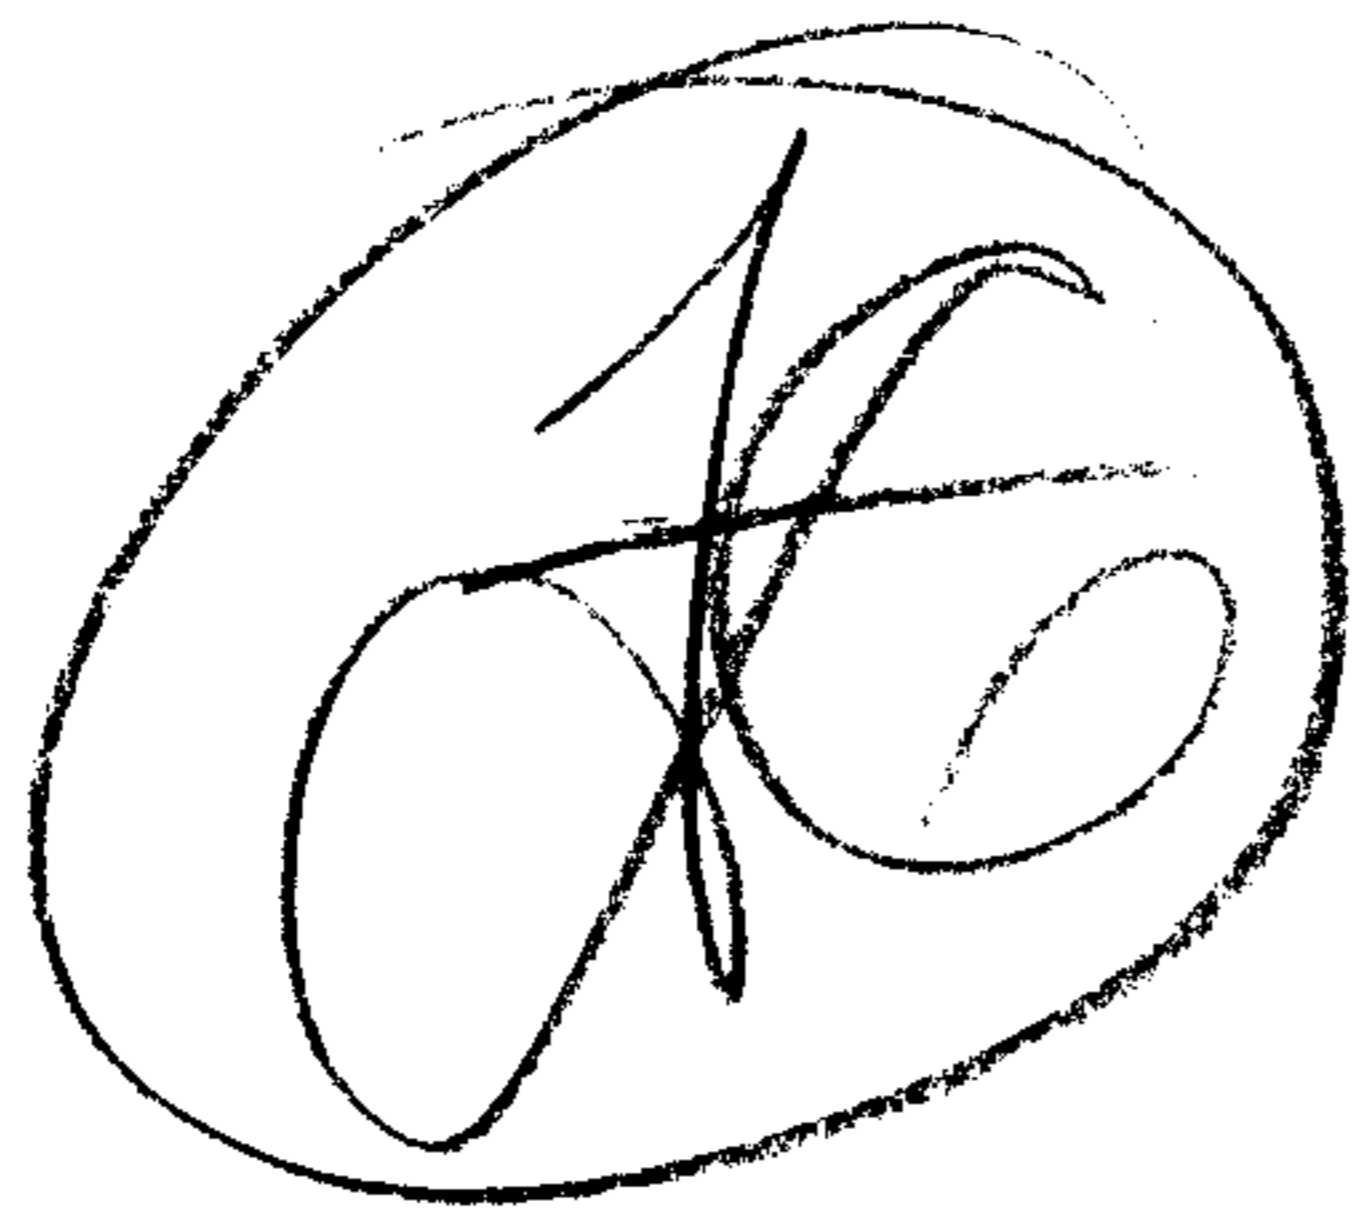

-007
1.09 A.

298.50

-024
1.11 A.



298.50

-021
.79 A.

298.50

-023
~~022~~
1.57 A.
~~1.68~~
2.22.9 A

298.50

-010
1.09 A.

2594

AUG 21 1969

APPROVED
LORAIN CO.
MAP DEPT.
DATE 4/8/69
By 17-07-017-A
BY P.W. Kelling

Transfer
7-31-69



17-07-016-A

