
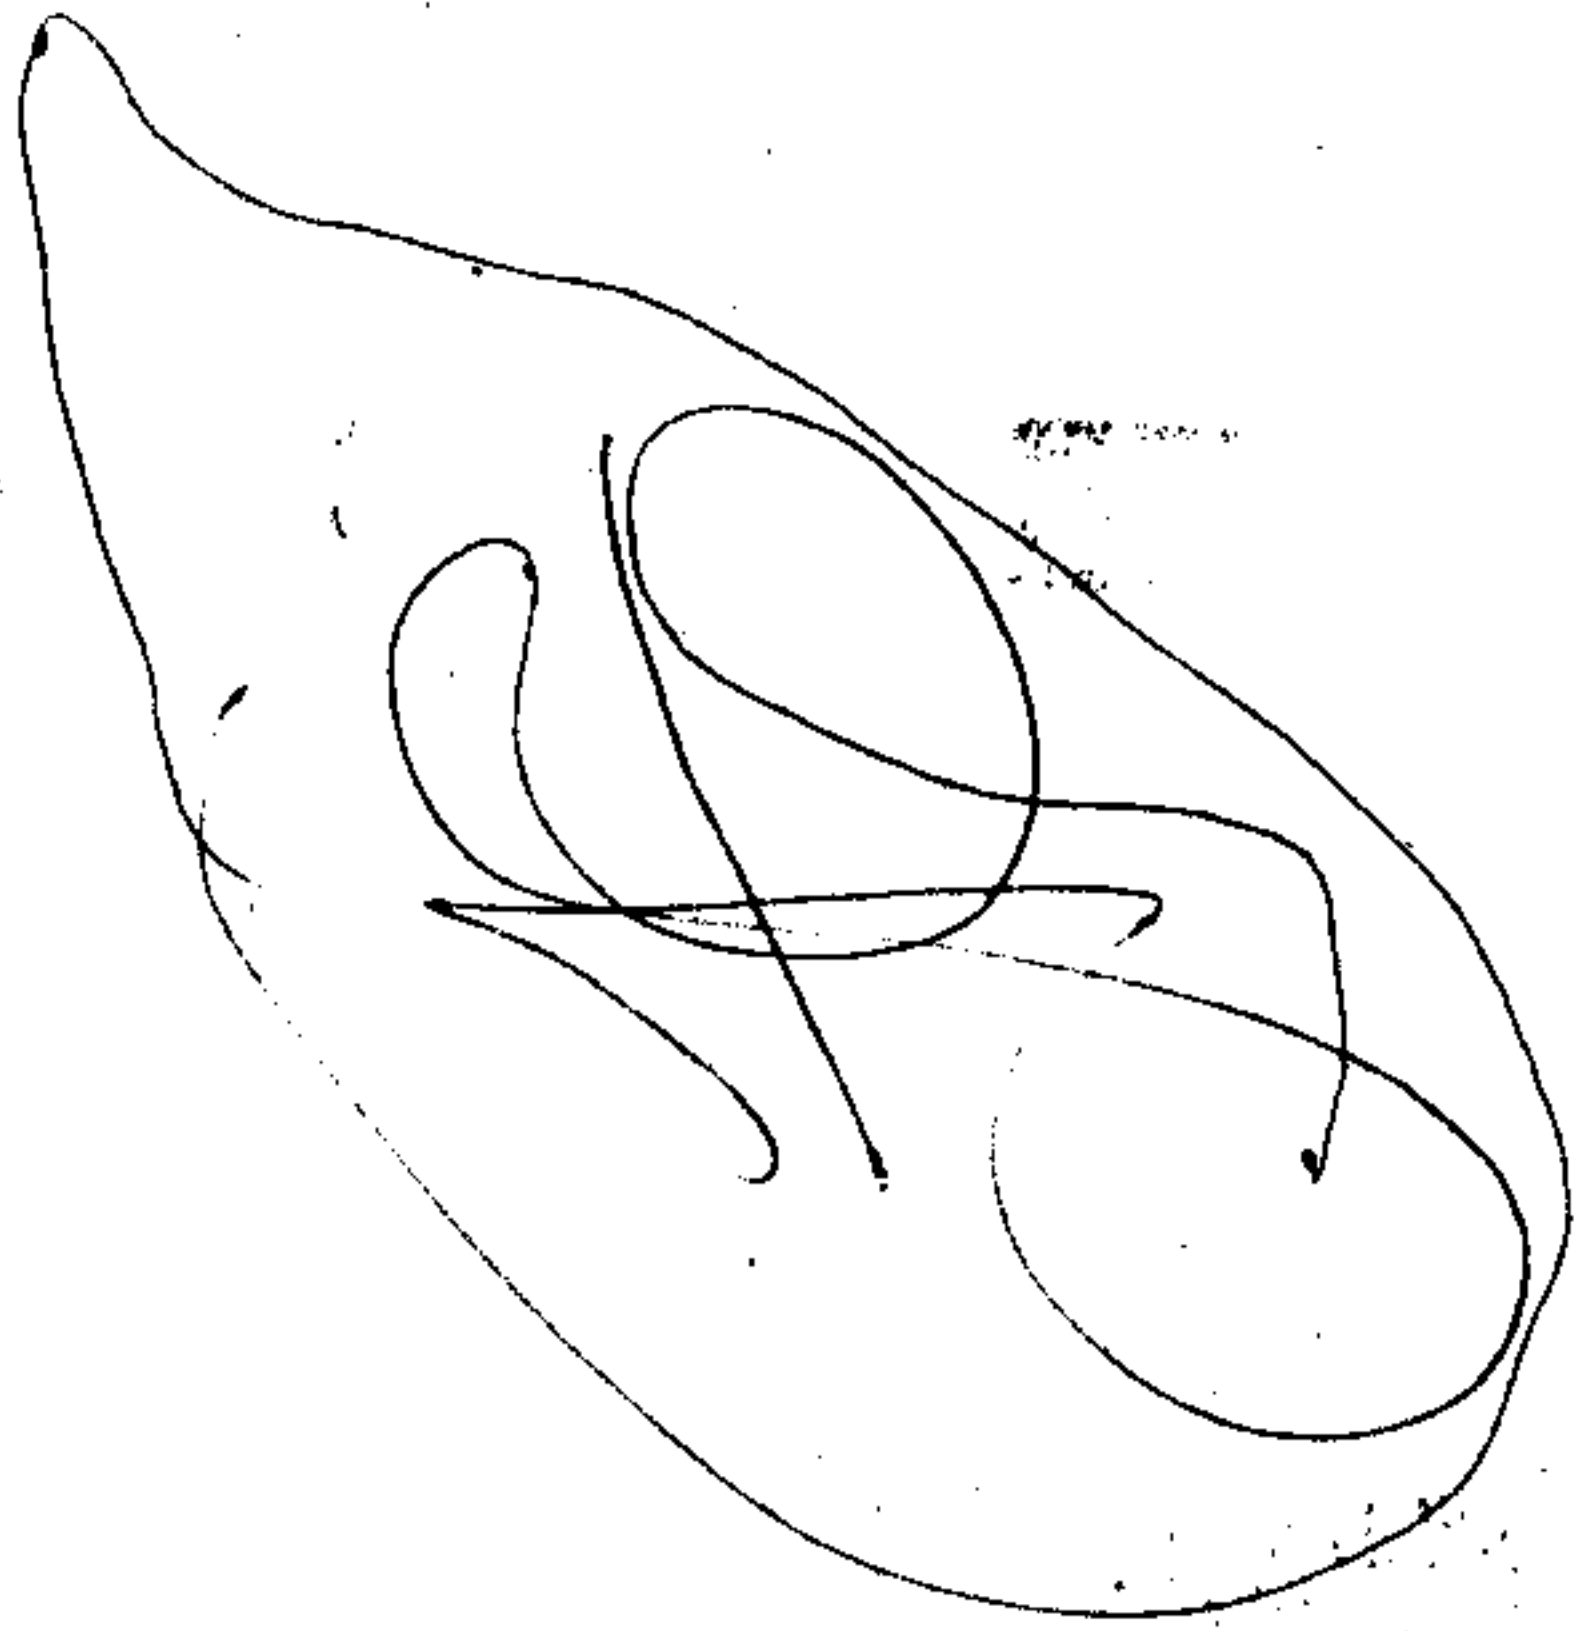


SEE 10-E

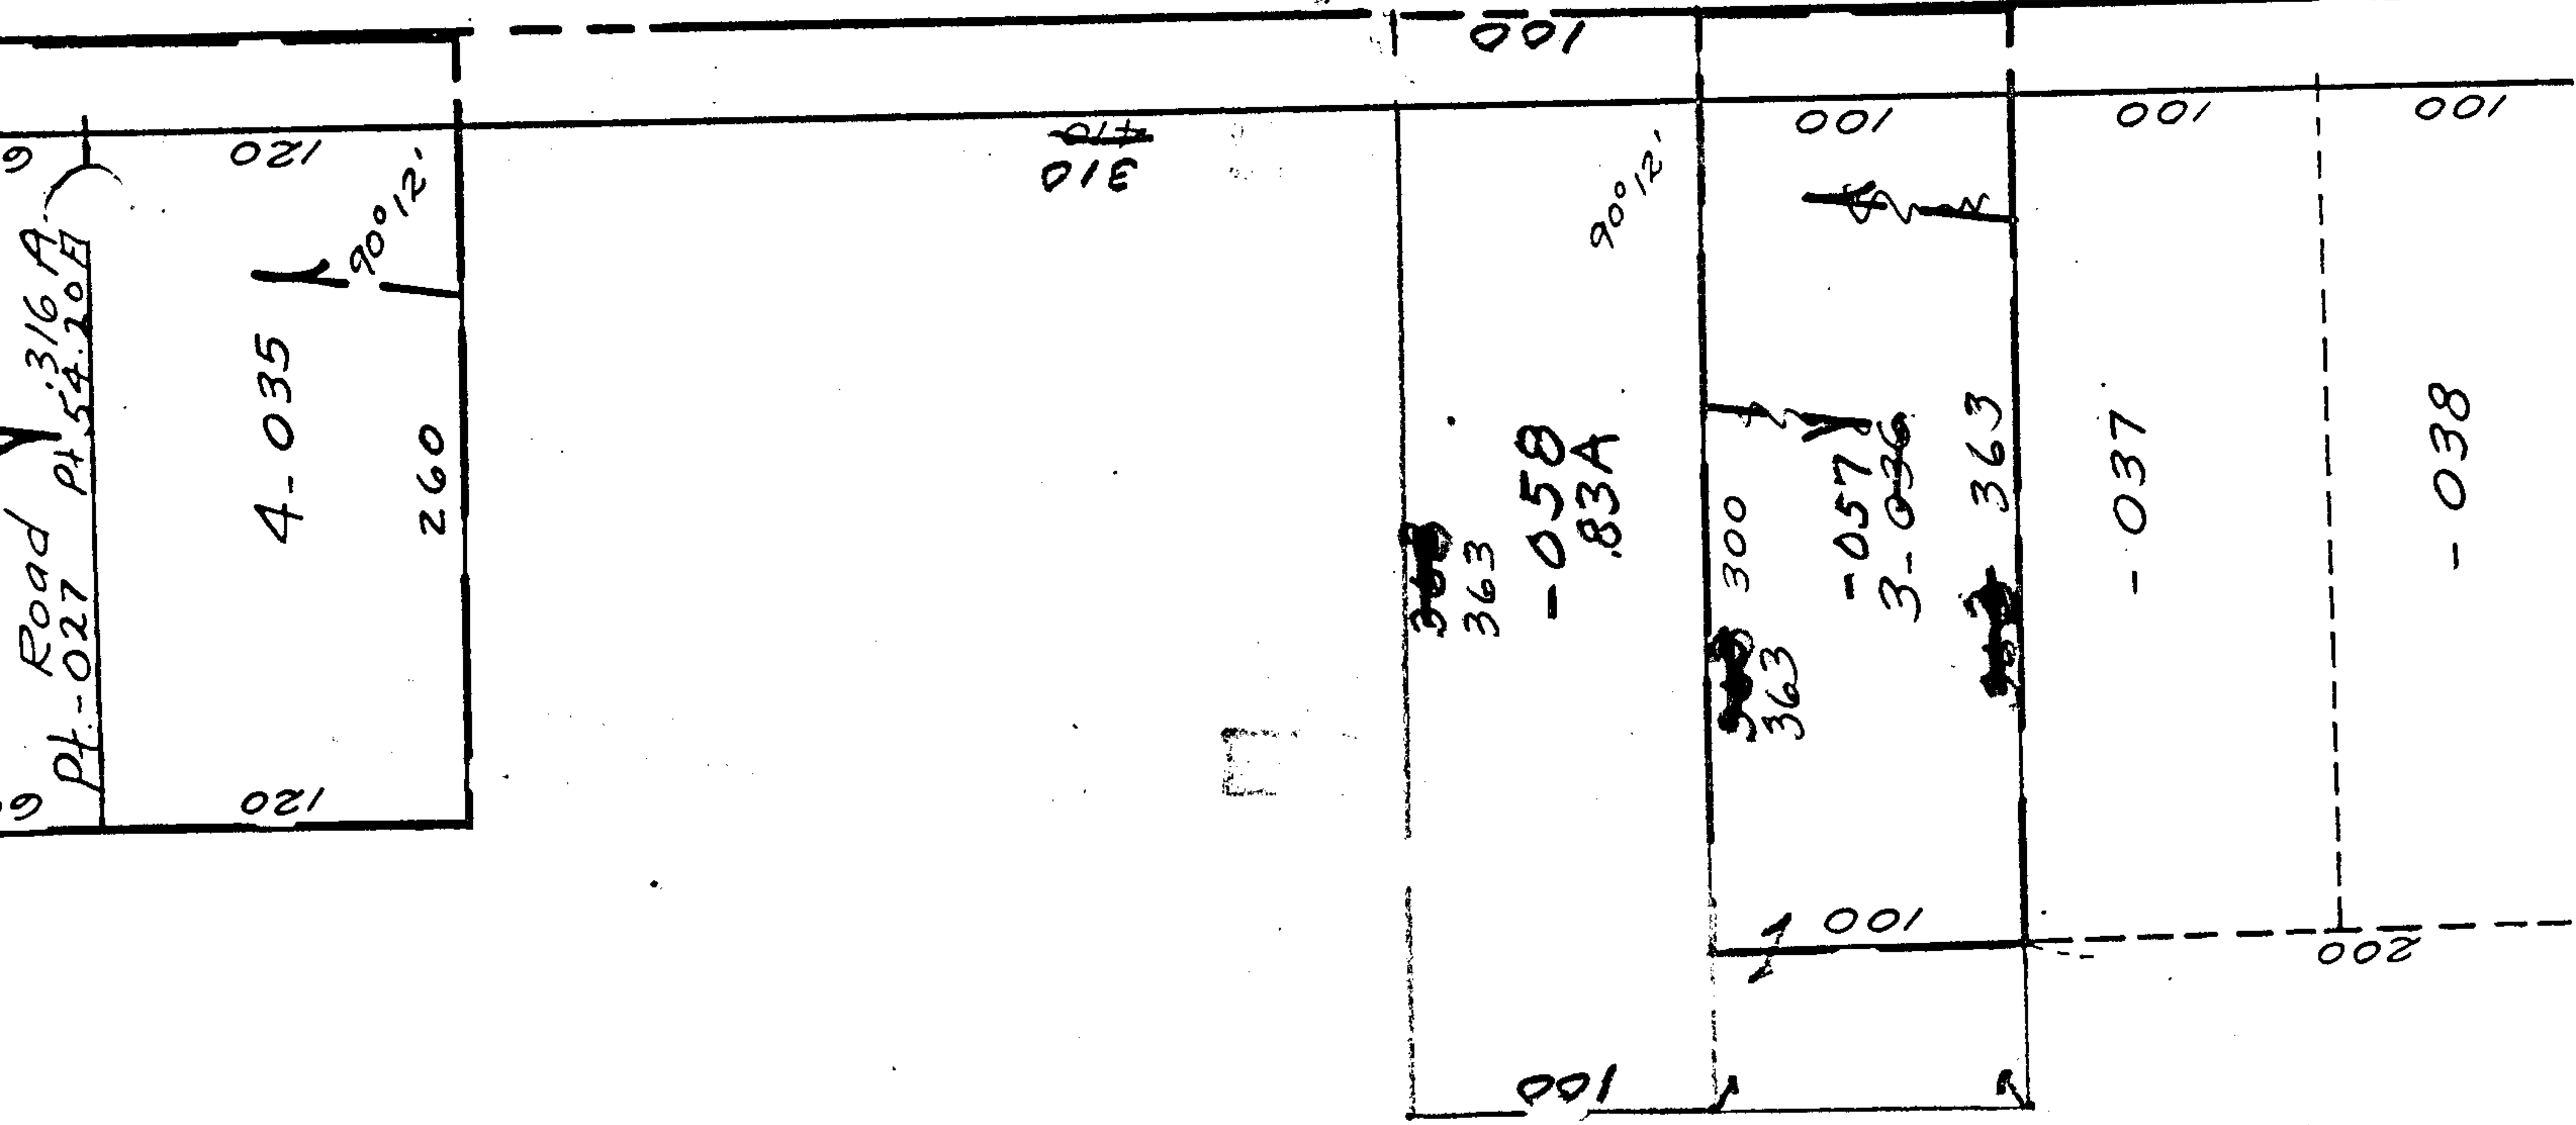

MAY 20 1969

APPROVED
LORAIN CO.
MAP DEPT.
DATE 4/9/69
BY R. Kelly

-059
-027
54-20A
53.23

2596

98-507
205-86