
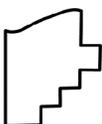


PARENT PARCEL: ADD TO DUPLICATE PER ROAD RECORD RESOLUTION V. 4 PG. 412

CHILD PARCEL: 01-00-012-900-001 & 01-00-021-900-001

STARTING POINT:

26-05657-A

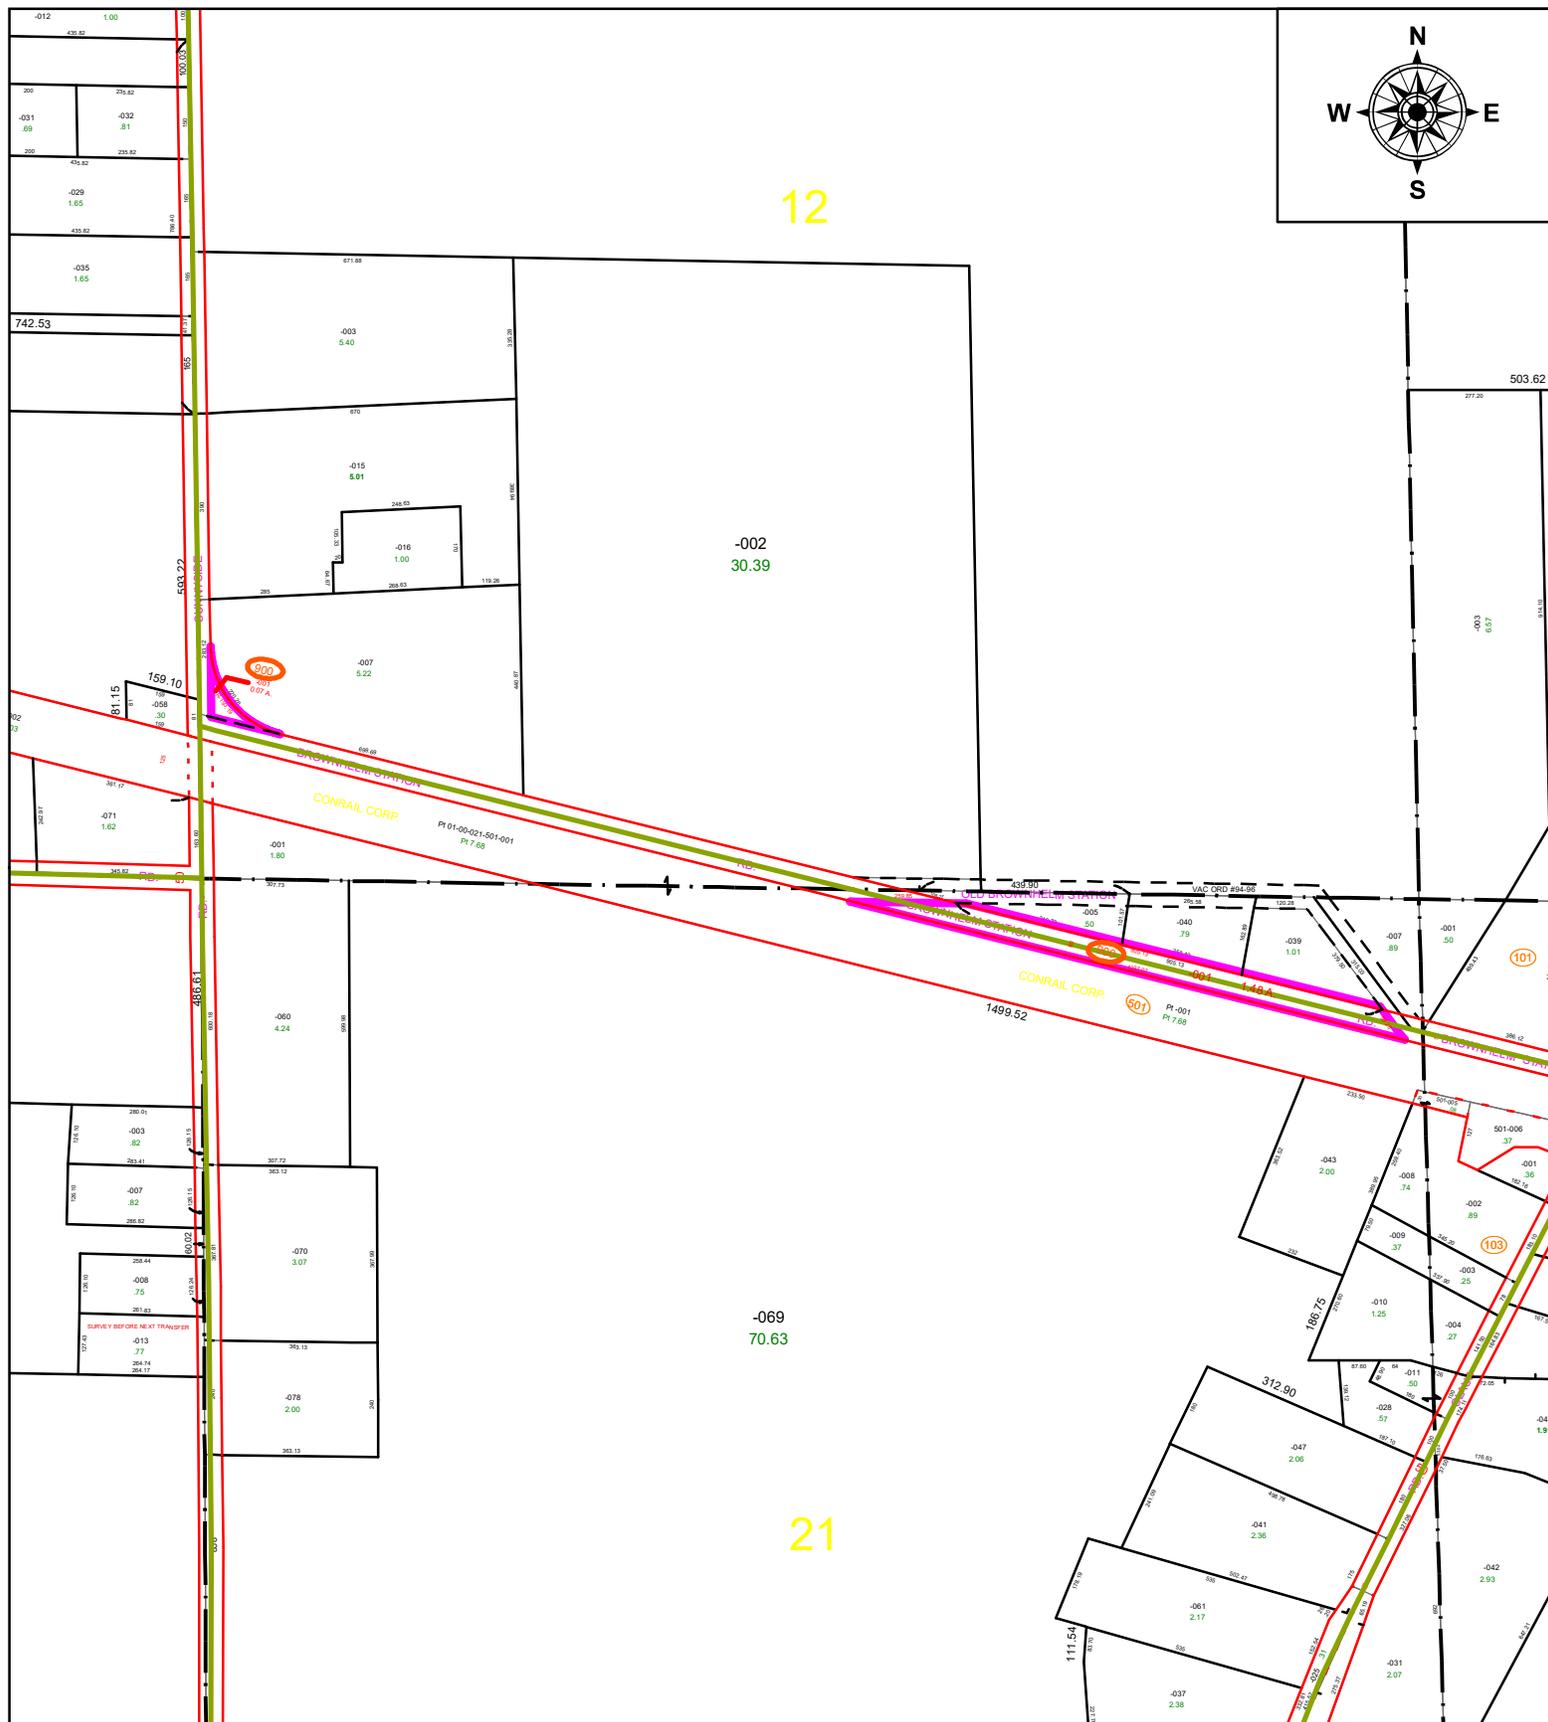

SPLITS/DEEDS PROCESSED
 LORAIN COUNTY TAX MAP DEPARTMENT
 226 MIDDLE AVE. ELYRIA, OH

SURVEYED BY: NA
 CLOSURE: NA
 MAP PAGE(S): 01-00-012 & -021
 APPROVED BY: TJS DATE: 1/23/2026
 SCALE: 1" = 400' PRIOR INSTRUMENT: V. 4 PG. 412