

WEBSTER

2631

APPROVED
LORAIN CO.
MAP DEPT.


DATE 7/17/69

BY 19-06-118-A

BY

SEE 19-06-118-A

SEE 19-06-118-B
8.1-30-86

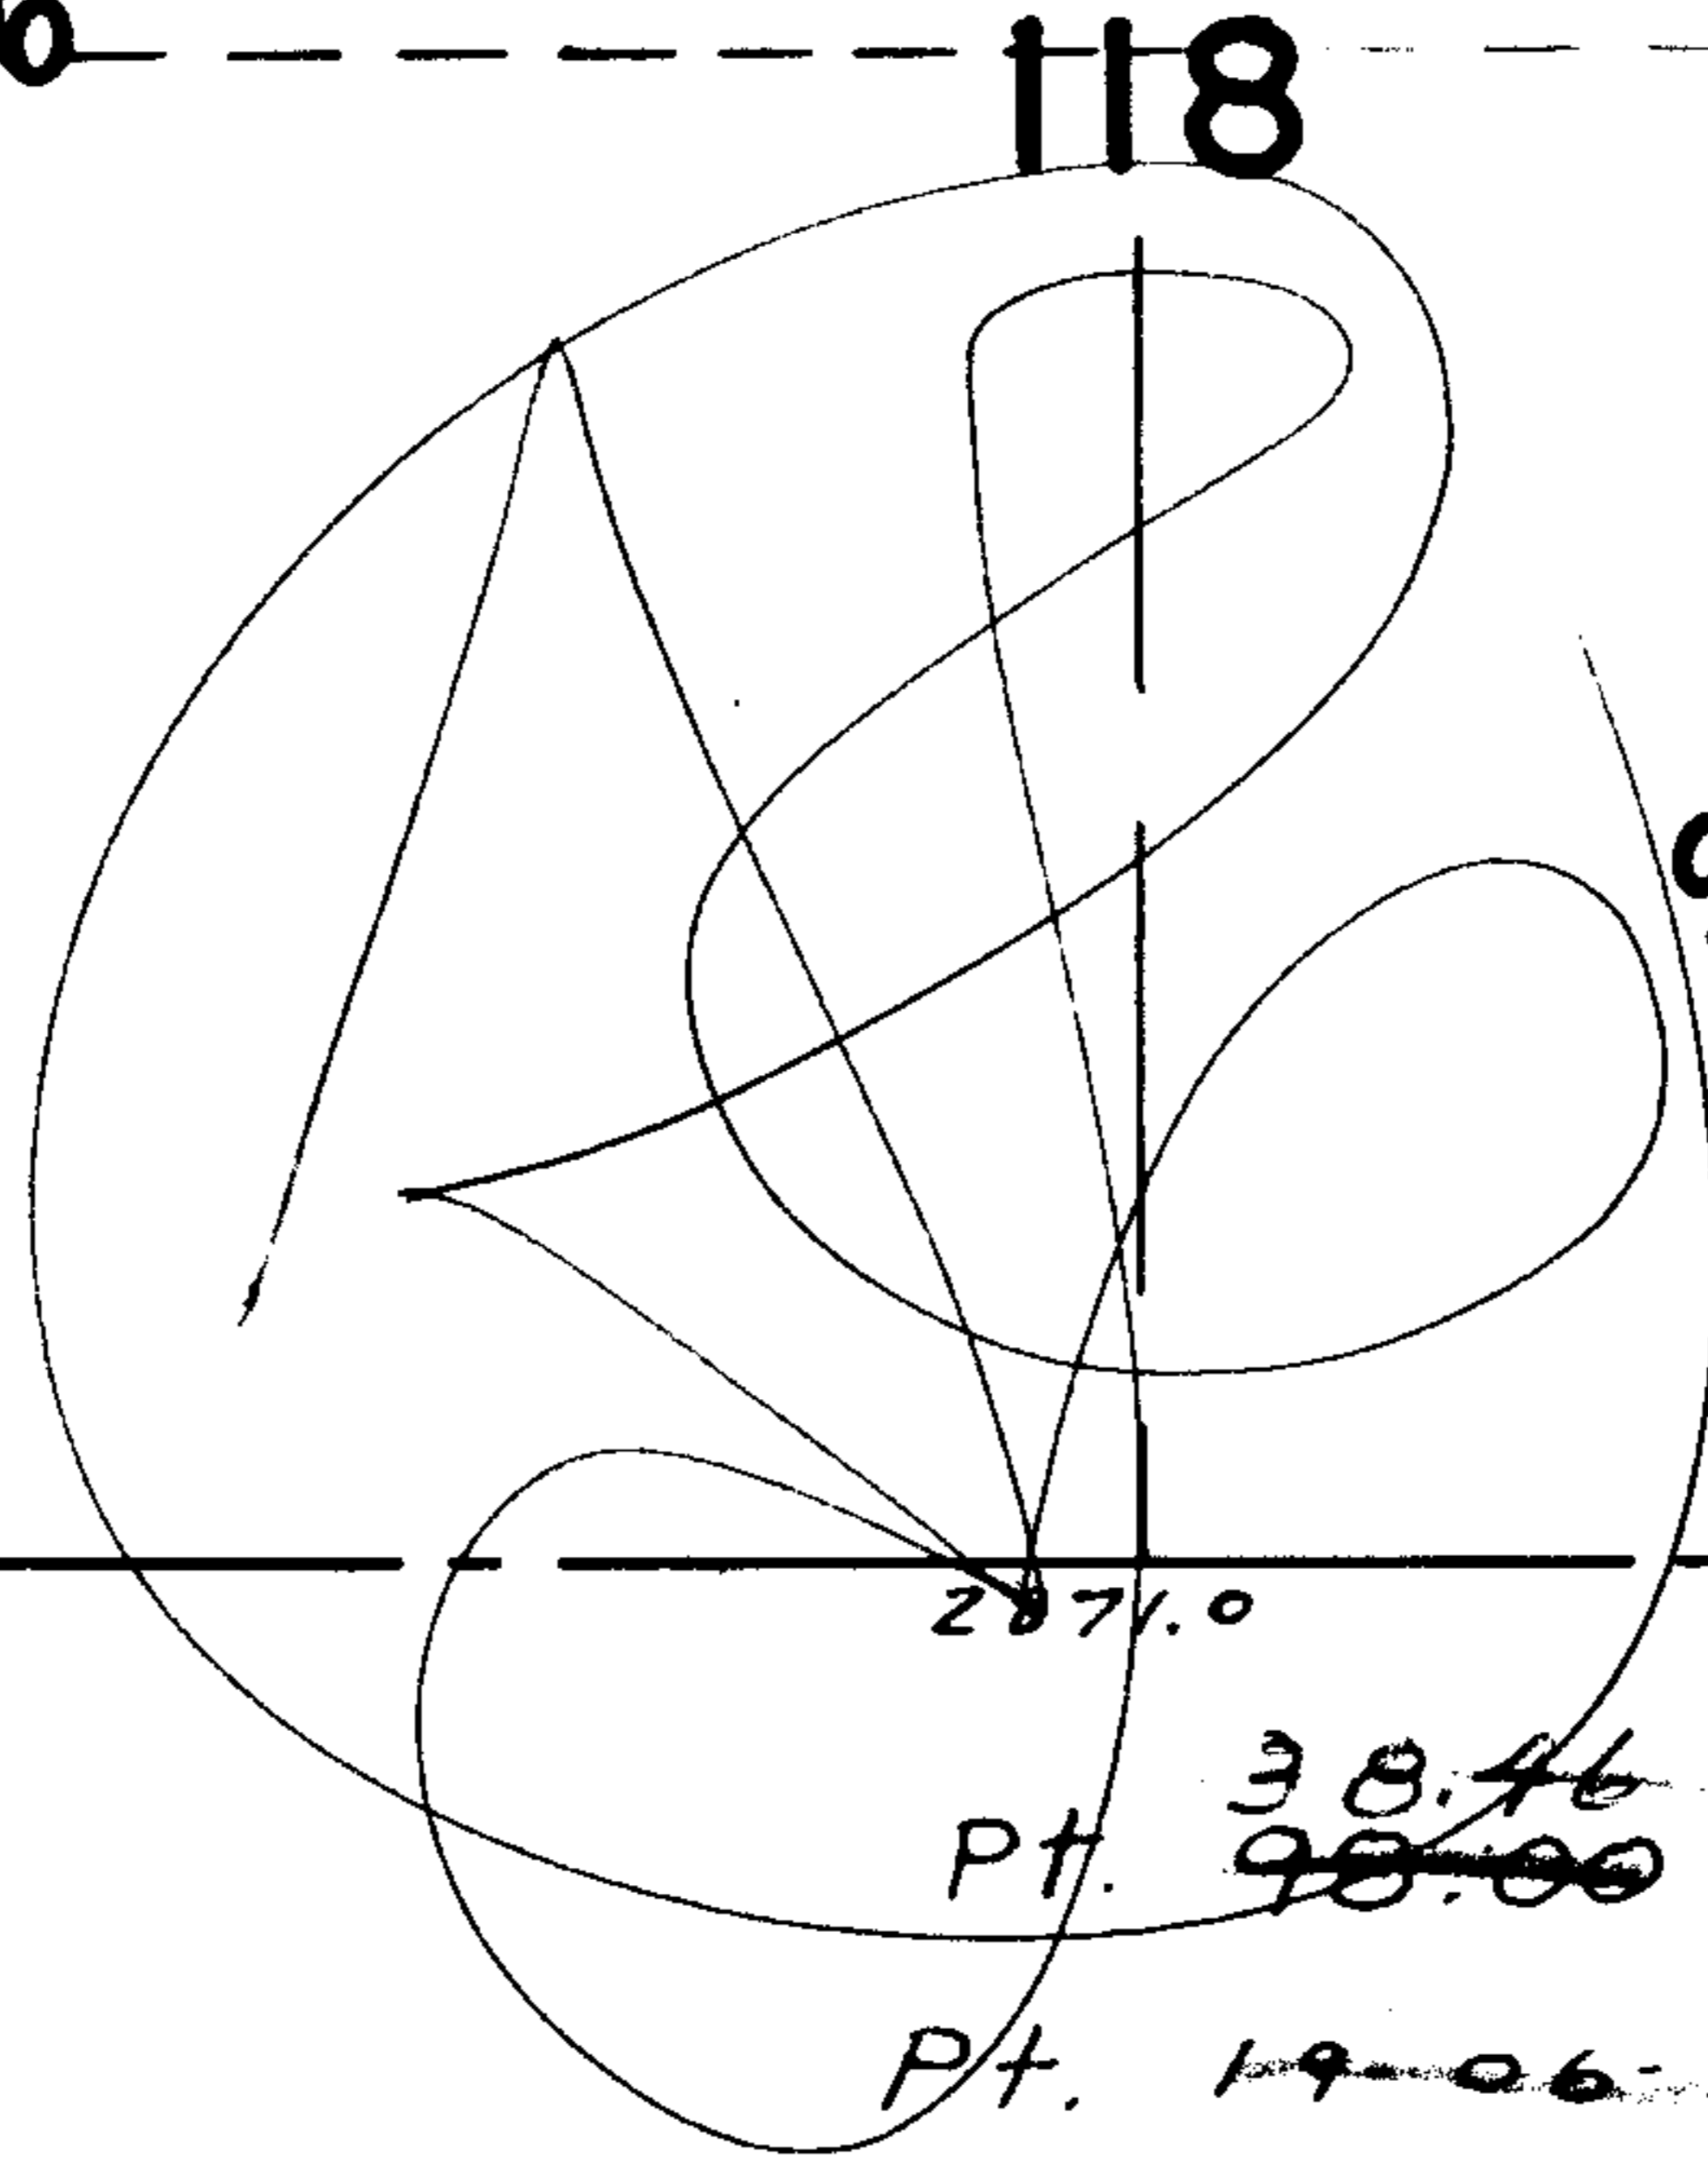

118

2871.0


Pt. 38.46
98.00 A

Pt. 35.46
19-06-118-000-023

2885.06

Lot 117 -012 57.18 A.
97.92 total

117

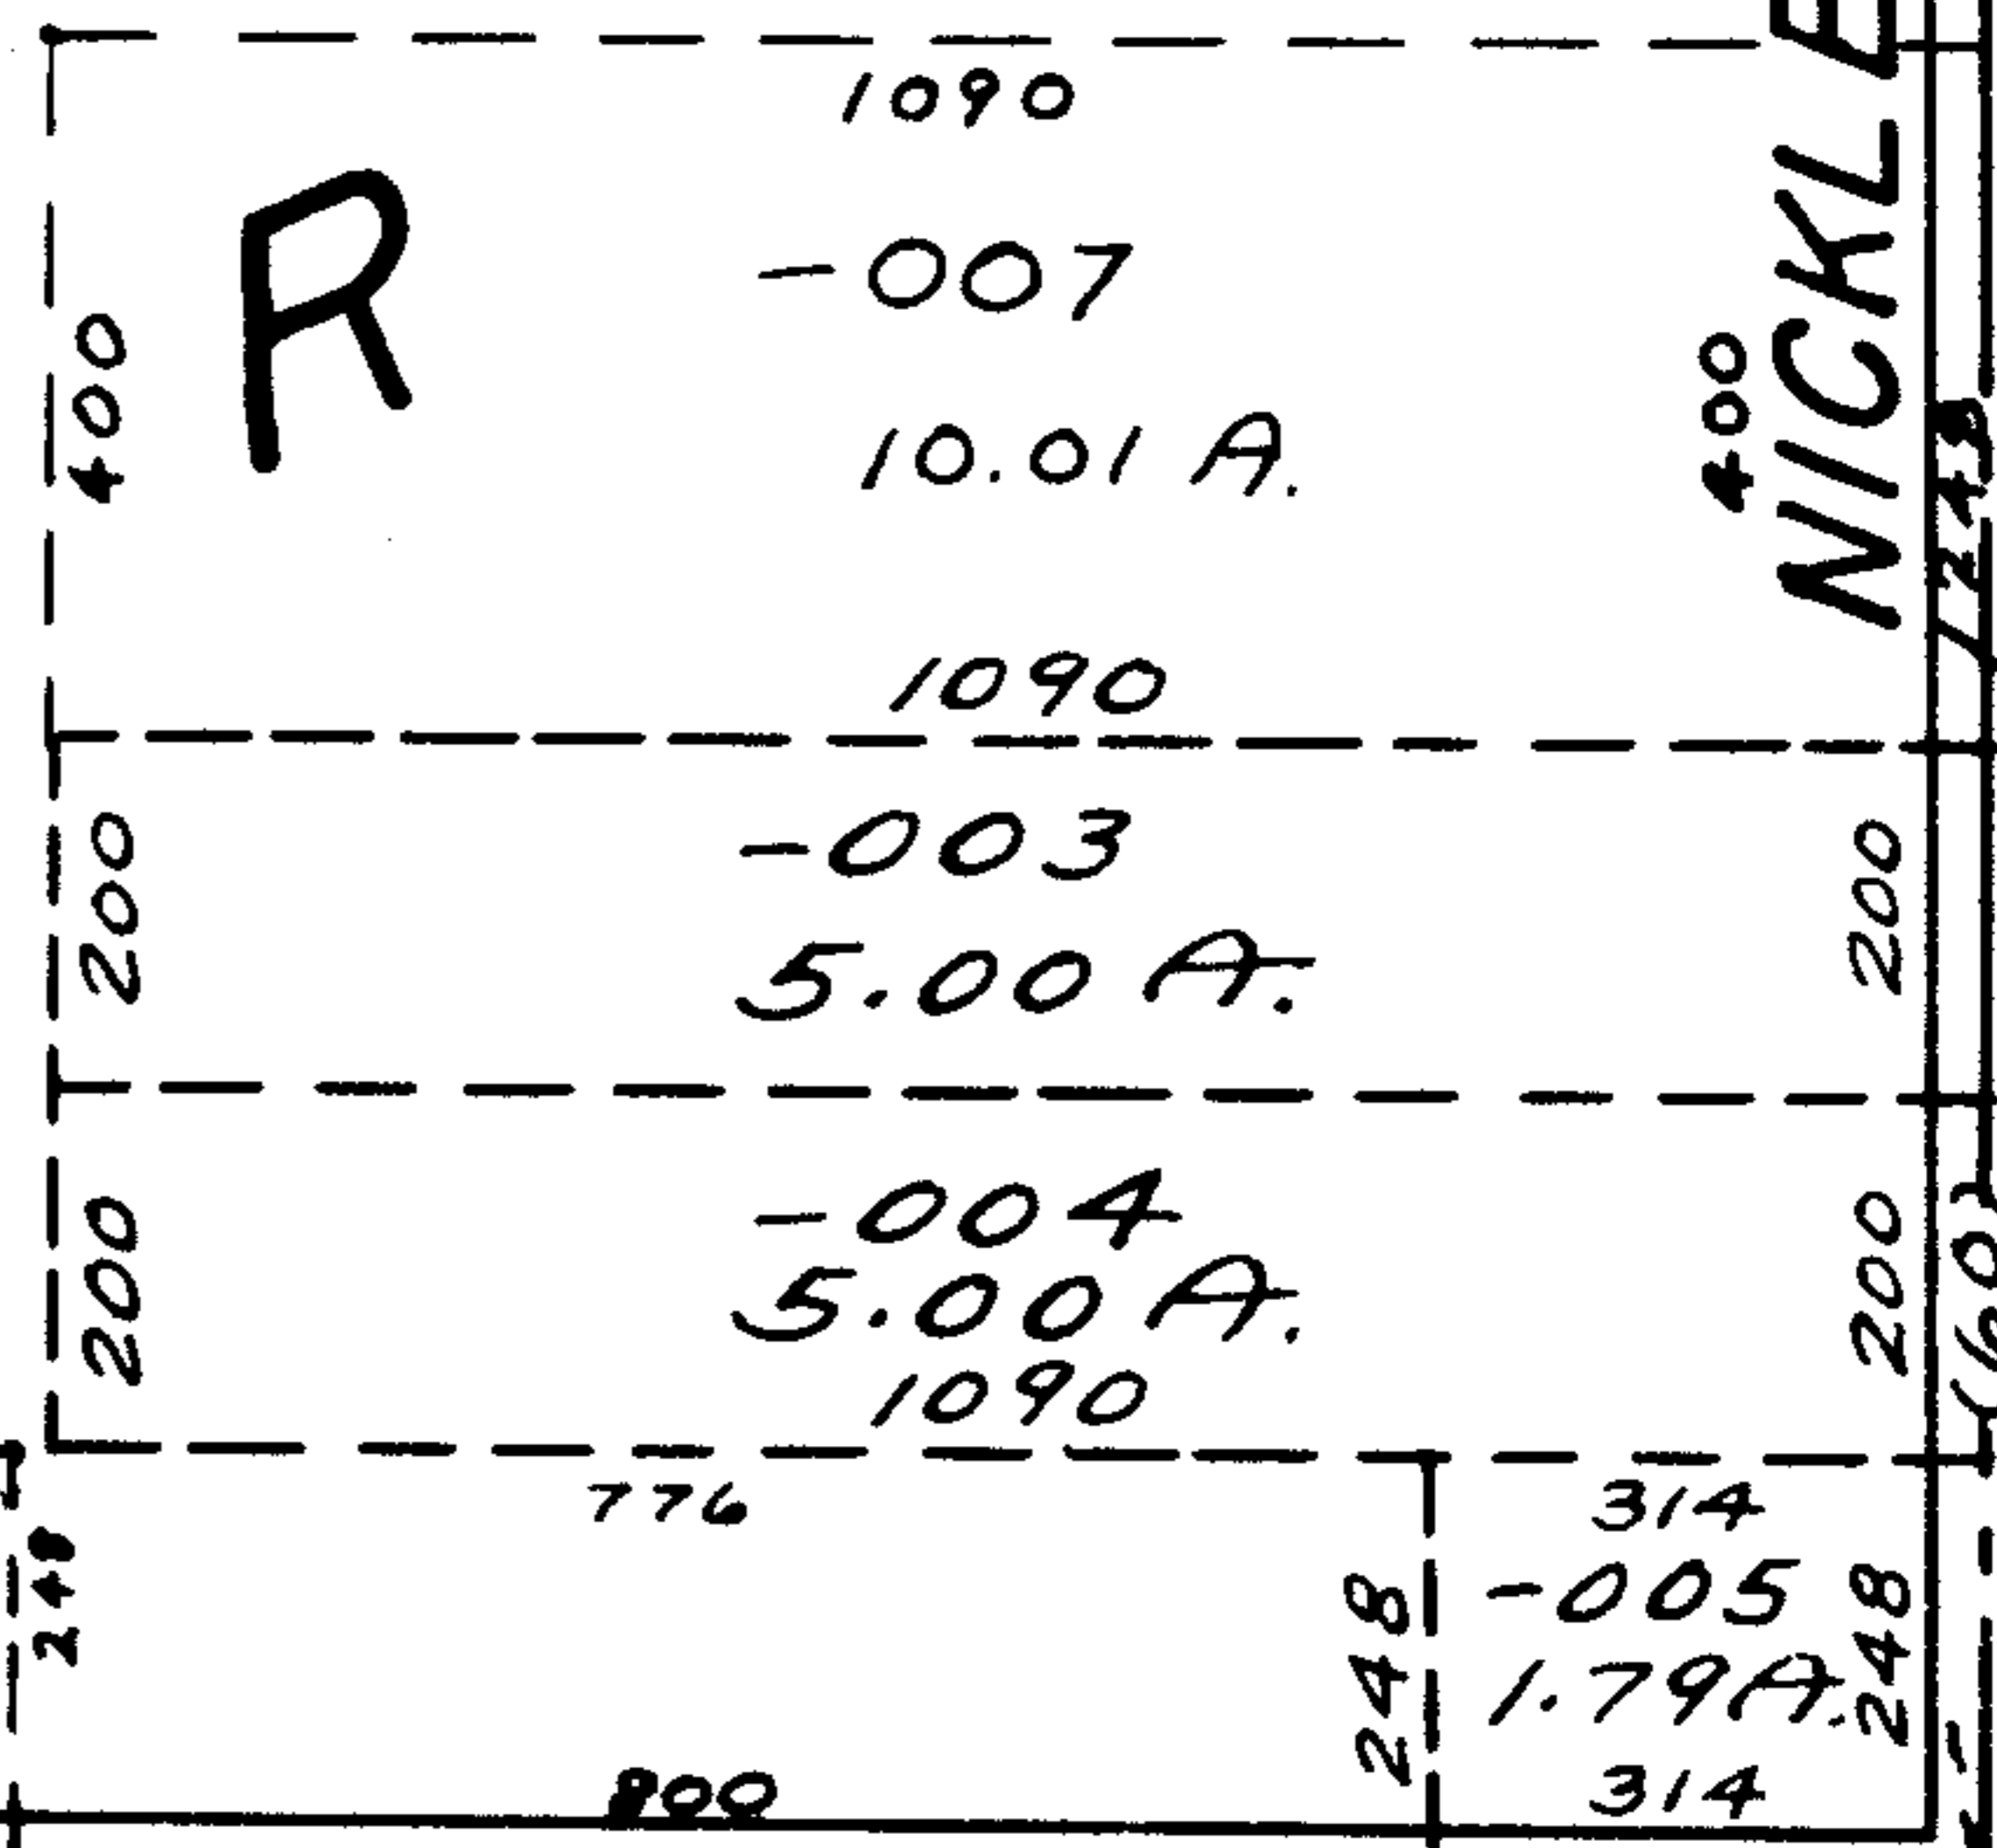

A

R

T

DIAGONAL
NICKLE PLATE

PECK WADSWORTH

RD. (60)

RD. (60)

265
-002
1.51 A
248

200
-000
200

200
-000
200

248
314
-005
1.79 A
248
314

1122

709.67

563.23

563.23

1584.93

200

248

200

200

(60)