

89°54'

247.70

173.86

836.20

2313.70

1860.0

1212.9

9.011

Pt. - 028

101

~~030~~  
778A 032  
1388Ac

~~005~~  
655A.

-006  
694.

-007  
.53A.  
08.00

-012  
80A.

-011  
.67A.  
350

-013  
1.00A.

-014  
1.00A.

-029  
2.00 R.

-010  
.75A.  
290.86

-009  
.50A.  
174.33

-020  
1.00A.

-021  
.50A.

-002P  
V R

105

-008  
264.5

-031  
454C

29 HEDGEROW

31 M.ROW

34-001 K R

28-007

26-009

35-019

37-01


38-01

35 HEDGEROW

37 HEDGEROW

38 PARK

APPROVED  
LORAIN CO.  
MAP DEPT.  
DATE 4-25-69  
7-00-025A  
BY LW Hall

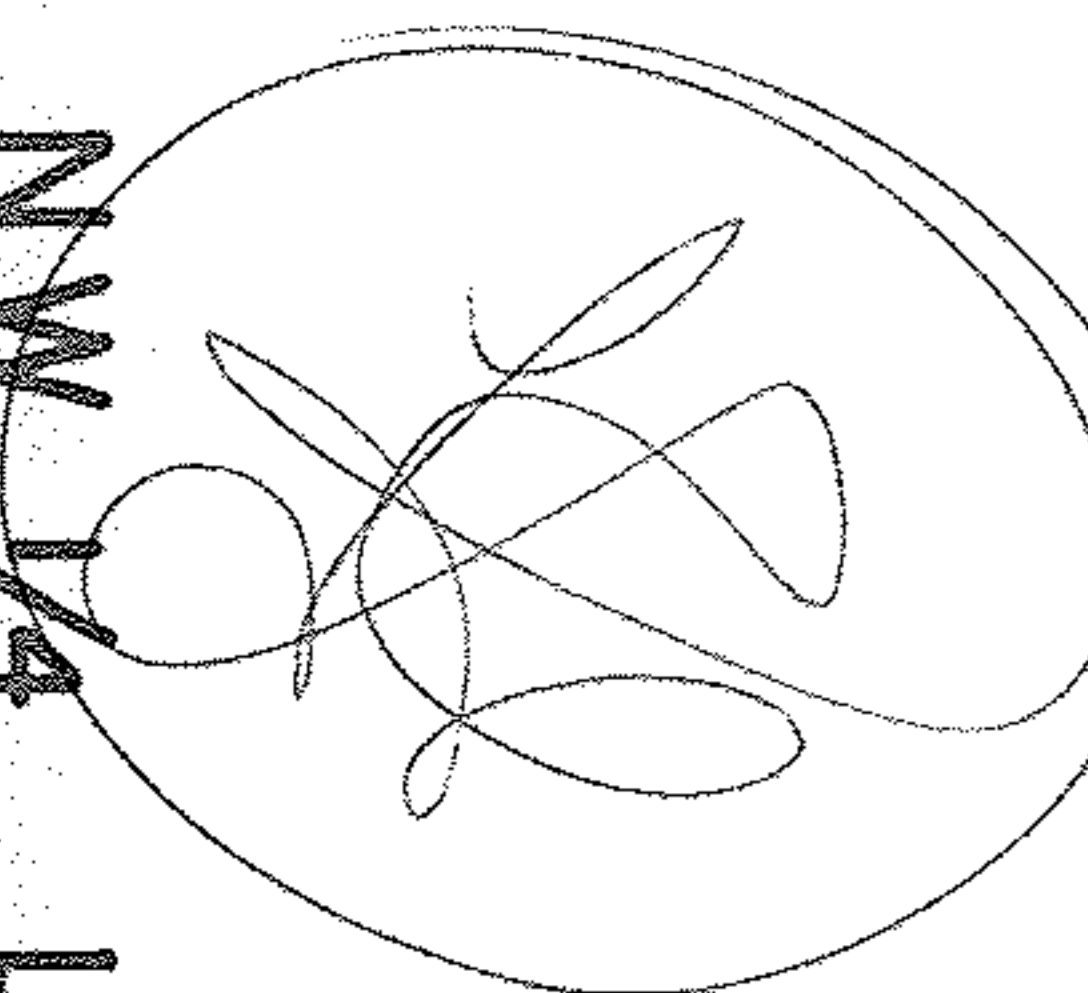

NW 1/4 LOT 25

7-00-025-C

W.P.