

2442.85
 435.60

 2007.25

2650
 -011 362.74
 4499A .90A
 362.74

807.27
 -003 3.63A
 -004 10.29A
 -005 1.29A
 -007 13.20A

APPROVED
 LORAIN CO.
 MAP DEPT.
 DATE 4/26/69
 BY R. H. Kelling

16

-008 40.66A
 -001 4.91A

-009 21.00A

-001 25.00A

2442.85
 2007.25
 -002 18.70A
 17.70
 2443.83

Hatch Kiss
 AE & Nancy

-003 18.80A

-004 12.50A

6


-005 25.00A

-006 12.08A

(504) -001 4.01A

-007 6.43A
 2115.36
 2119.2

-010 19.97A

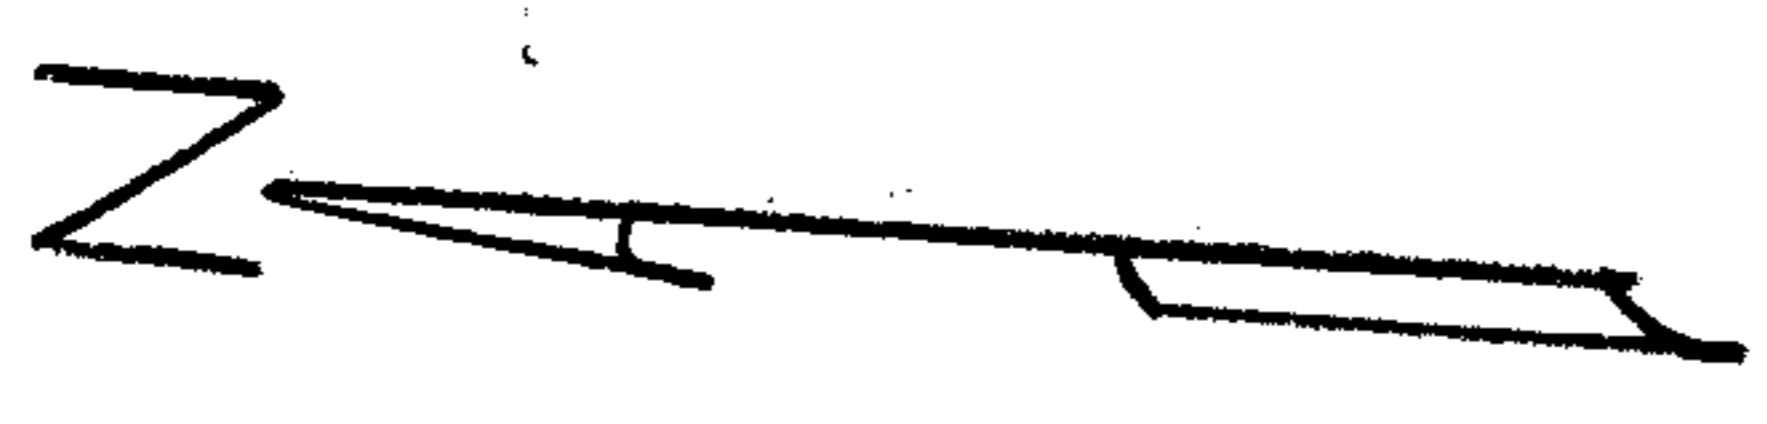

R. R.
 500

SEE 3-L

Swanner H, F & Helen F
 To Hatch Kiss AF 100 Remdr 17.70 Swanner H, F & Helen
 4-28-69

448.86

334.87
 435.60

334.88

225.89

444.55

150.28

1912.8

1422.40

126.70

