

33.02  
85  
118.02



970.86

200

200

-019  
188A.

918.39

-017  
6.03A.

-007  
3.12A.

450

~~-028~~  
~~188A~~  
-029  
188A.

1339.92



~~008~~

~~3.04A~~

1339.11

395.25

APPROVED  
LORAIN CO.  
MAP DEPT.  
DATE 4-29-69  
BY [Signature]  
#2656

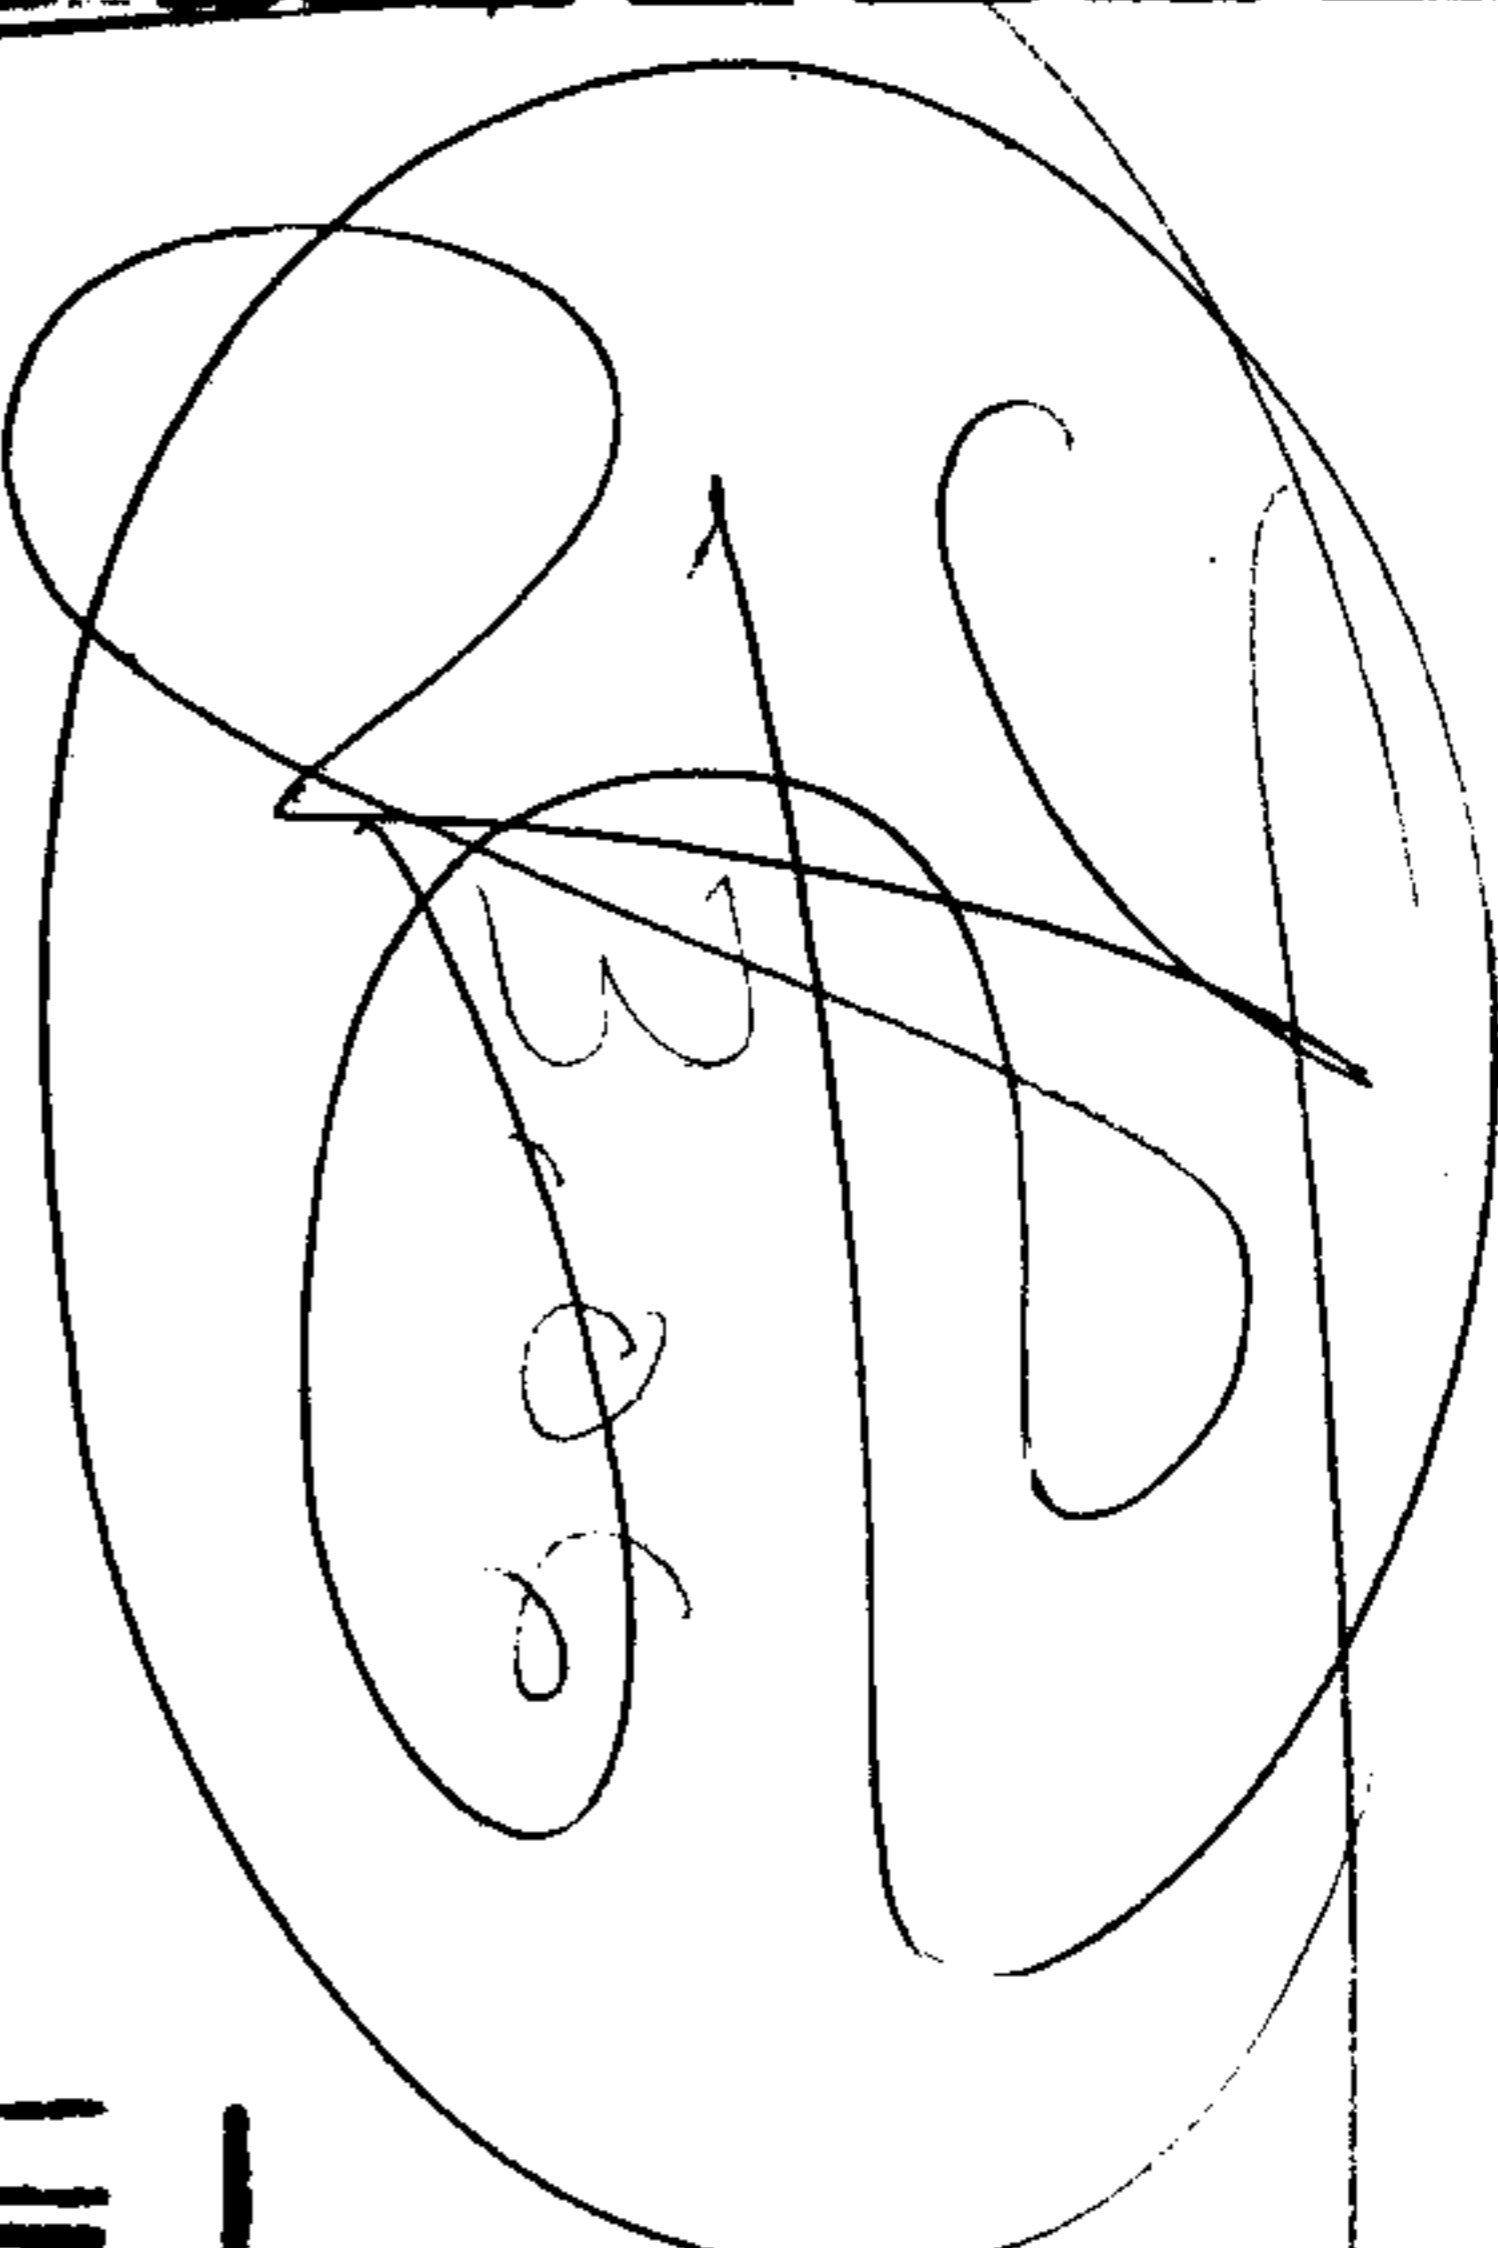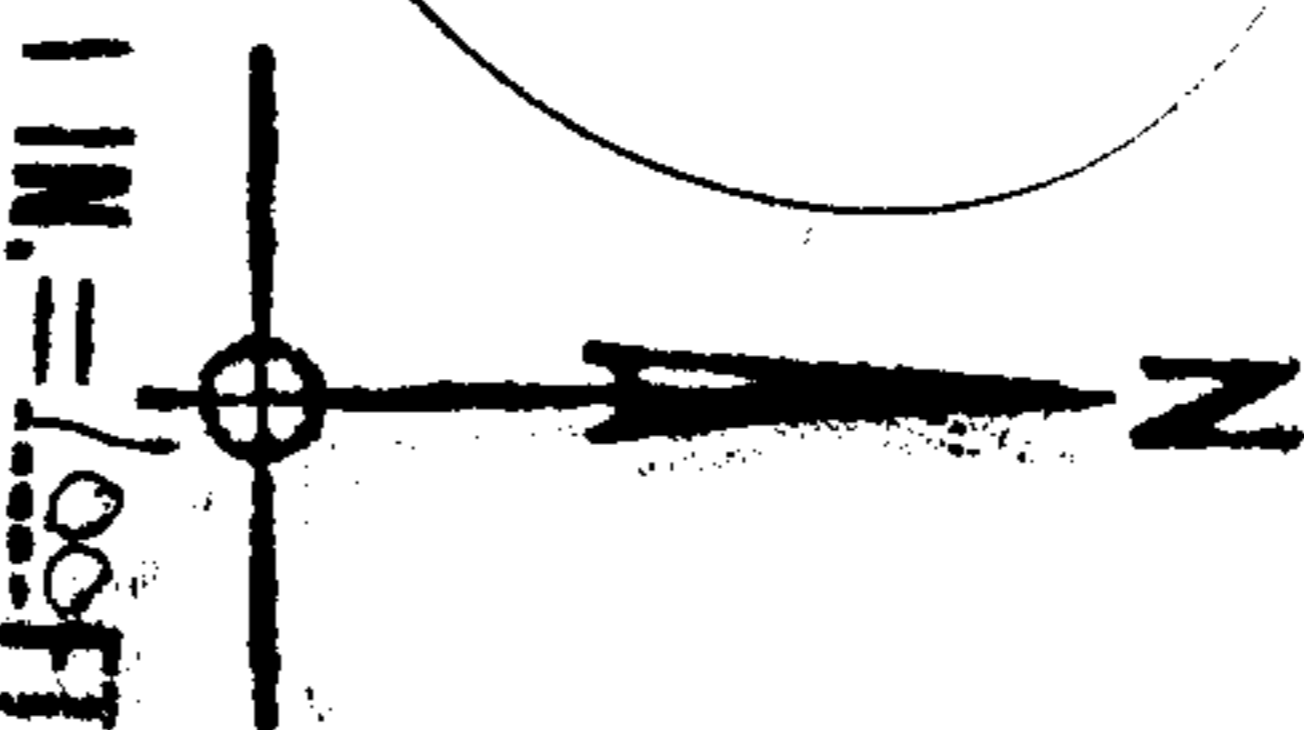

30.375      75 X 405  
4950      4 25 X 388  
1575      2 92 X 75  
36,000 .847

MAY 20 1969

3-00-002A  
1339

592.10

