

APPROVED
 LORAIN CO.
 MAP DEPT.
 DATE 5/8/67
 BY R. J. Kelly


~~15-85 A~~
 15.39

2679

MAY 21 1969

Corrected

2050.80

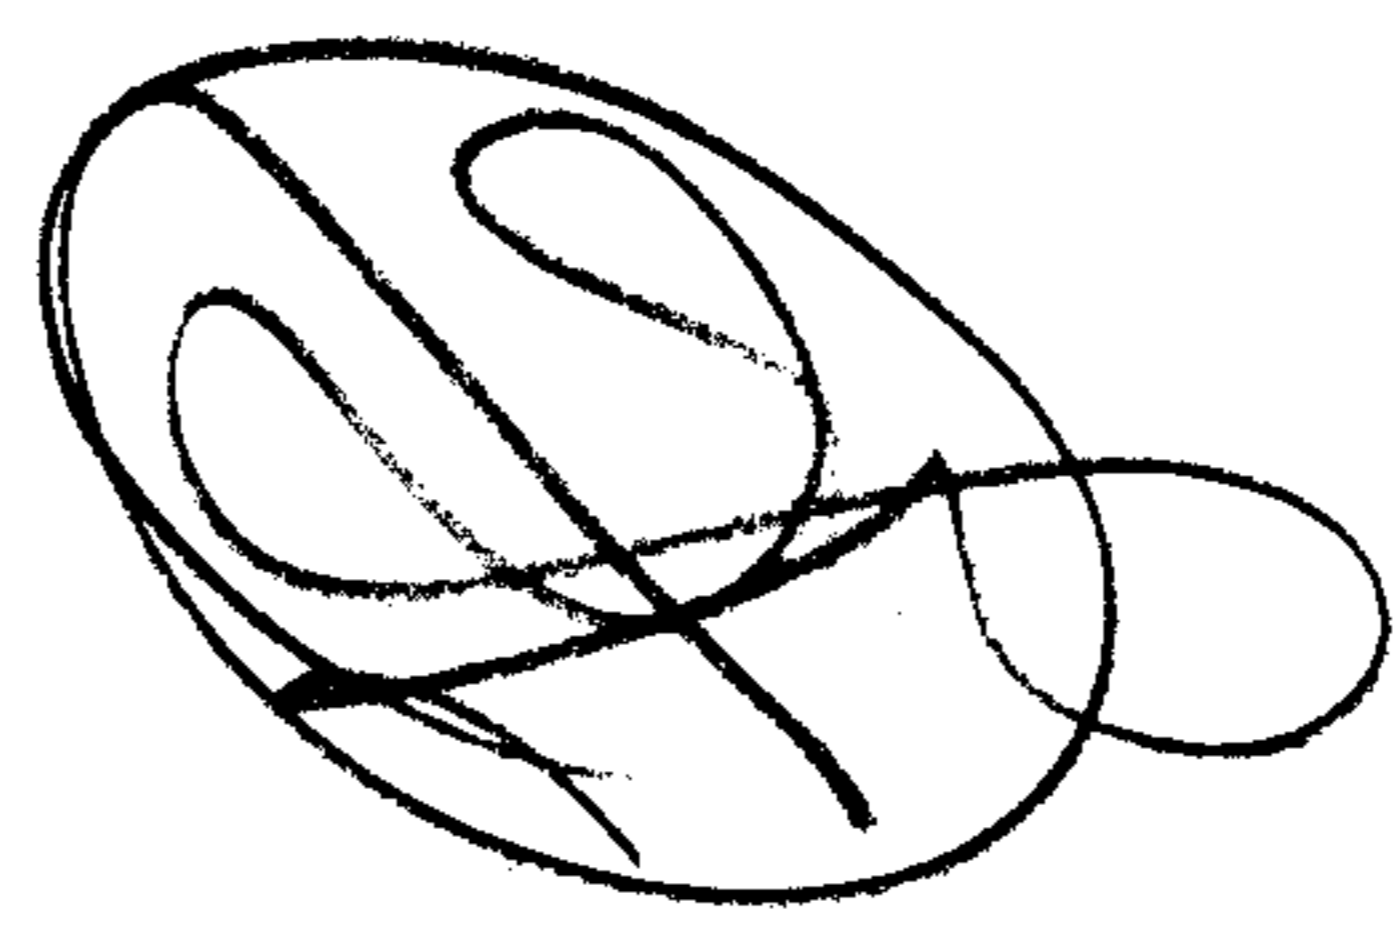

-025
 1.71H.

500

75

145

70

272

500

936.25

186.9

142.70

121

121

249.30

121

60

117.24

-060

.49A

180

-059
 .37A

180

-064
 42A

150

522.63

19

75.92

62.76

41.26

90

-003

-004

-005

105

14-007

75.92

936.25

7-008

75.92

75.92

-009

79.89

5-010

141.9

274
 291

-055
 .50A

-056
 .50A

291

-014
 .90A

.41A