


Tax Map P9  
09-00-080A

- 023  
~~- 021~~  
49.82 AC  
48.49

JUN 3 1969

APPROVED  
LORAIN CO.  
MAP DEPT.  
DATE 5-12-69  
9-00-080 A+B  
BY LWHall

2690  
JUN 3 1969

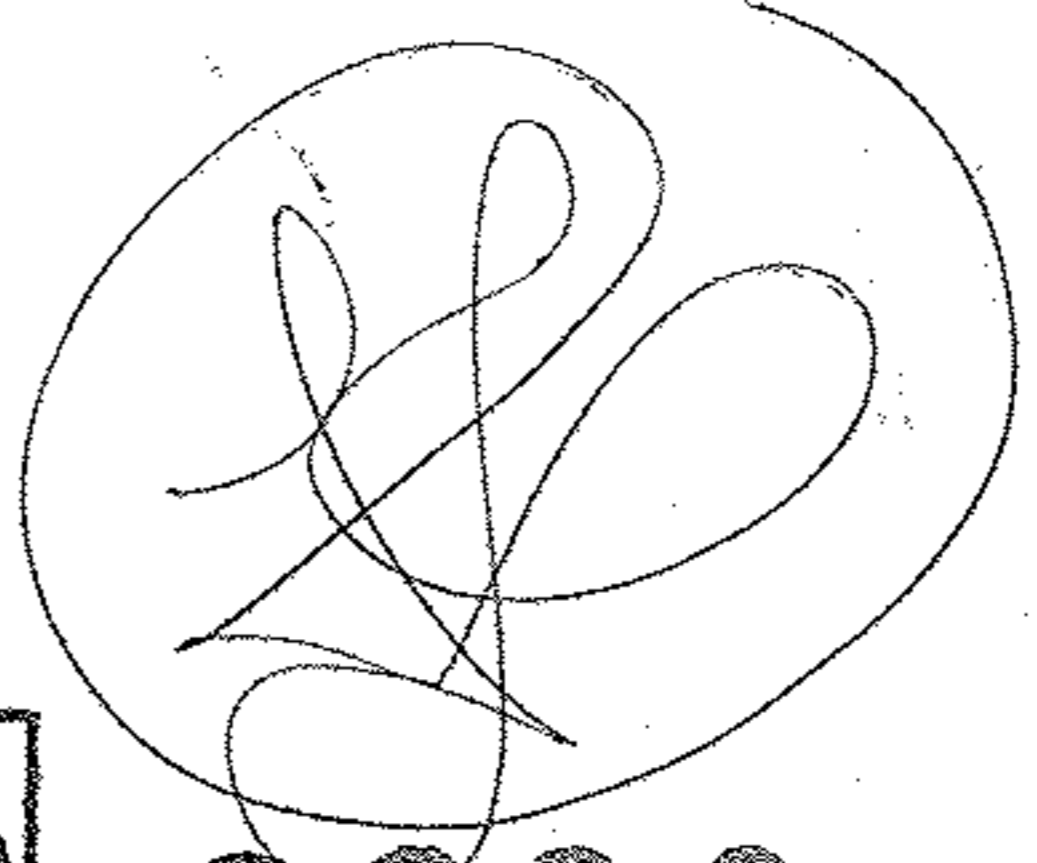

OBERLIN



SEE 9-00-090-A

RUSSIA TWP.

SCALE: 1" = 100'

09-00-080-B

SEE 9-00-090-B

E. 1/2