


721.38

197°49'

250.28

82°11'


PT. ~~-049~~ -143
PT. ~~16.41A~~ 15.99A,

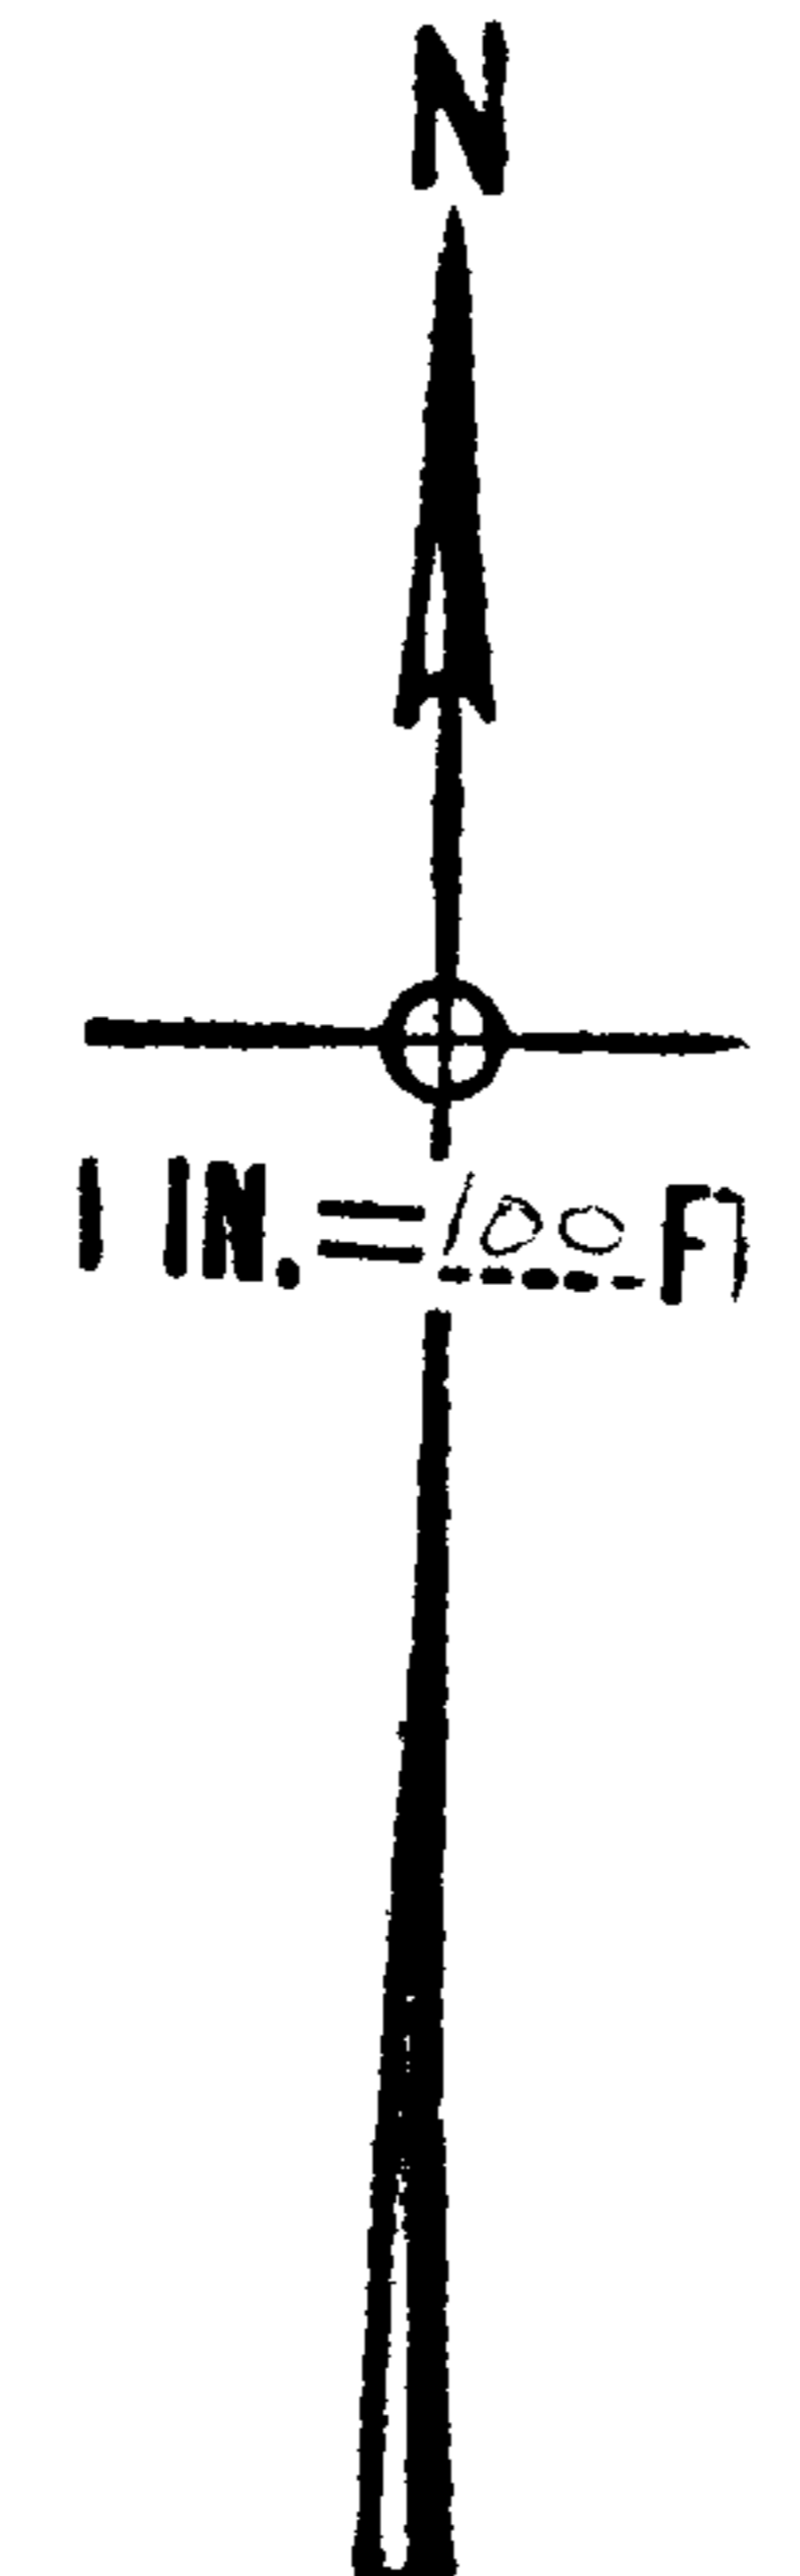

2708

7-110-86 L.L.

APPROVED
LORAIN CO.
MAP DEPT.
DATE 5-15-69
5-00-017-A
BY <i>H. Schubert</i>

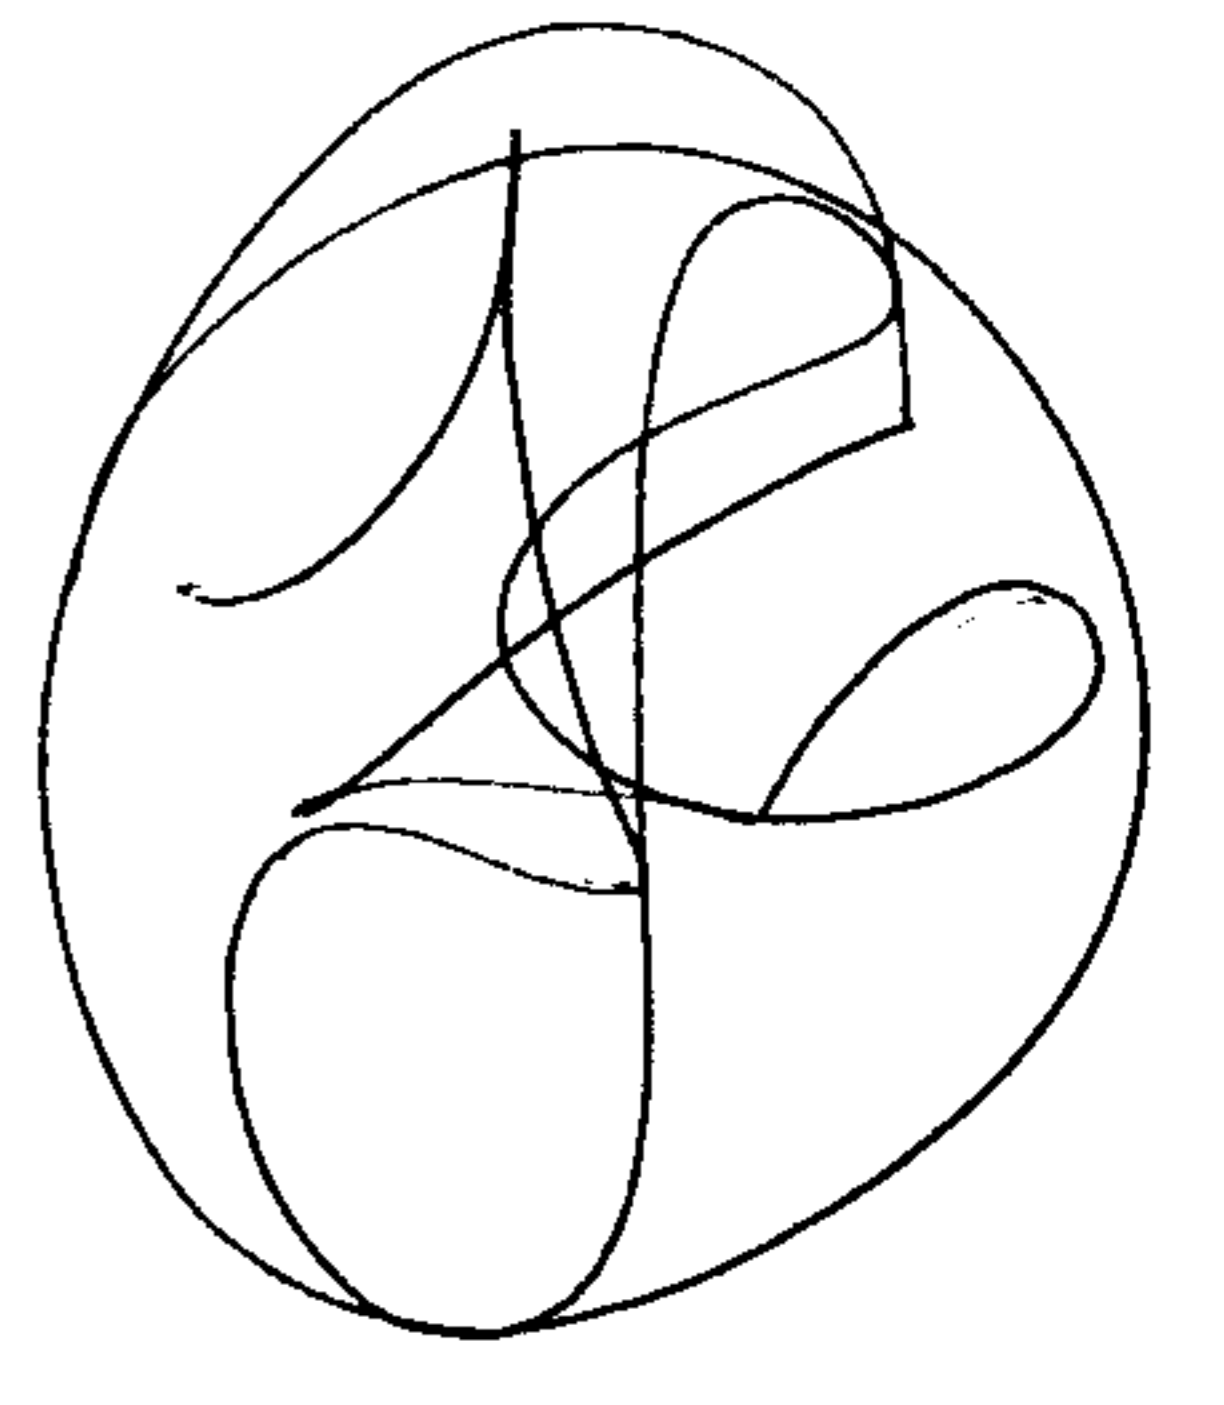

1286 1046.29

July 18 1969

-123
5.10A.

