

SEE 10-00-020-




OBERLIN - ELYRIA

237.28

259.64

60

RD.

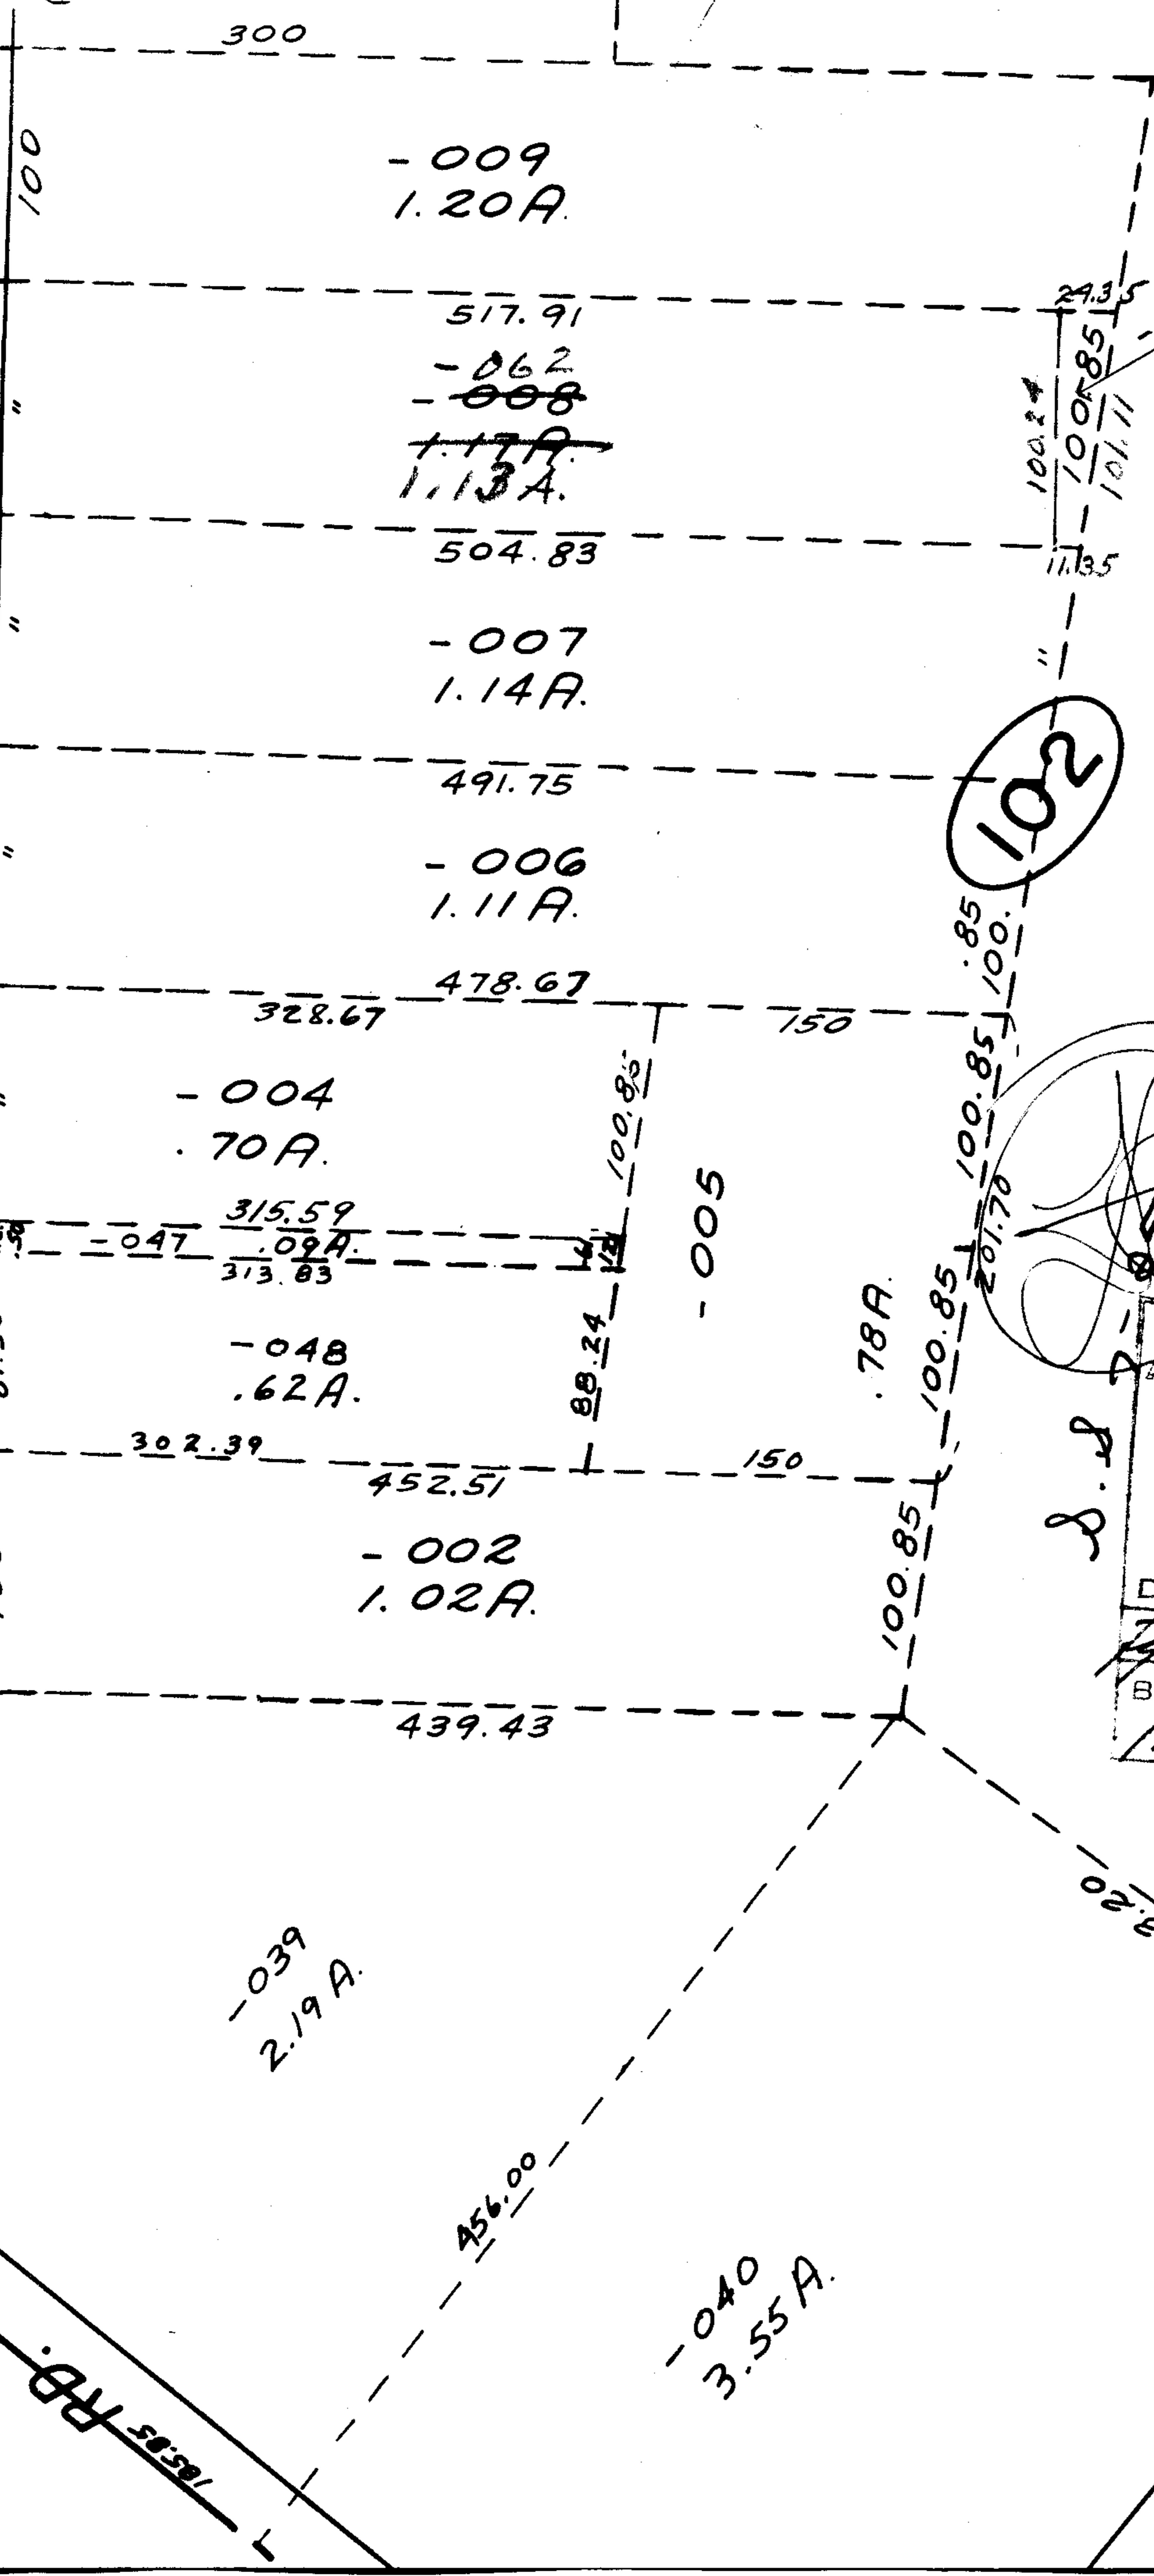

-009
1.20A

517.91

-062
~~-008~~

~~1.17A~~
1.13A

504.83

-007
1.14A

491.75

-006
1.11A

478.67

-004
1.09A

315.59

-047
1.09A

313.83

-048
1.02A

302.39

452.51

-002
1.02A

439.43

-039
2.19A

-040
3.55A

102

100.24

100.85

100.85


100.85

100.85

100.85

100.85

517.91
24.35
493.56

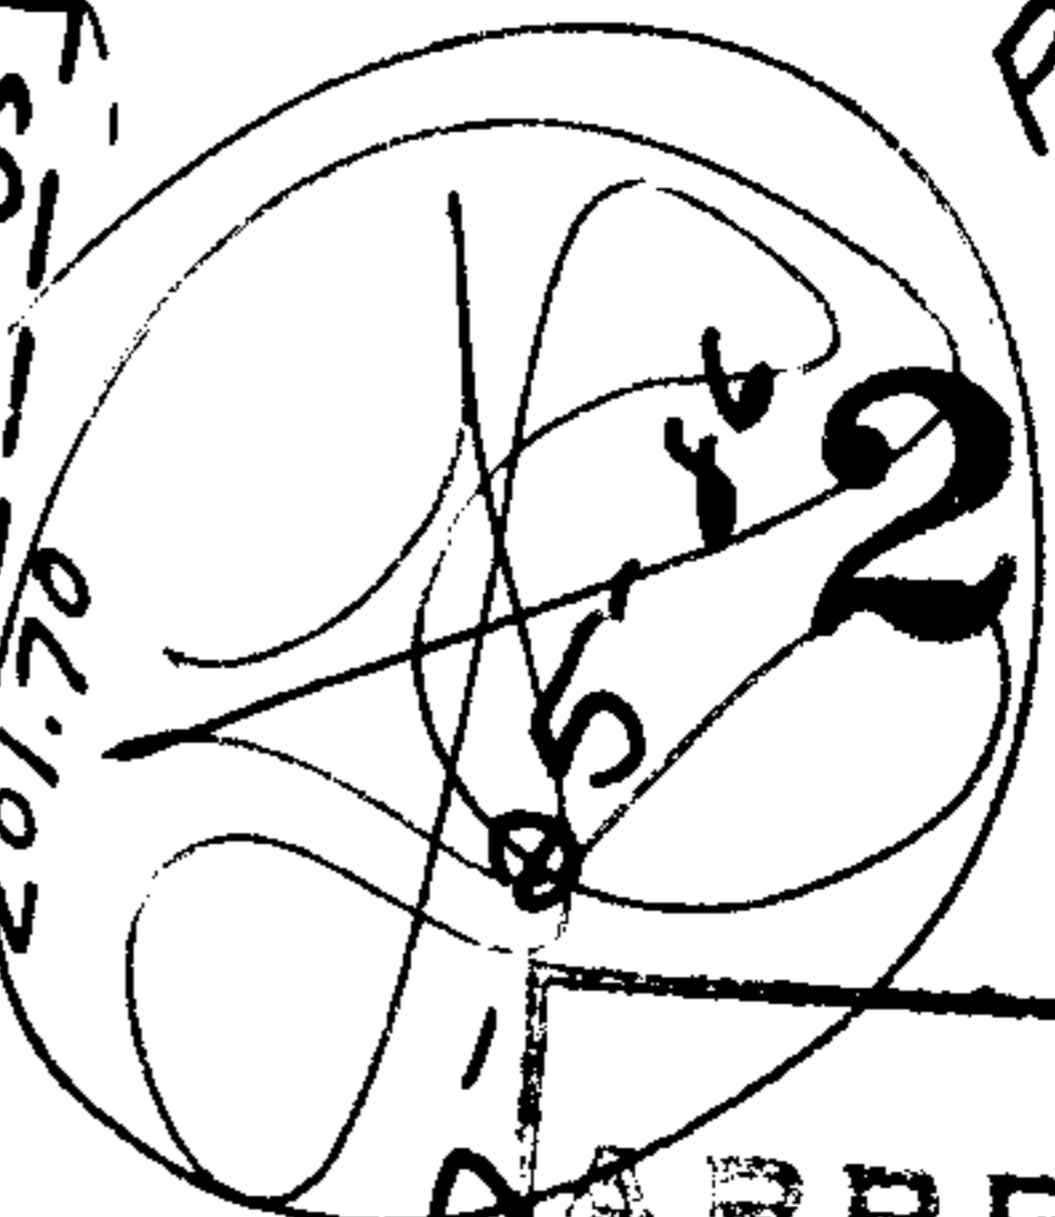

Pt. 052
Pt. 12.10A

APPROVED
LORAIN CO.
MAP DEPT.
DATE 5/15/69
10-00-020-E
BY
A.J. Kelling

393.20

HINGS 454.7

906.38
906.2