

1199.88 RD.

839.8

360

1283.50

170

100

100

100

(60)
 190 190
 200 200
 210 210
 220 220
 230 230
 240 240
 250 250
 260 260
 270 270
 280 280
 290 290
 300 300
 310 310
 320 320
 330 330
 340 340
 350 350
 360 360
 370 370
 380 380

~~-003~~ -008
~~60.27A.~~ 59.26A.


-004
 15.00A.

2746
 -005
 || 20.00A.
 2740.45


317.80

2715 -006
 80.00A.

60.27
 1.01
 59.26

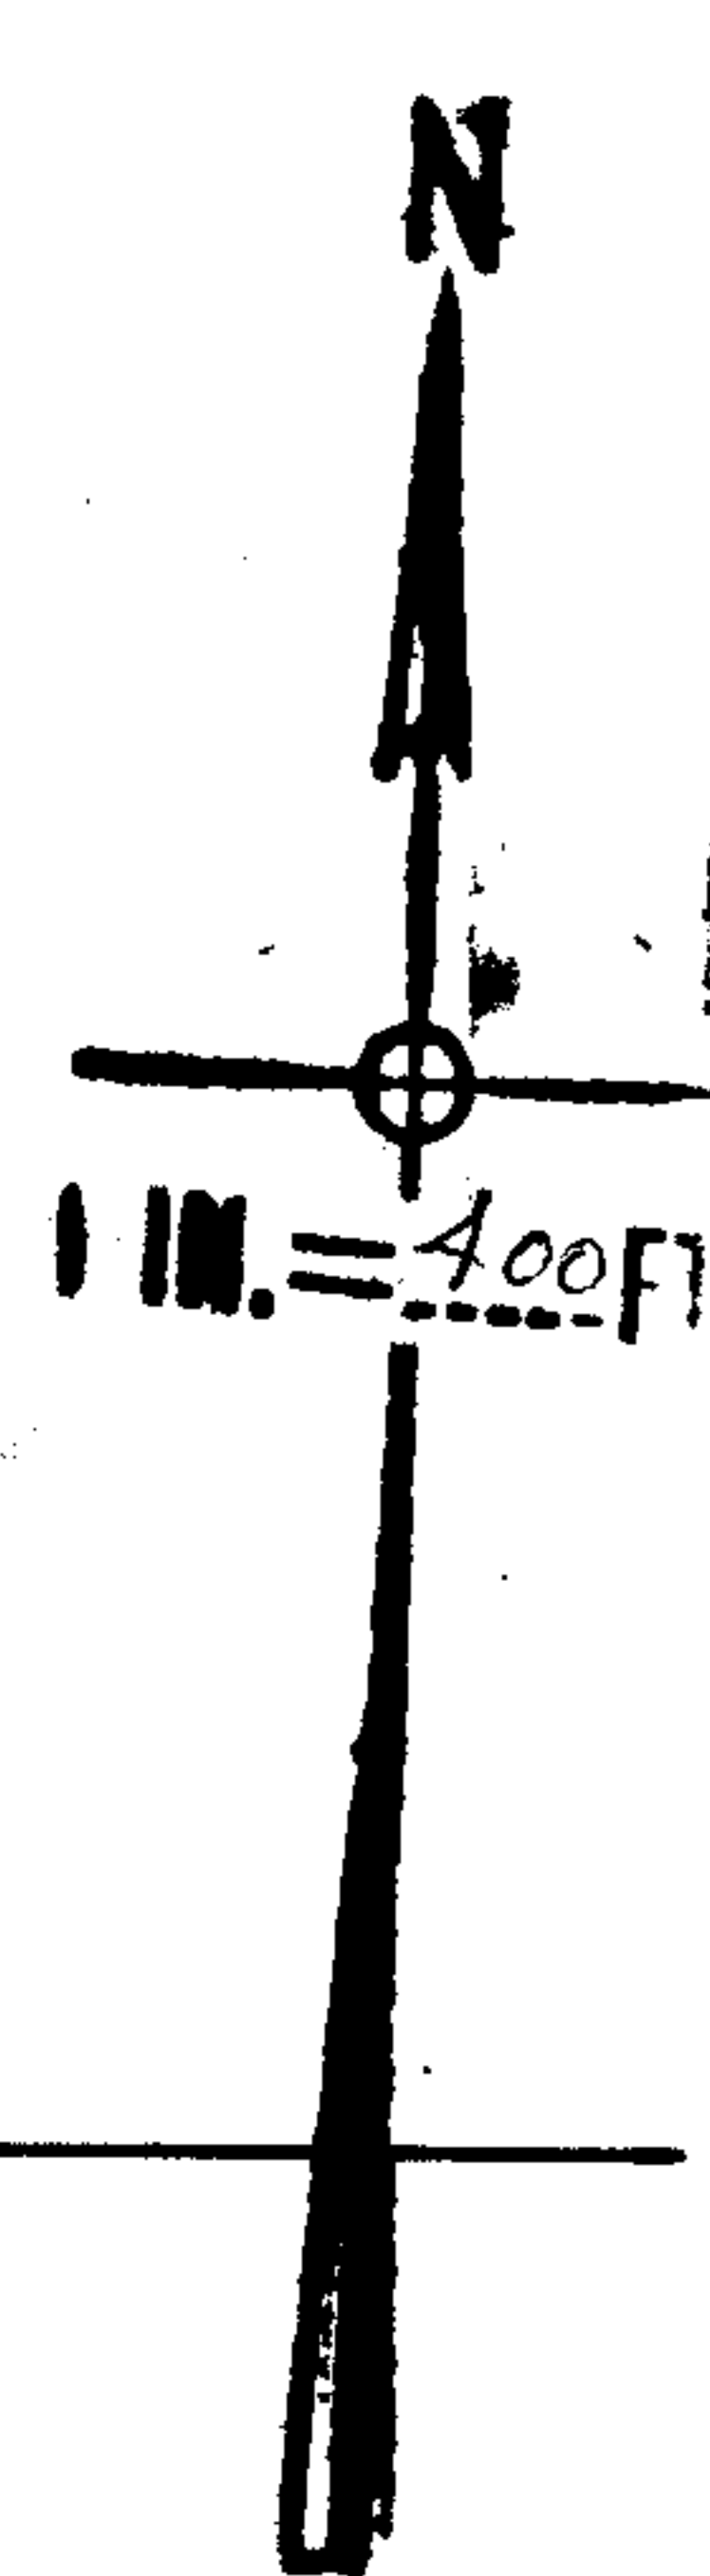

APPROVED
 LORAIN CO.
 MAP DEPT.
 DATE 5-17-69
 11-D
 BY S.M.
 H. Colbert.

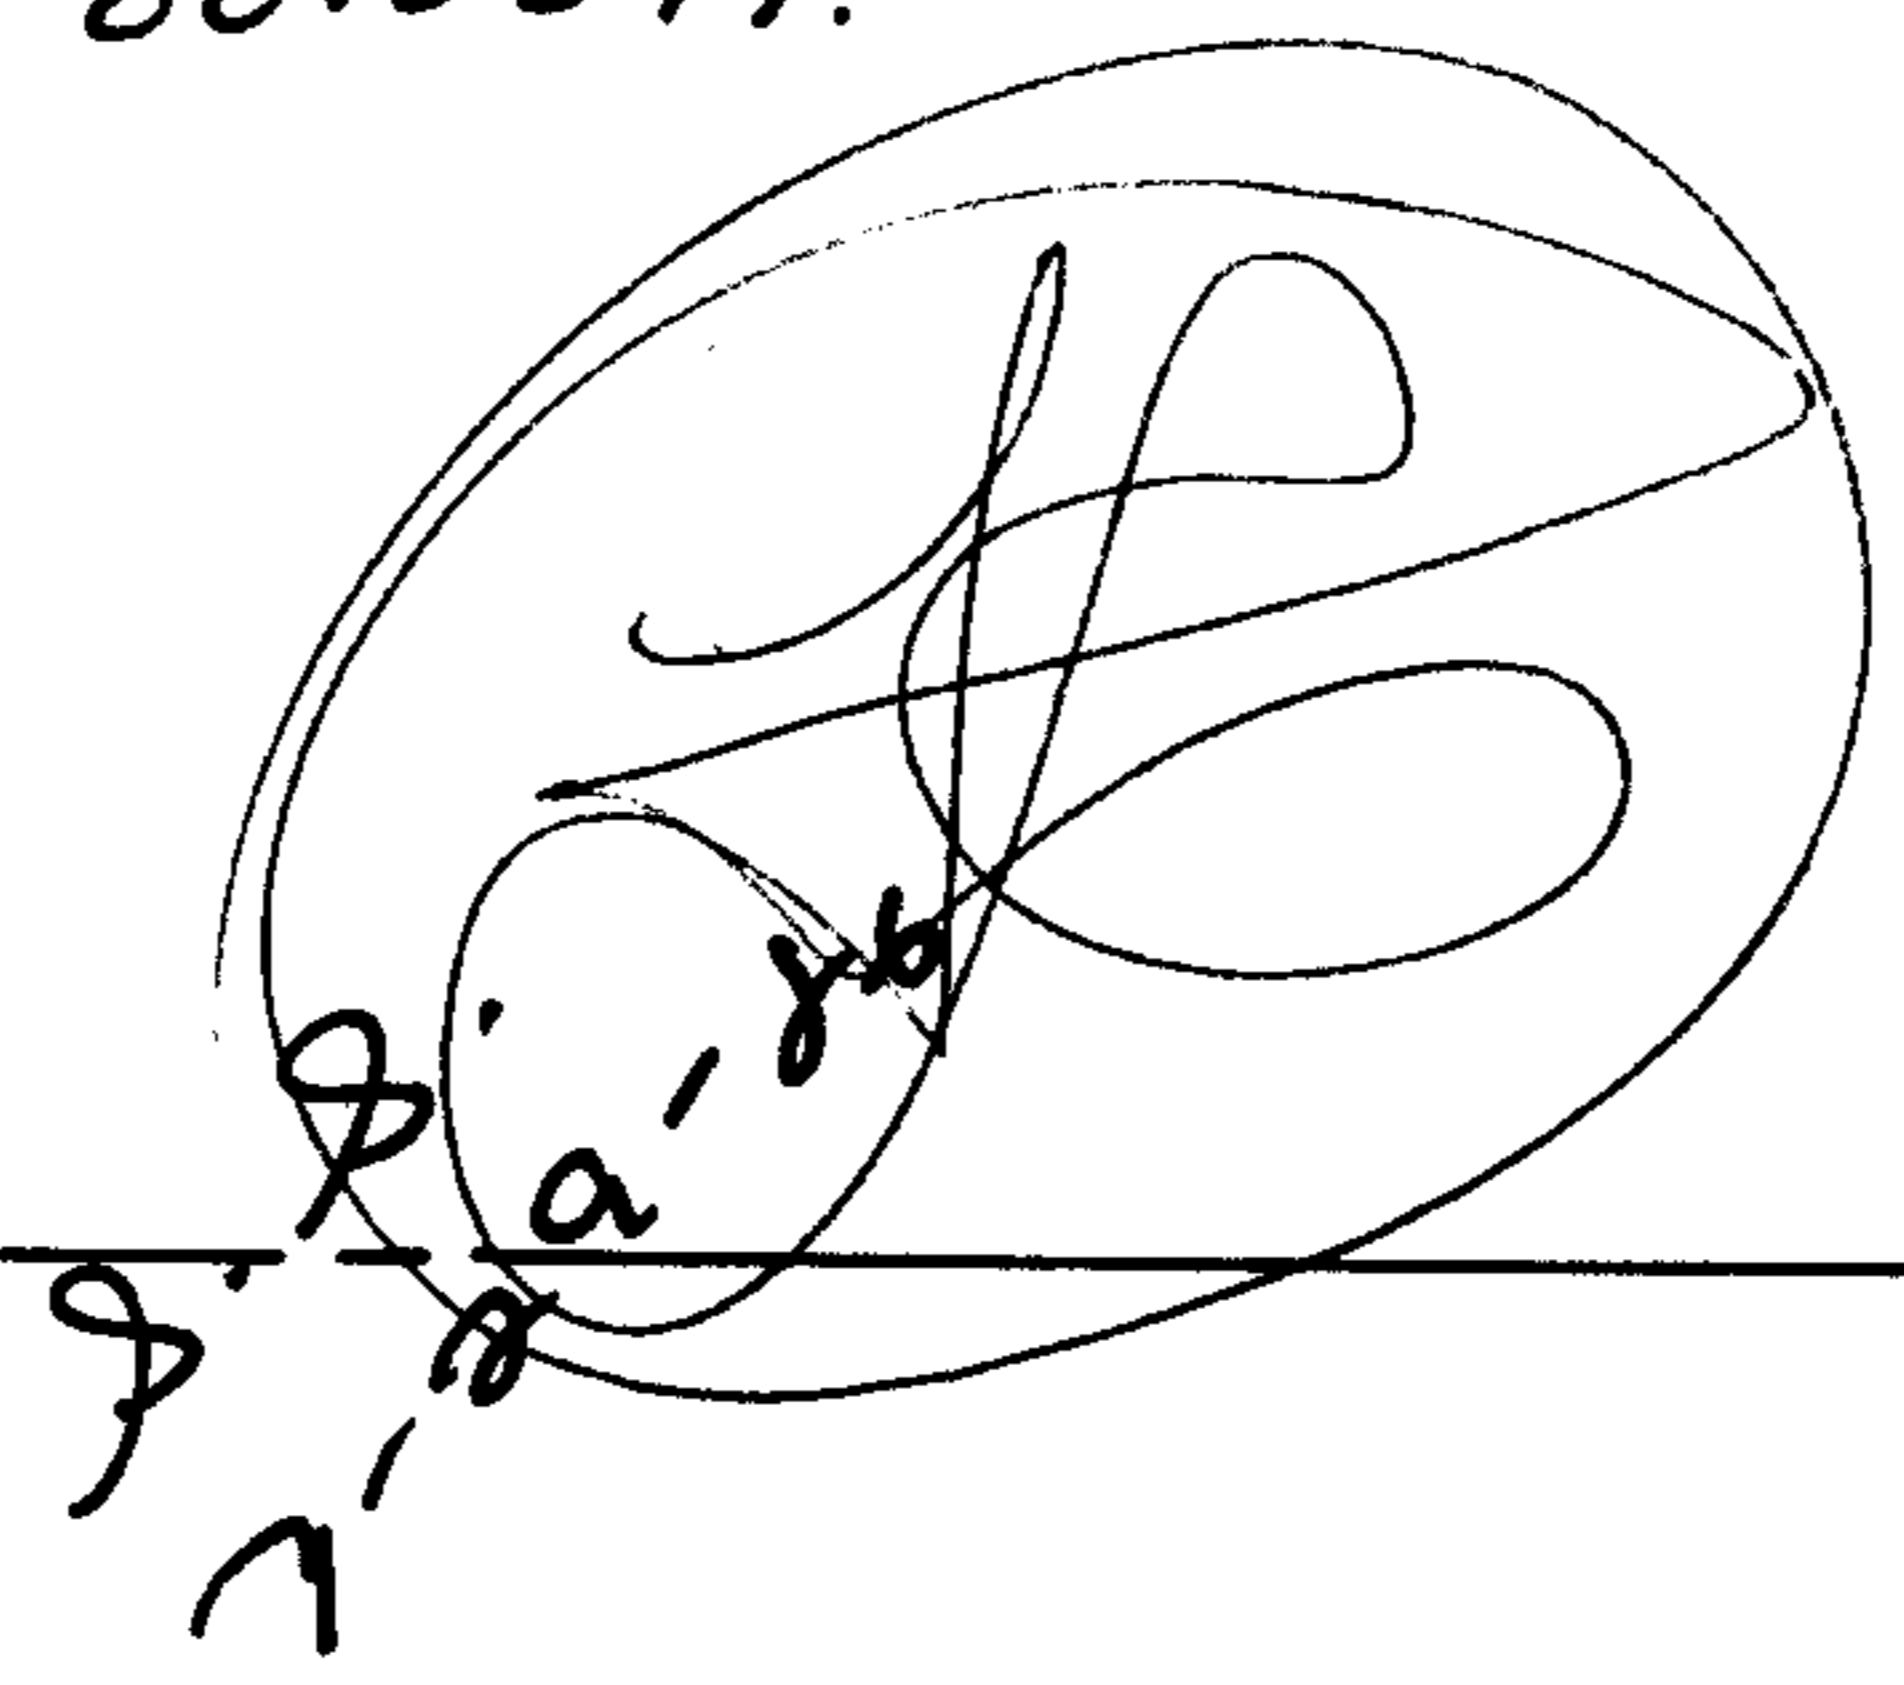

MAY 27 1969 -001
 68.09A.

BROKAW

1875

148
 371
 003
 47A.
 59.60

12