

MAY 2 1969

MAY 2 1969


-011  
8.67A.

-009  
44.33A.


# 2719  
APPROVED  
LORAIN CO.  
MAP DEPT.  
DATE 5/20/69  
BY R.J. Kelly

MAY 27 1969

1510.08  
S. S. 29-86  
-002  
1930A.

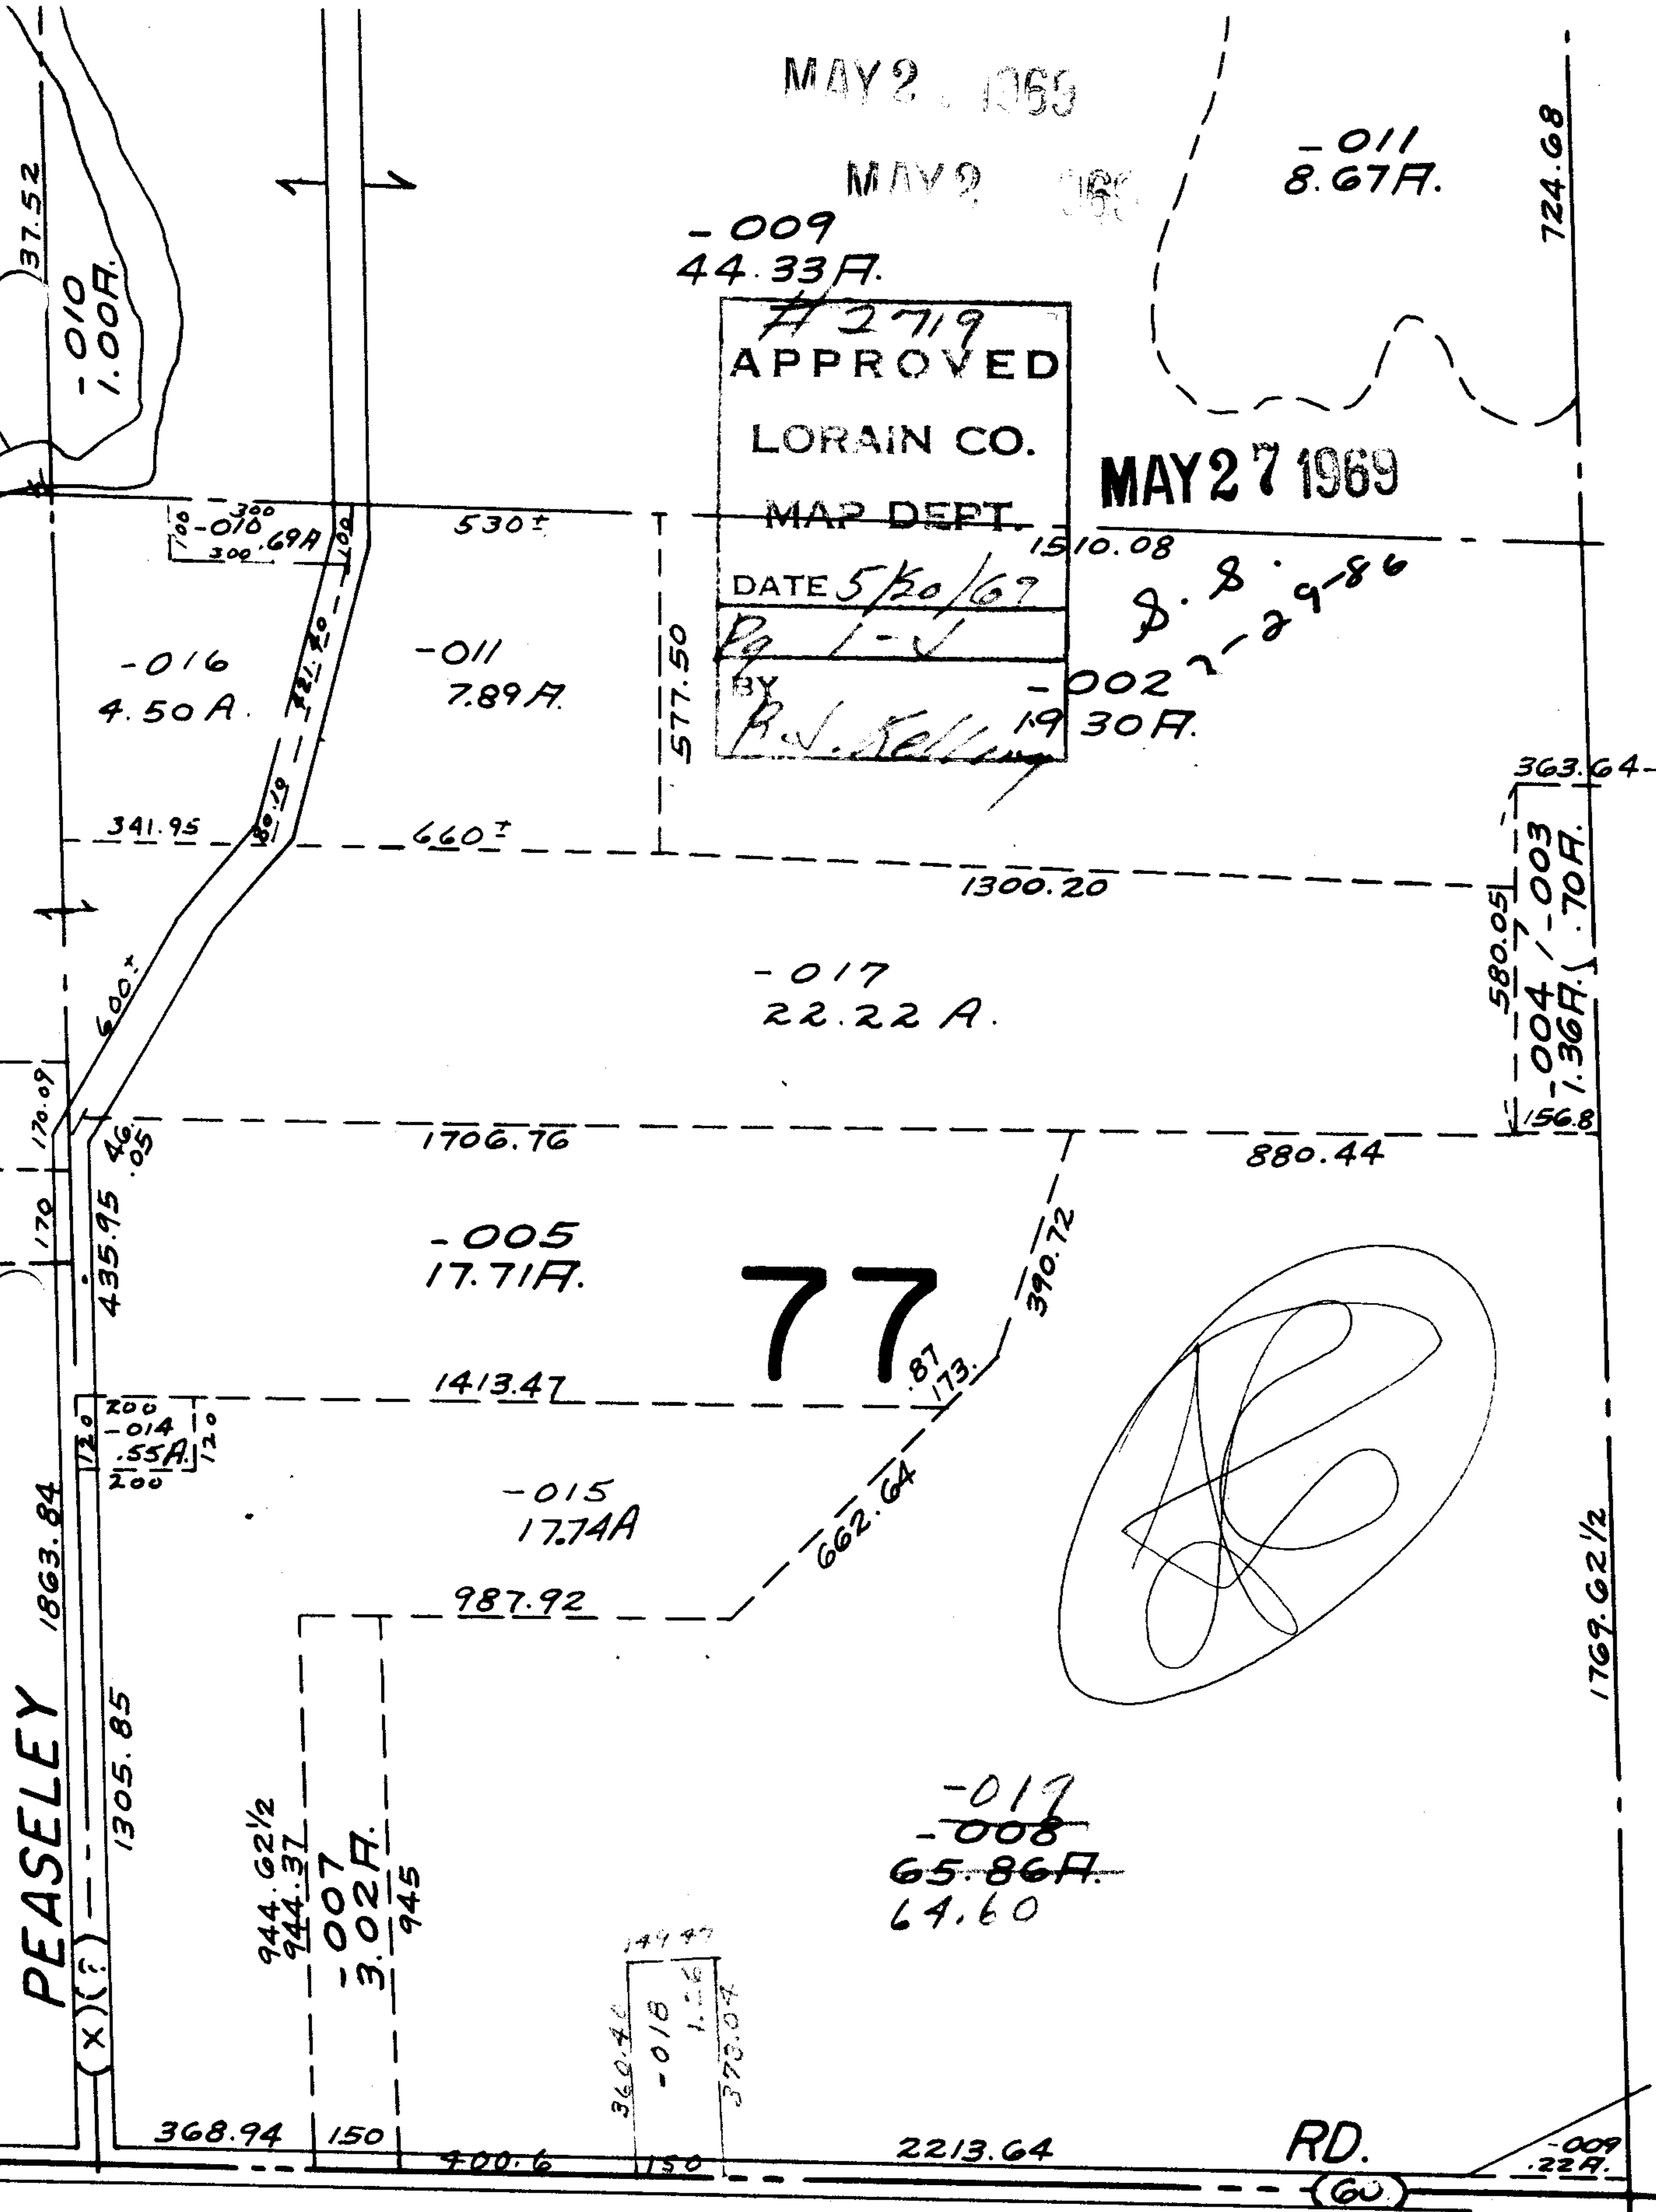

77

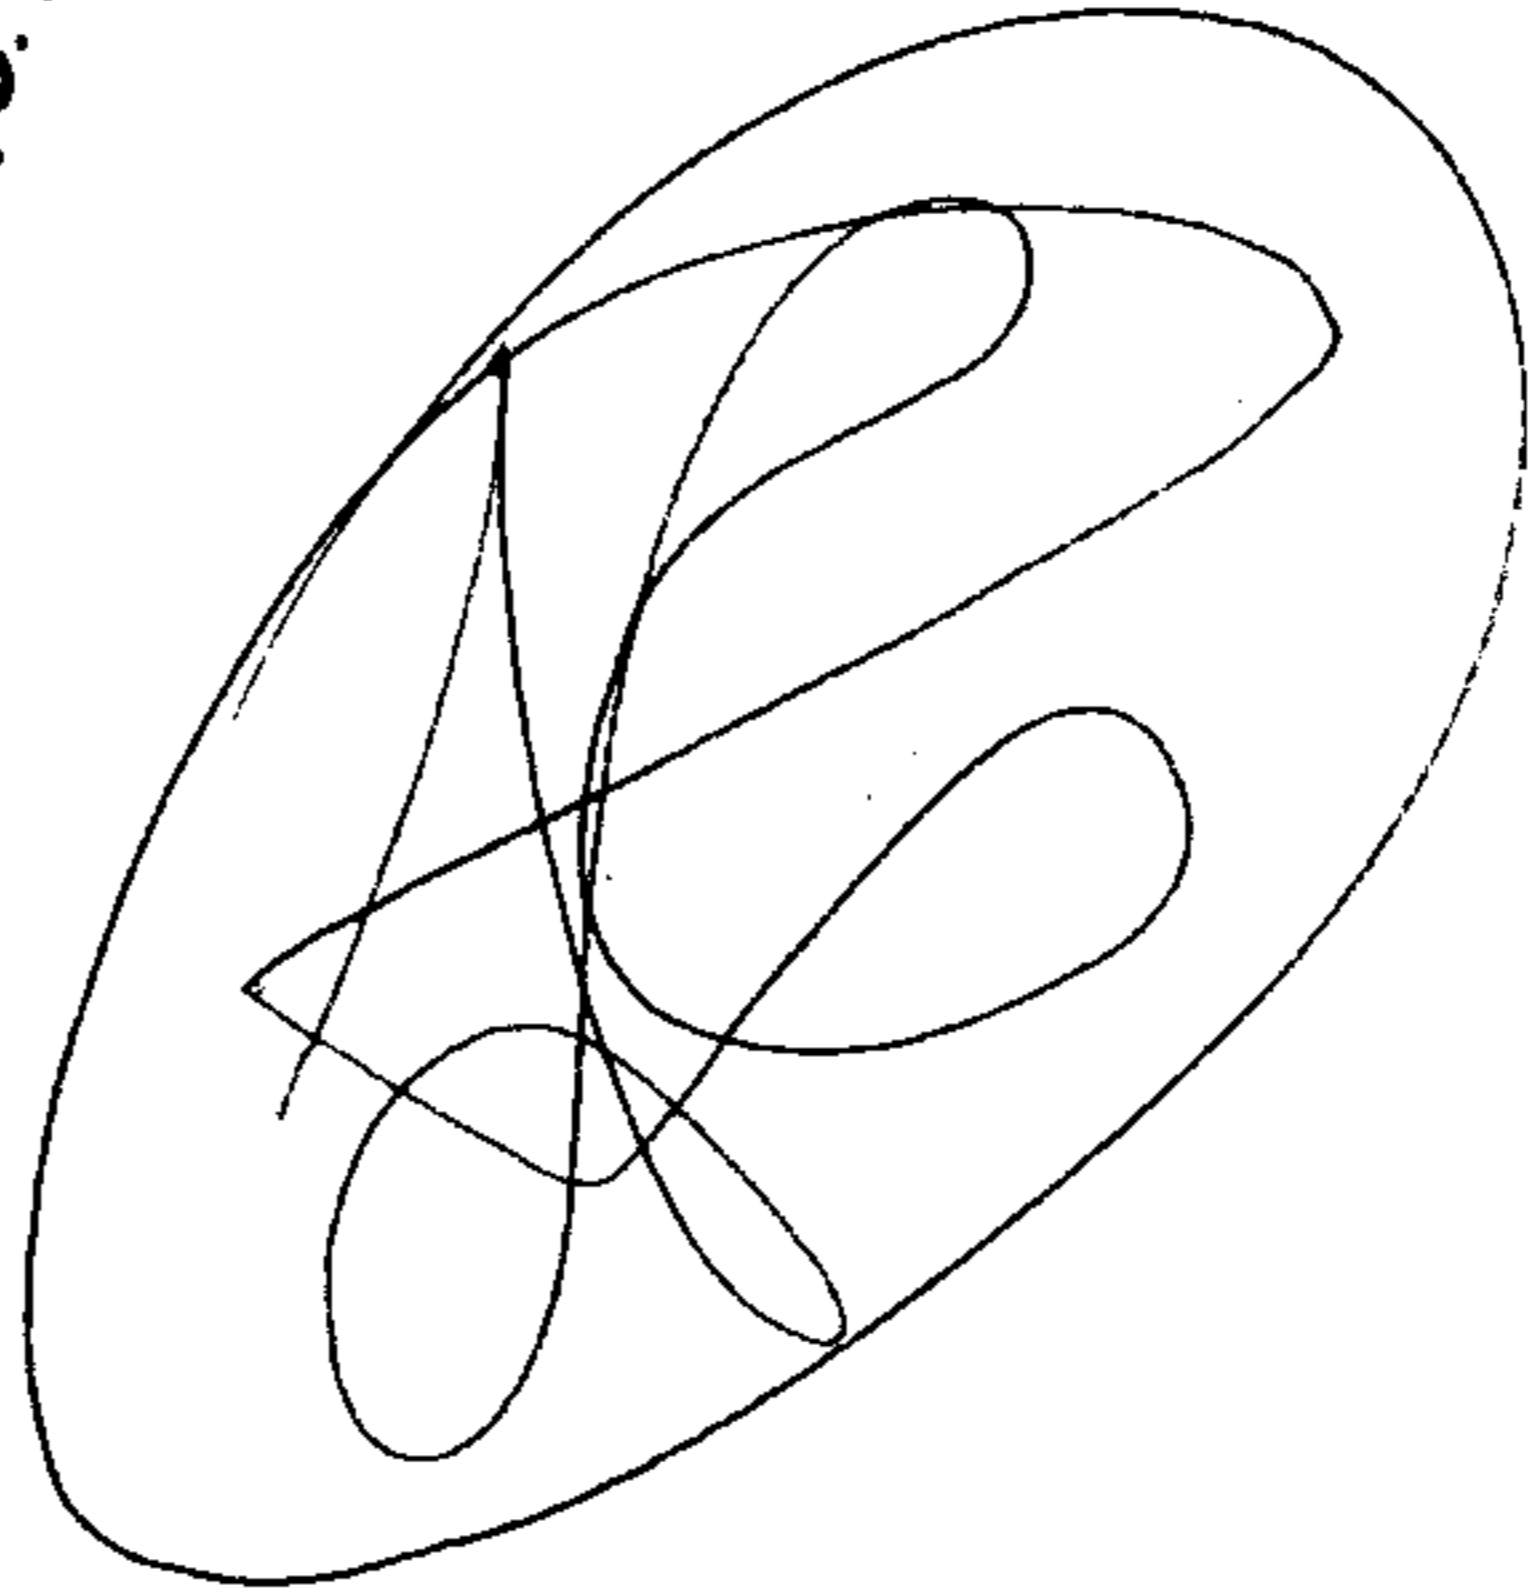

PEASELEY

TURNPIK

OHIO

RD.

2213.64  
400.60  

---

1813.04  
150  

---

1663.04

LOTS 51 52 61 62