


3-00-017 B

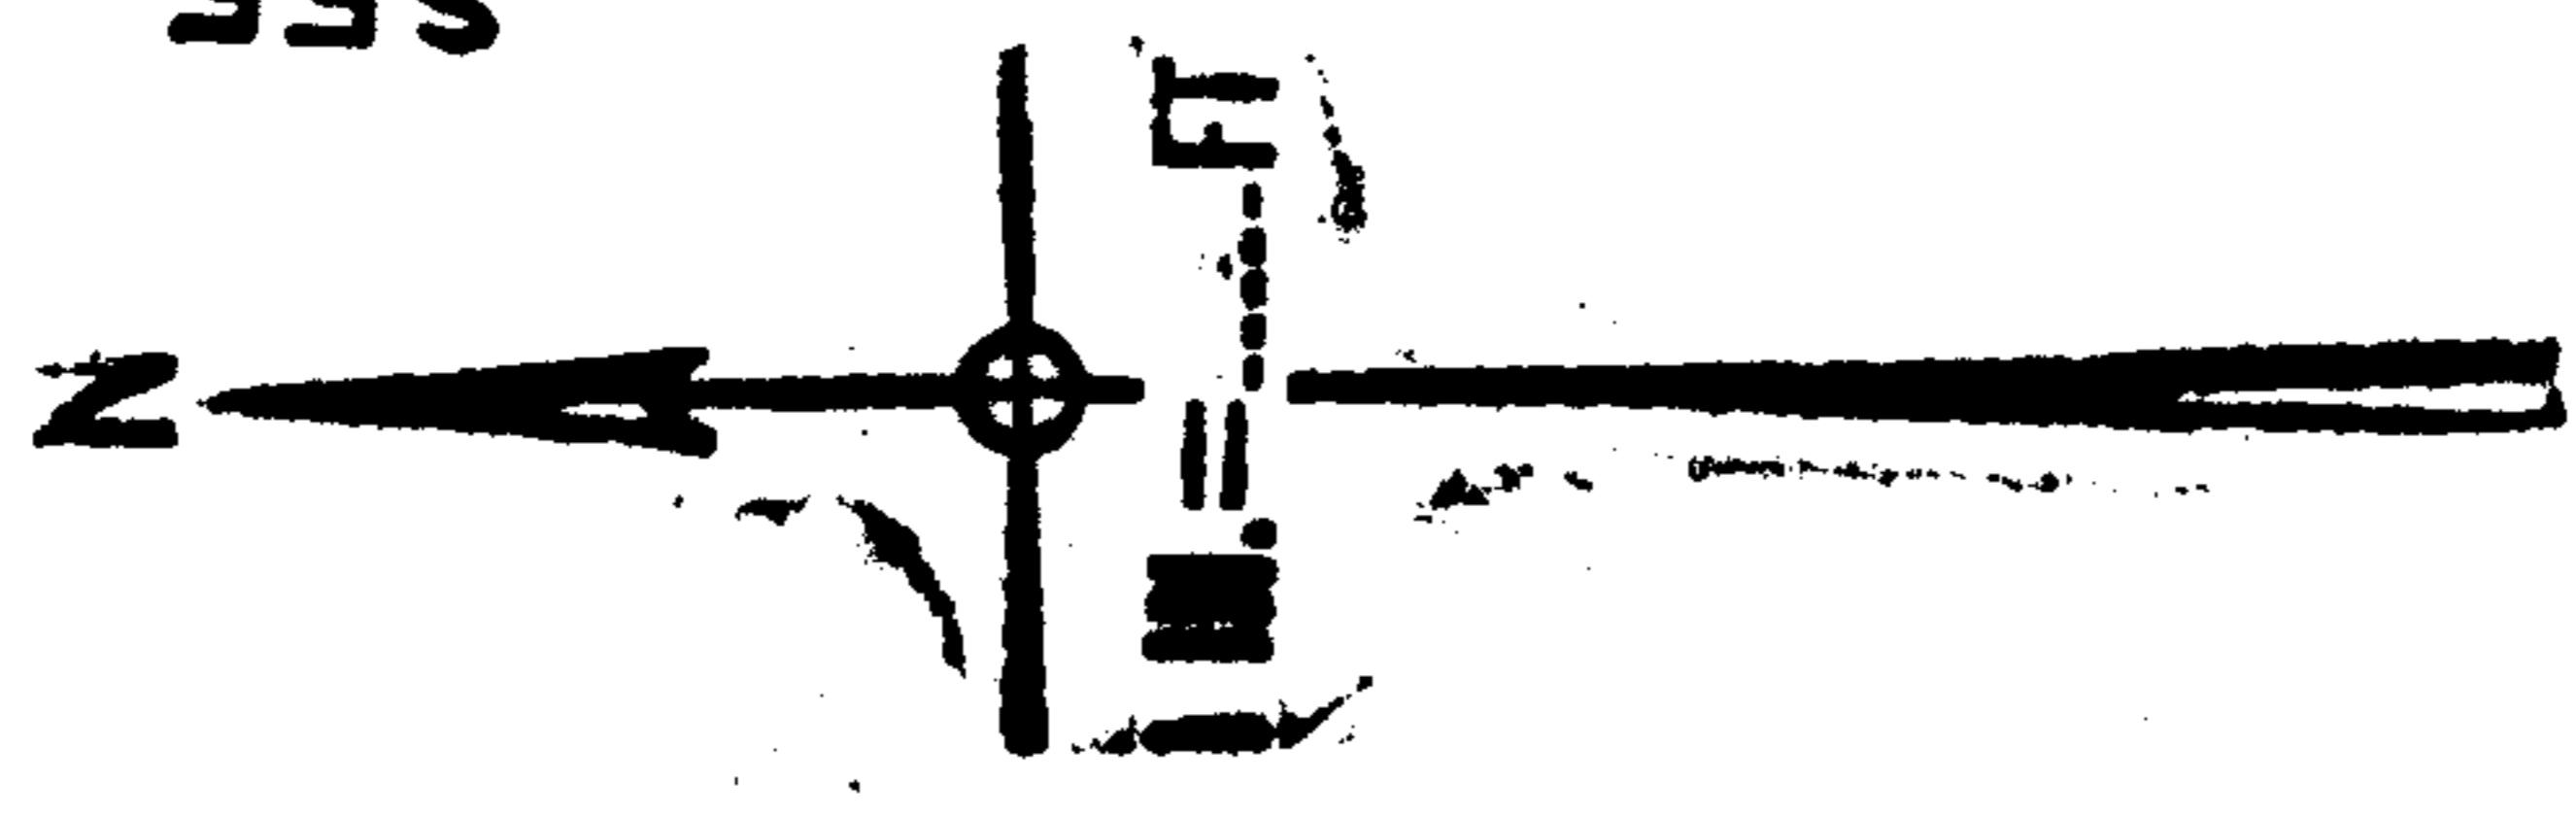

SEE

Abbey Rd

95.88

04 017 277.88  
04 26 A 177.88

100.50

30

230.0

.53 AC

-027

230.0

270.99

170.99

200

-009

.49 A.

-018

8.37 A.

1050

968.50 ~~1190.50~~

7-15786  
S.S

~~007~~ 028

7.52 A.


6.99 AC

1201.18

921.18

3-00-003 A

1198.50  
230  
968.50

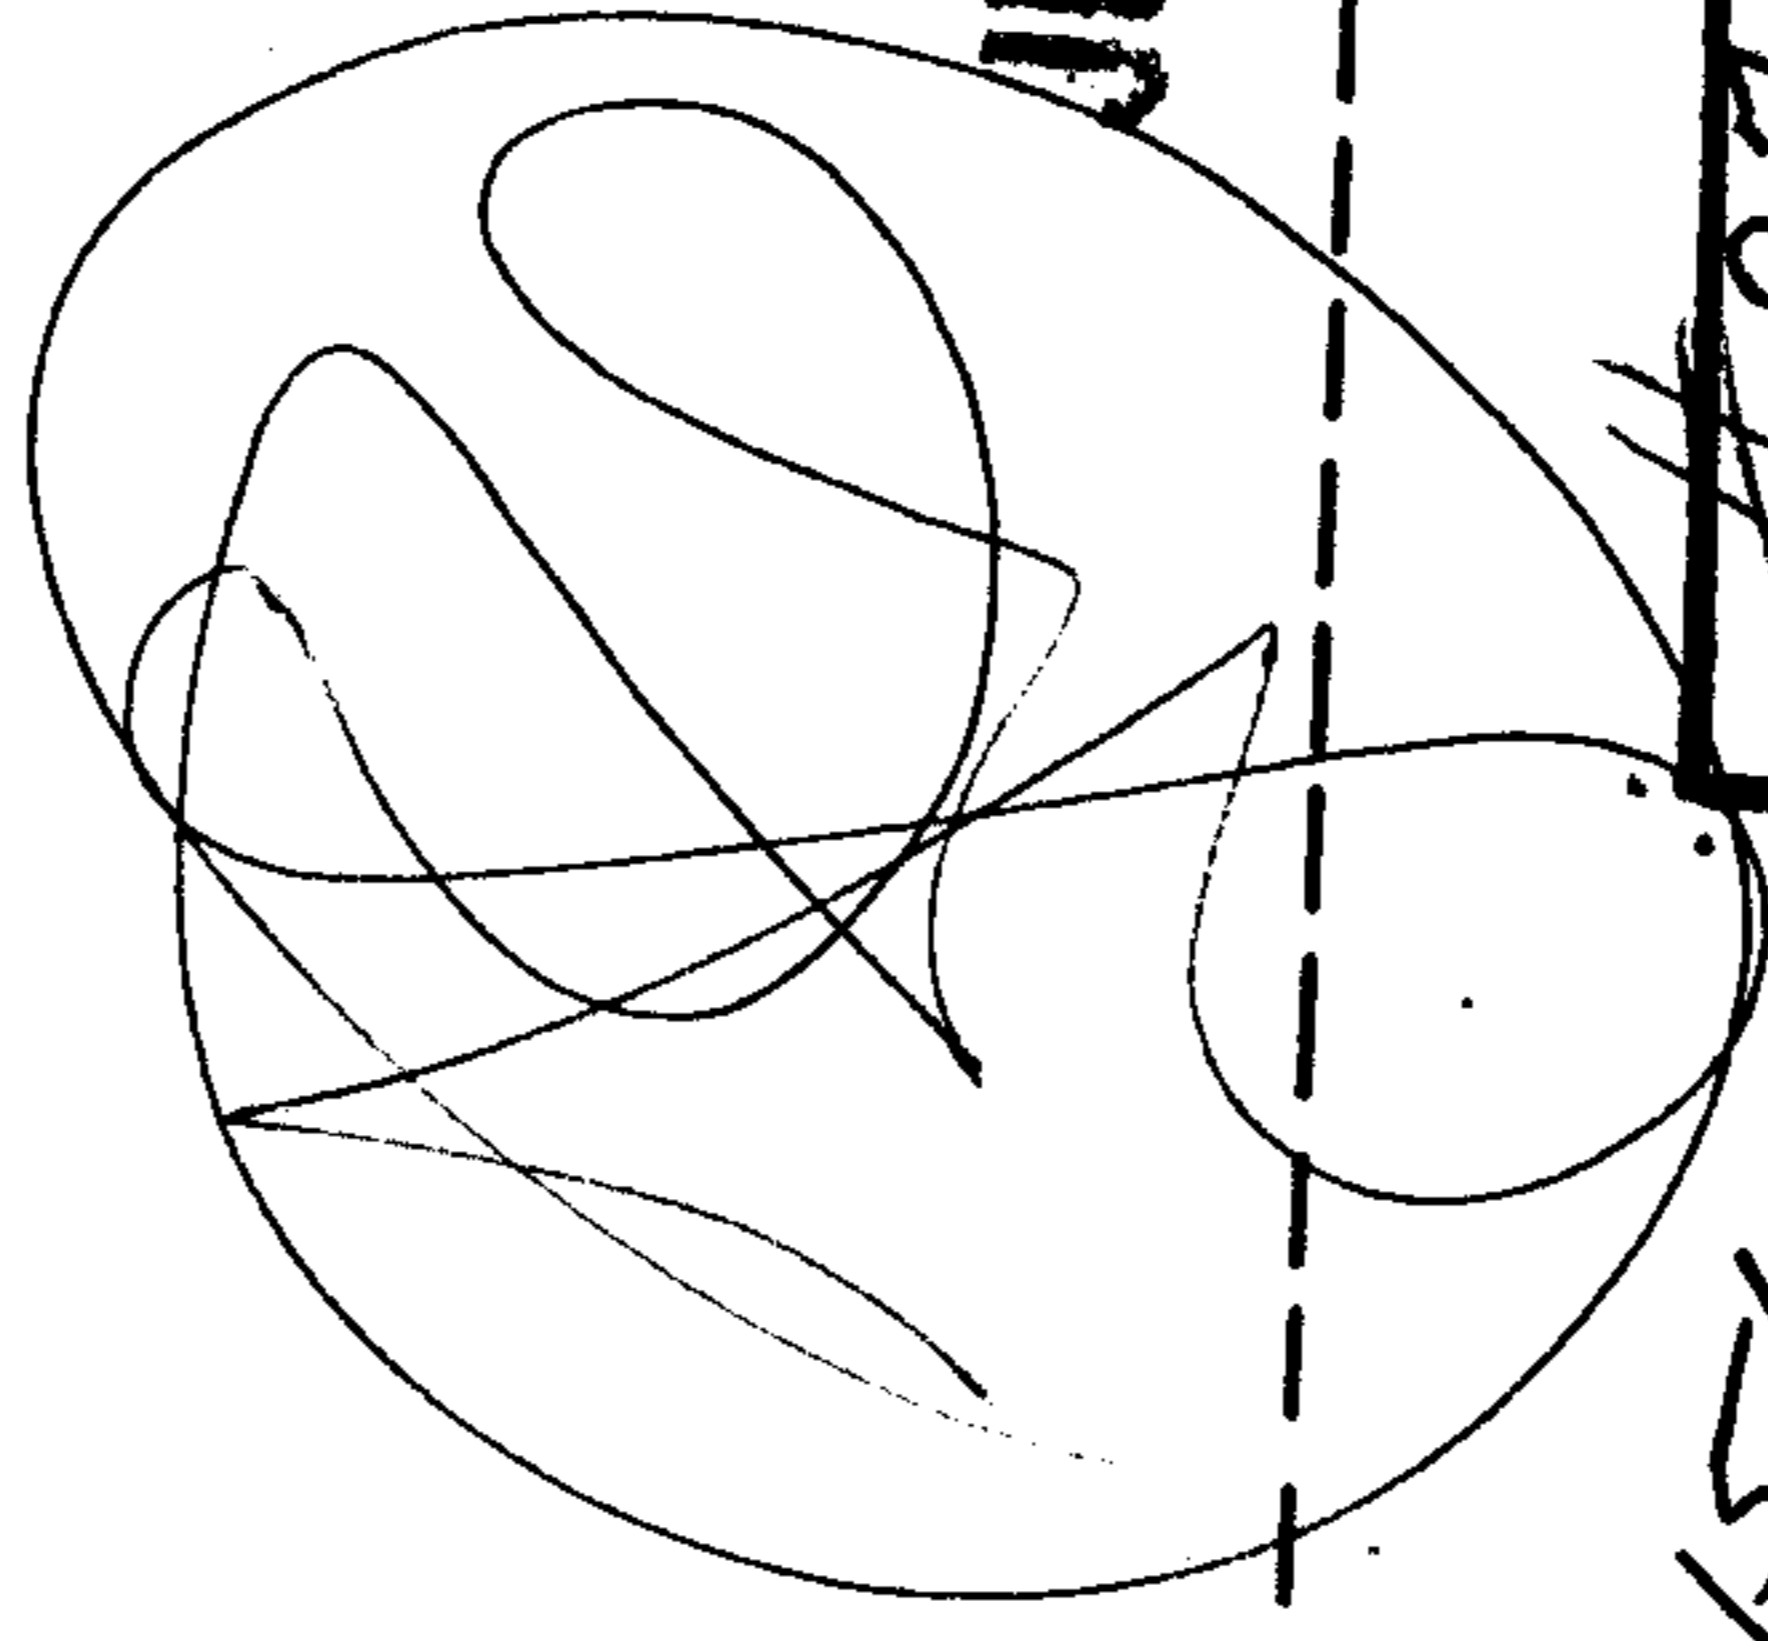

JUN 3 1963

#2730
APPROVED
LORAIN CO.
MAP DEPT.
DATE 5/22/69
3-00-003A
BY L. V. Hall