

SEE 21-F

ASHL

TRACT

1964.30

-001  
57.37 A.

NEW LONDON - EASTERN

764.30

1064.30


322

300

300

599.70

211

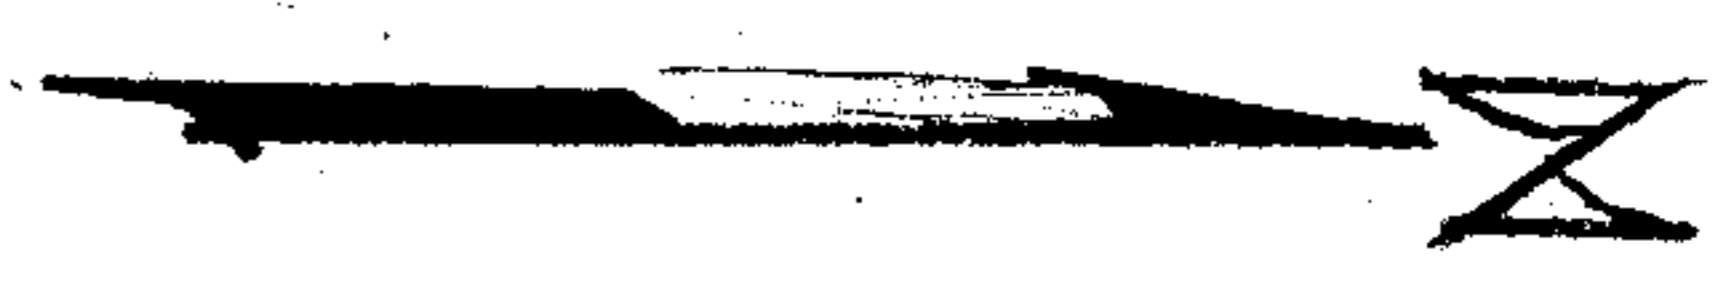


2731

APPROVED
LORAIN CO.
MAP DEPT.
DATE 5/24/69
BY R. J. Sellers

Copyright 1962 JUN 3 1969

REVISED 1-20-69

21-G

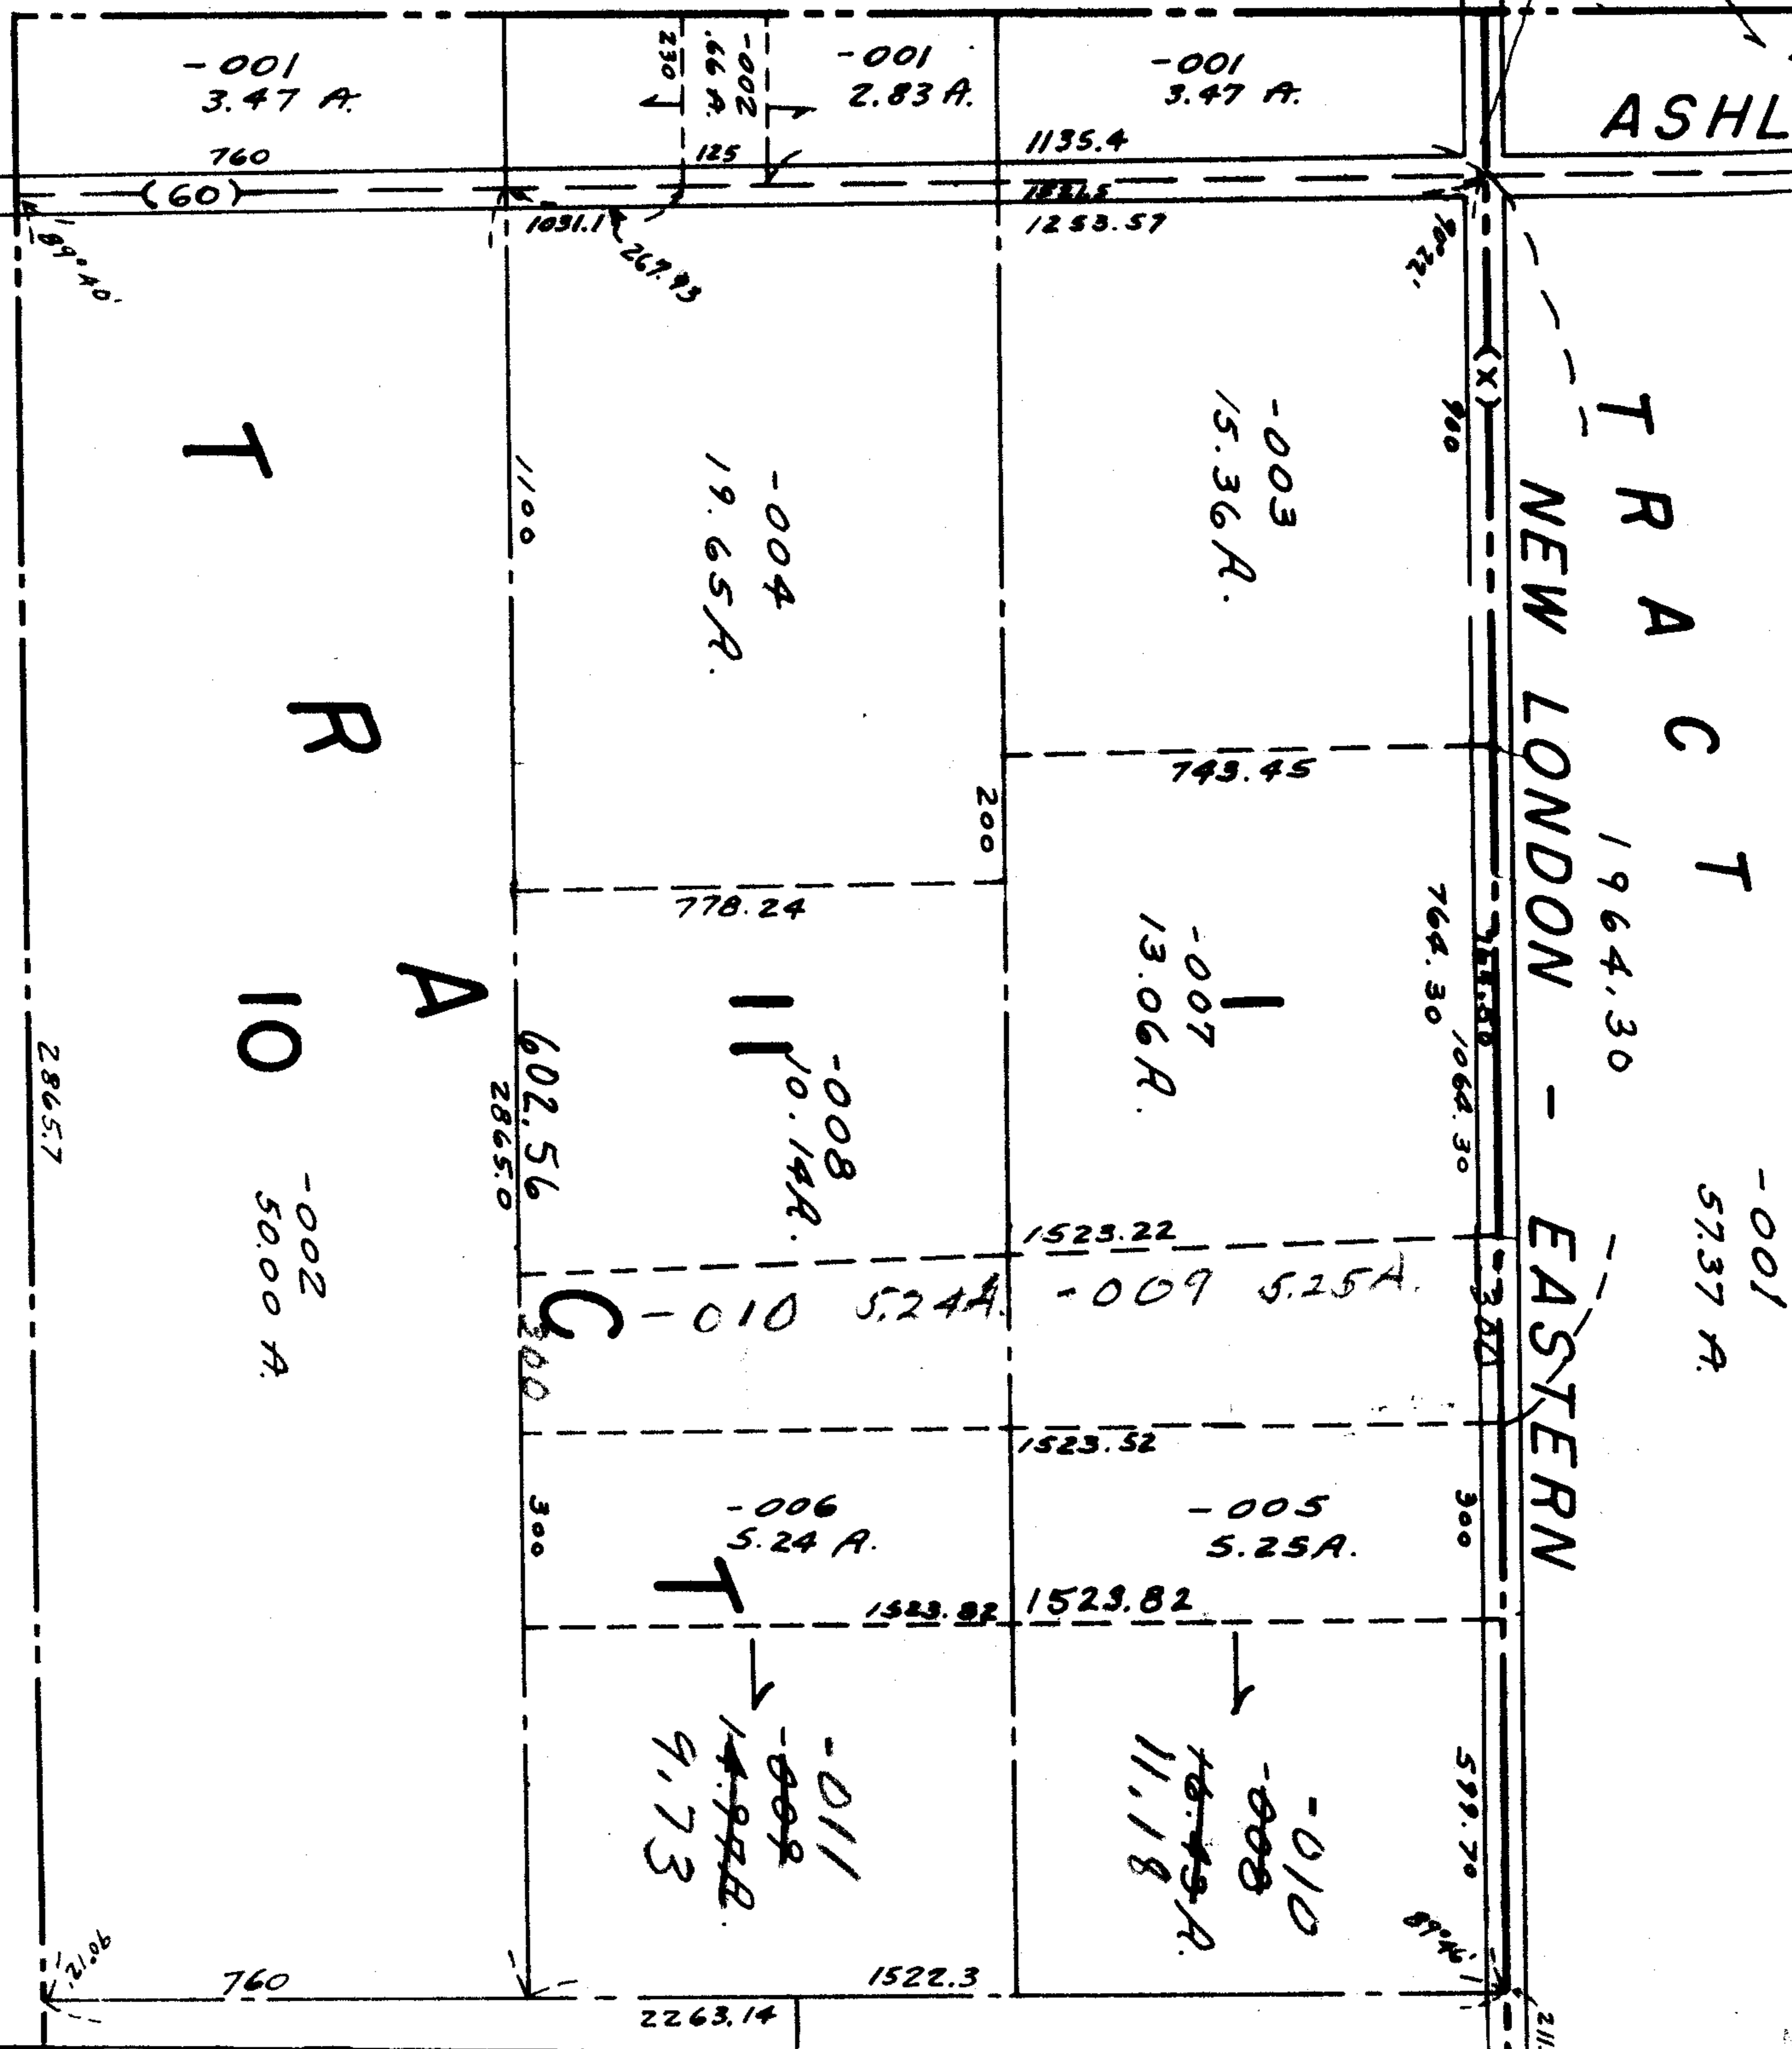

58

HUNTINGTON TWP.

SCALE: 1" = 400'