

#2734

# Erie

00


PA-001  
PA 9.00A.

R. R.

01-00-001-110-006  
Pt 23.52 AC - (10)  
23.02 AC.

-009 547.00  
547.00 1.50 AC

0.08  
55A.

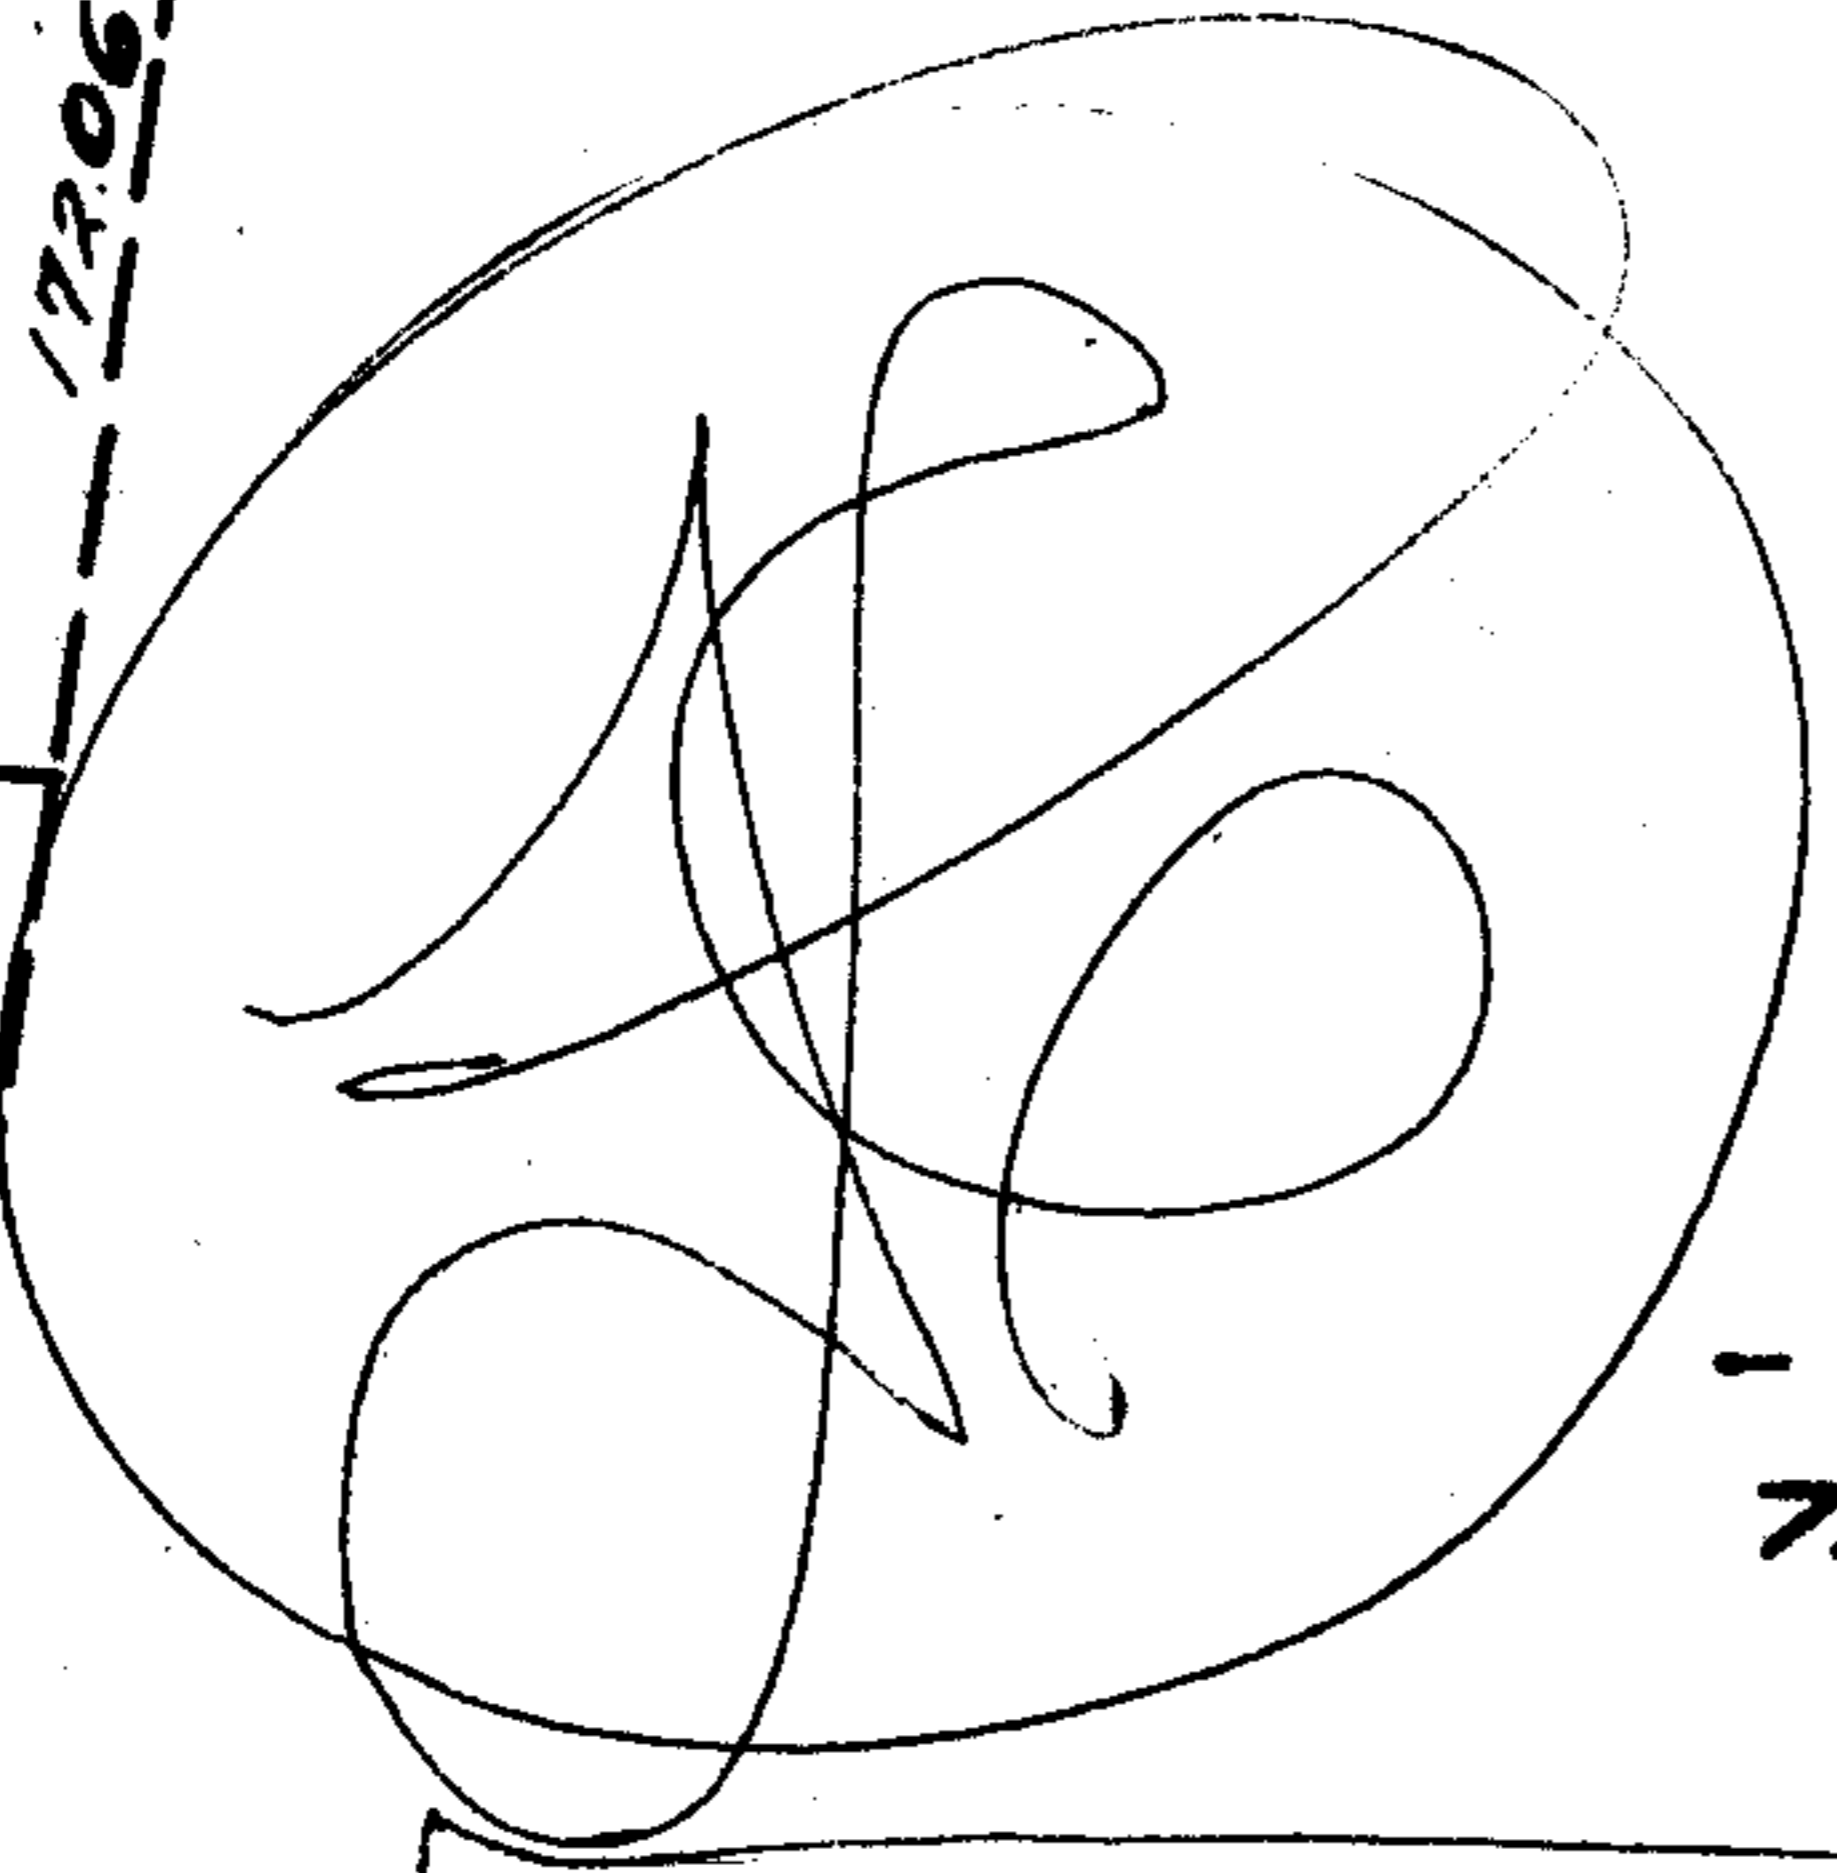

APPROVED  
LORAIN CO.  
MAP DEPT.  
DATE 5/26/69  
By 1-00-006-A  
L.W. Hall

-021  
7.57A.

JUN 3 1969

## 2734

SEE + 1-B  
~~1-00-003-B~~  
1-00-003-B  
003-A  
002-B  
002-C  
001-D  
001-C  
004-A

UPDATE

120  
144.02  
-009  
.33A.  
144.02  
-019  
.50A.  
144.02  
-017  
.65A.

2 (LIBERTY AVE.)  
291.20

RD. RD.

101.02  
-001  
.95A.  
101.02  
102

Pg  
1-00-006A

SEE 1-C