


$30 \times 195 = 5862.00$ Sq Ft
 $\frac{4150.00}{100} = 41.50$ Ac
 $10012.00 \text{ Sq Ft} \div 43560 = .23 \text{ Ac}$

Erie

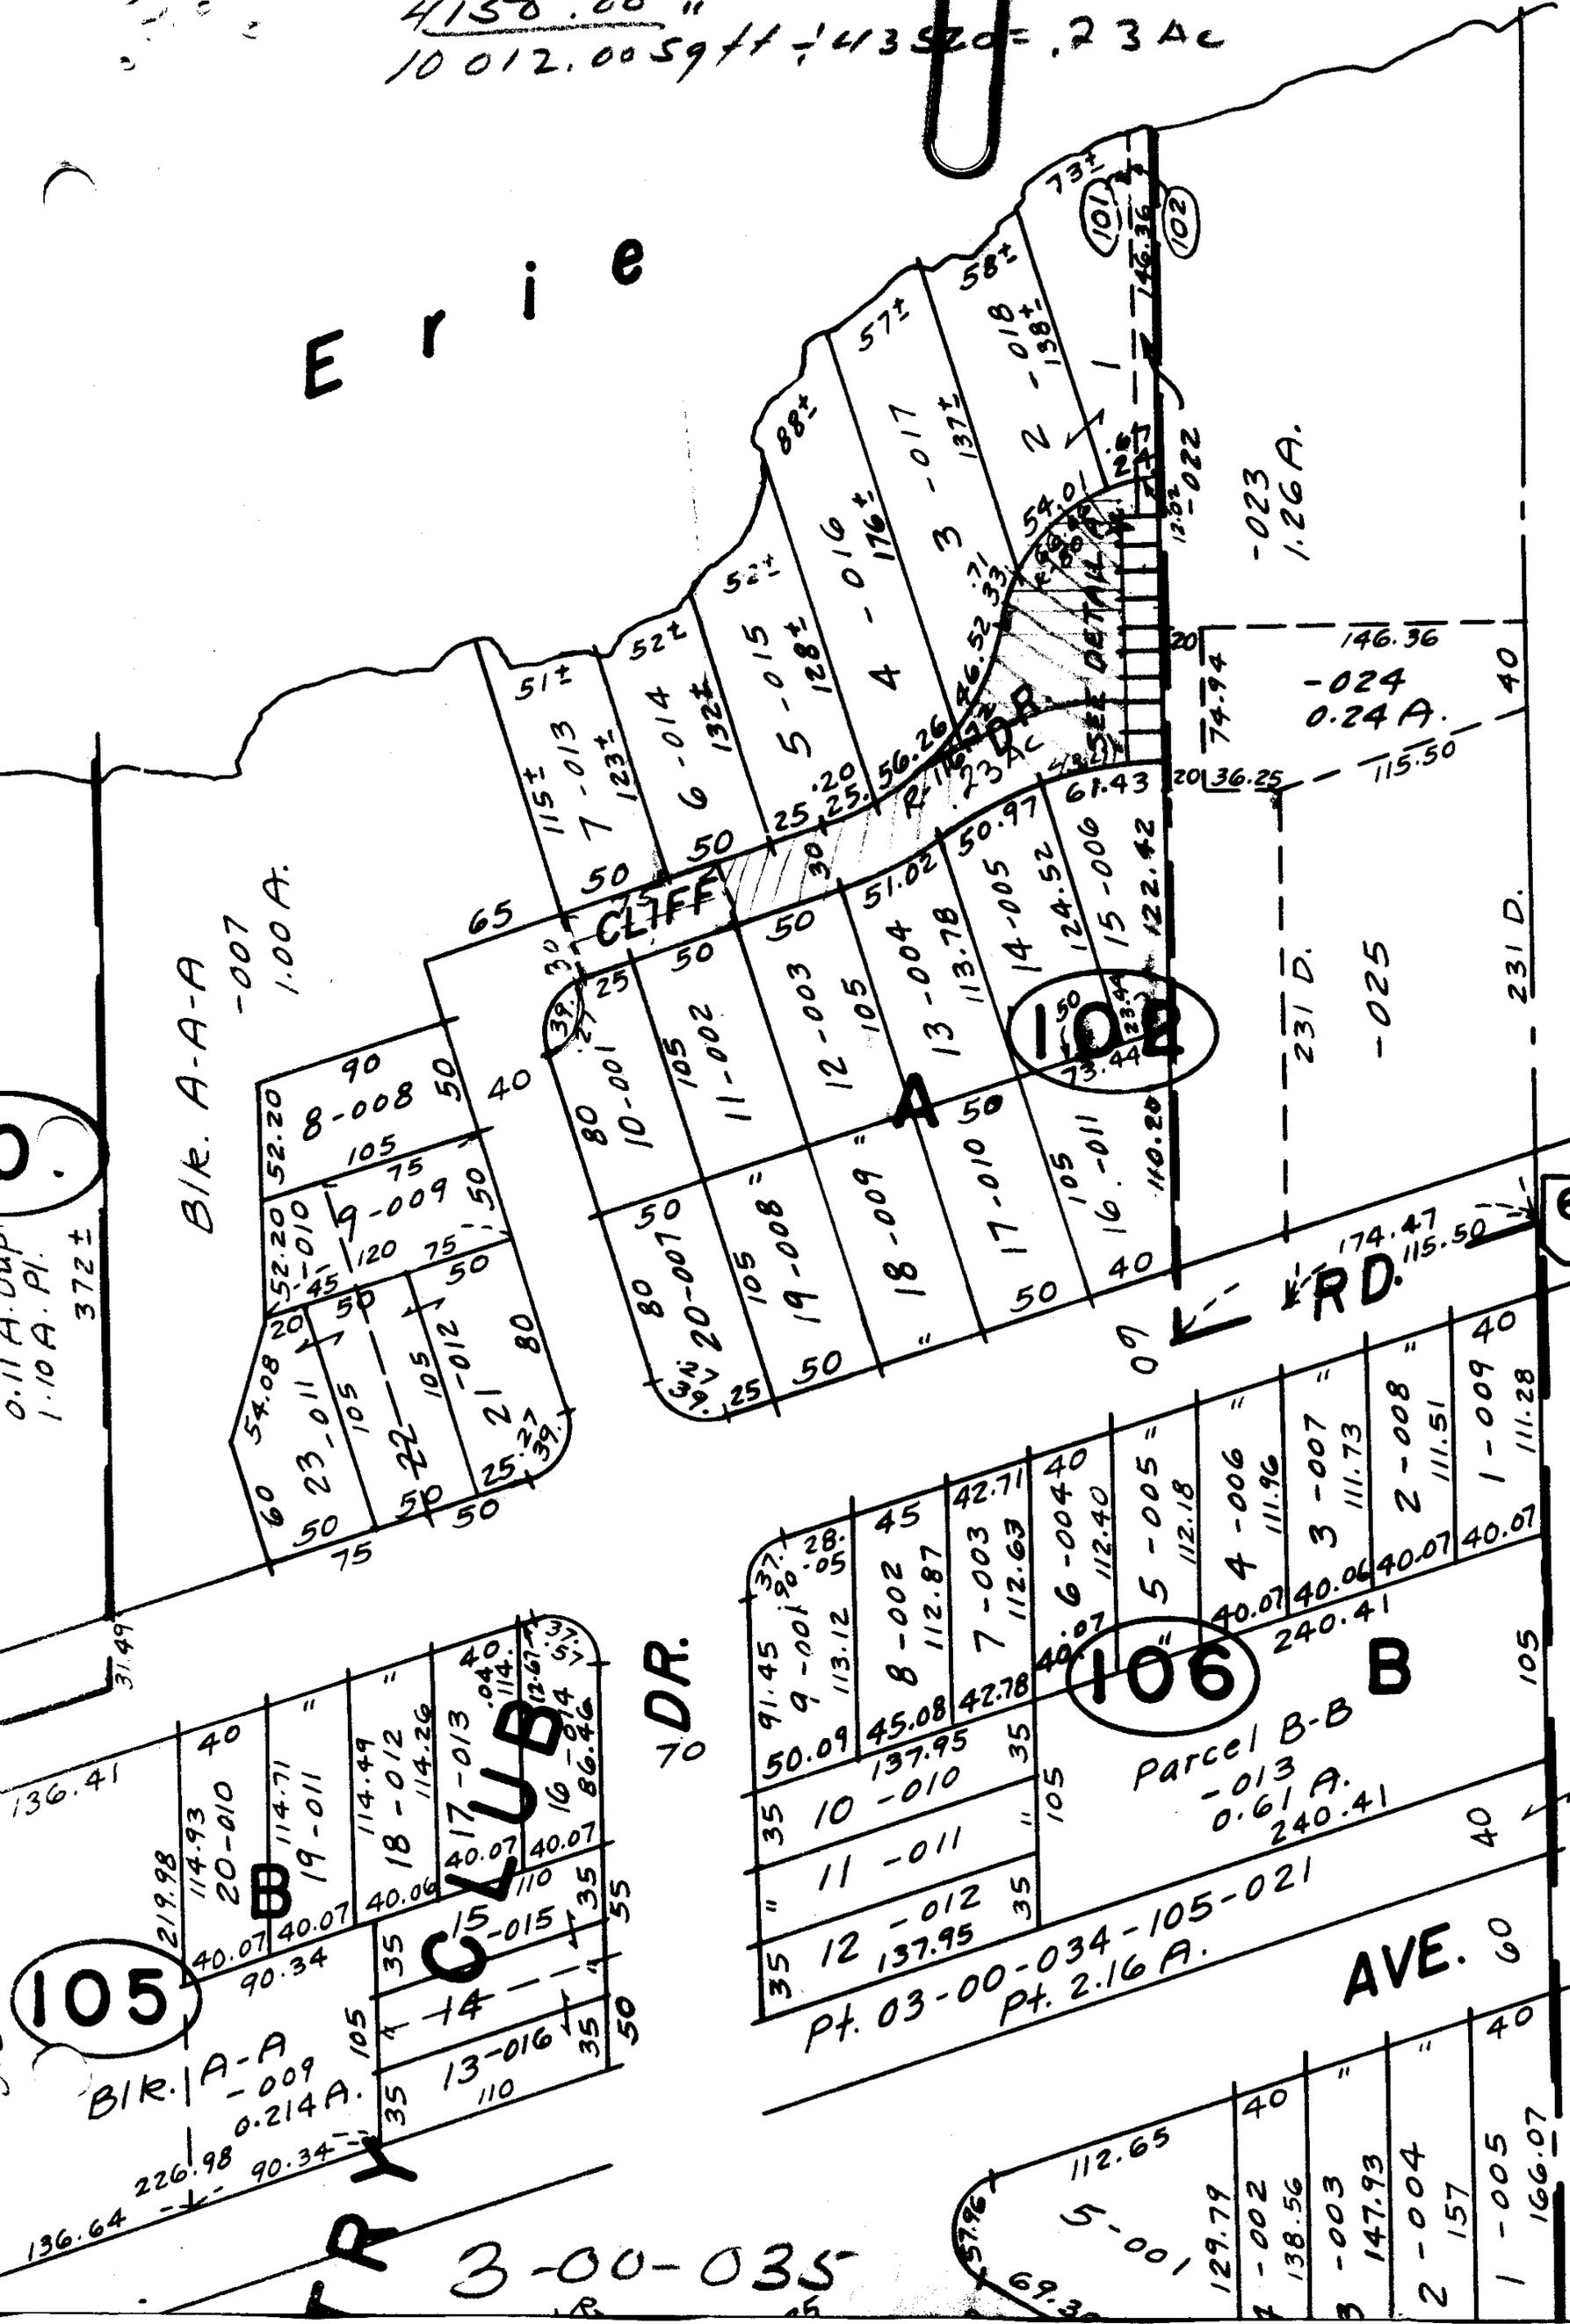

DETAIL A
SCALE 1" = 50'

12	18.60
11	17.02
10	15.44
9	13.86
8	12.28
7	10.70
6	9.12
5	7.54
4	5.96
3	4.38
2	2.80
1	1.22

SEE 3-00-034-A

