

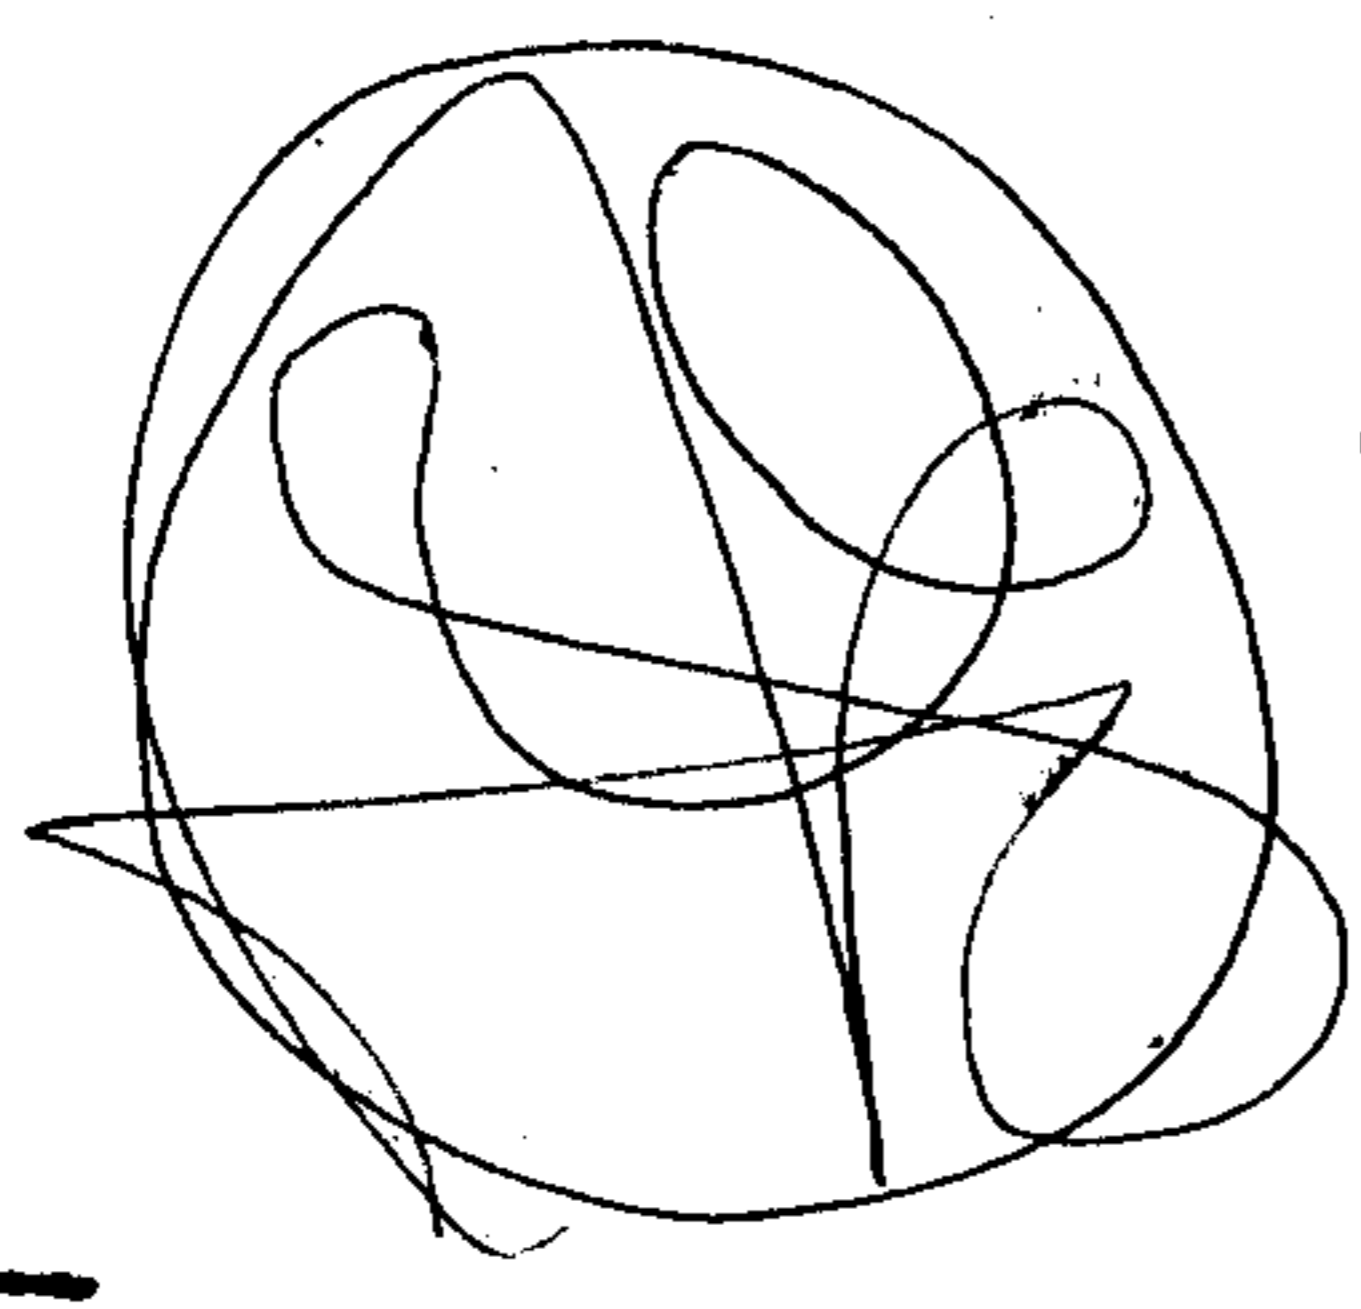


P.L. 100.1711

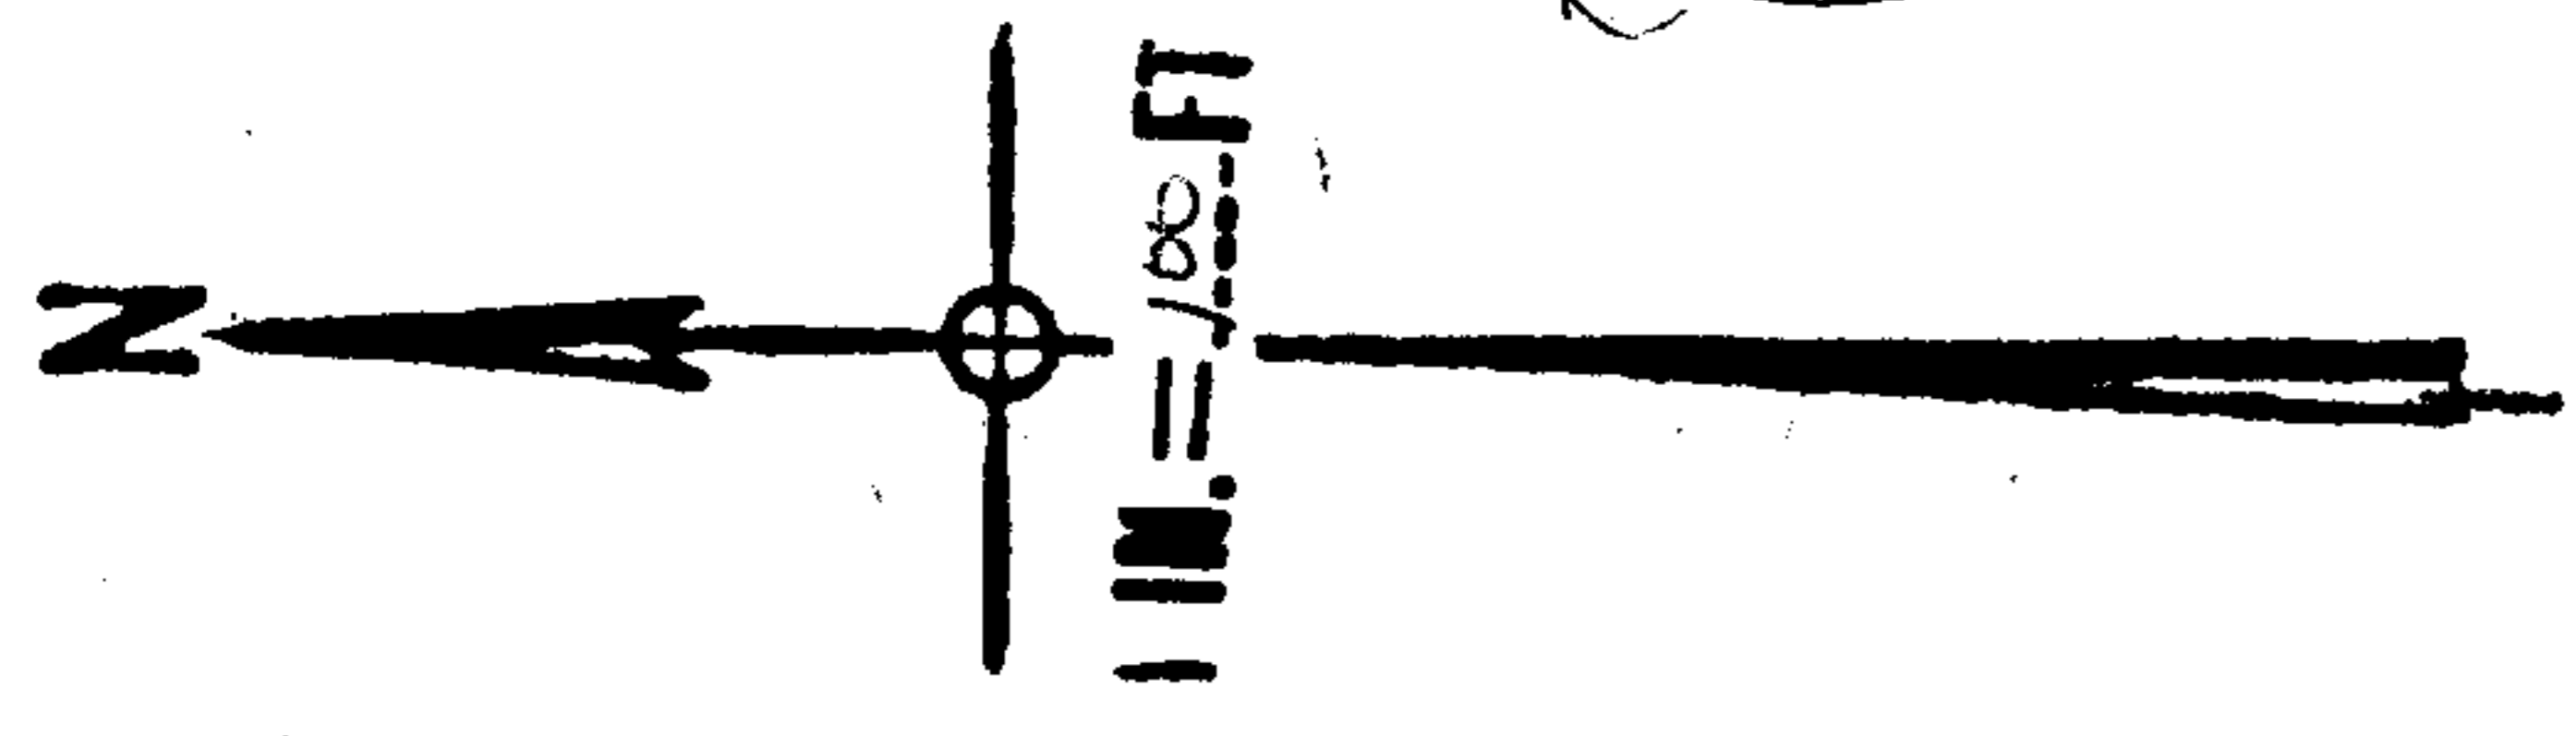

2762

APPROVED
 LORAIN CO.
 MAP DEPT.
 DATE 6-6-69
 BY *H. G. ...*

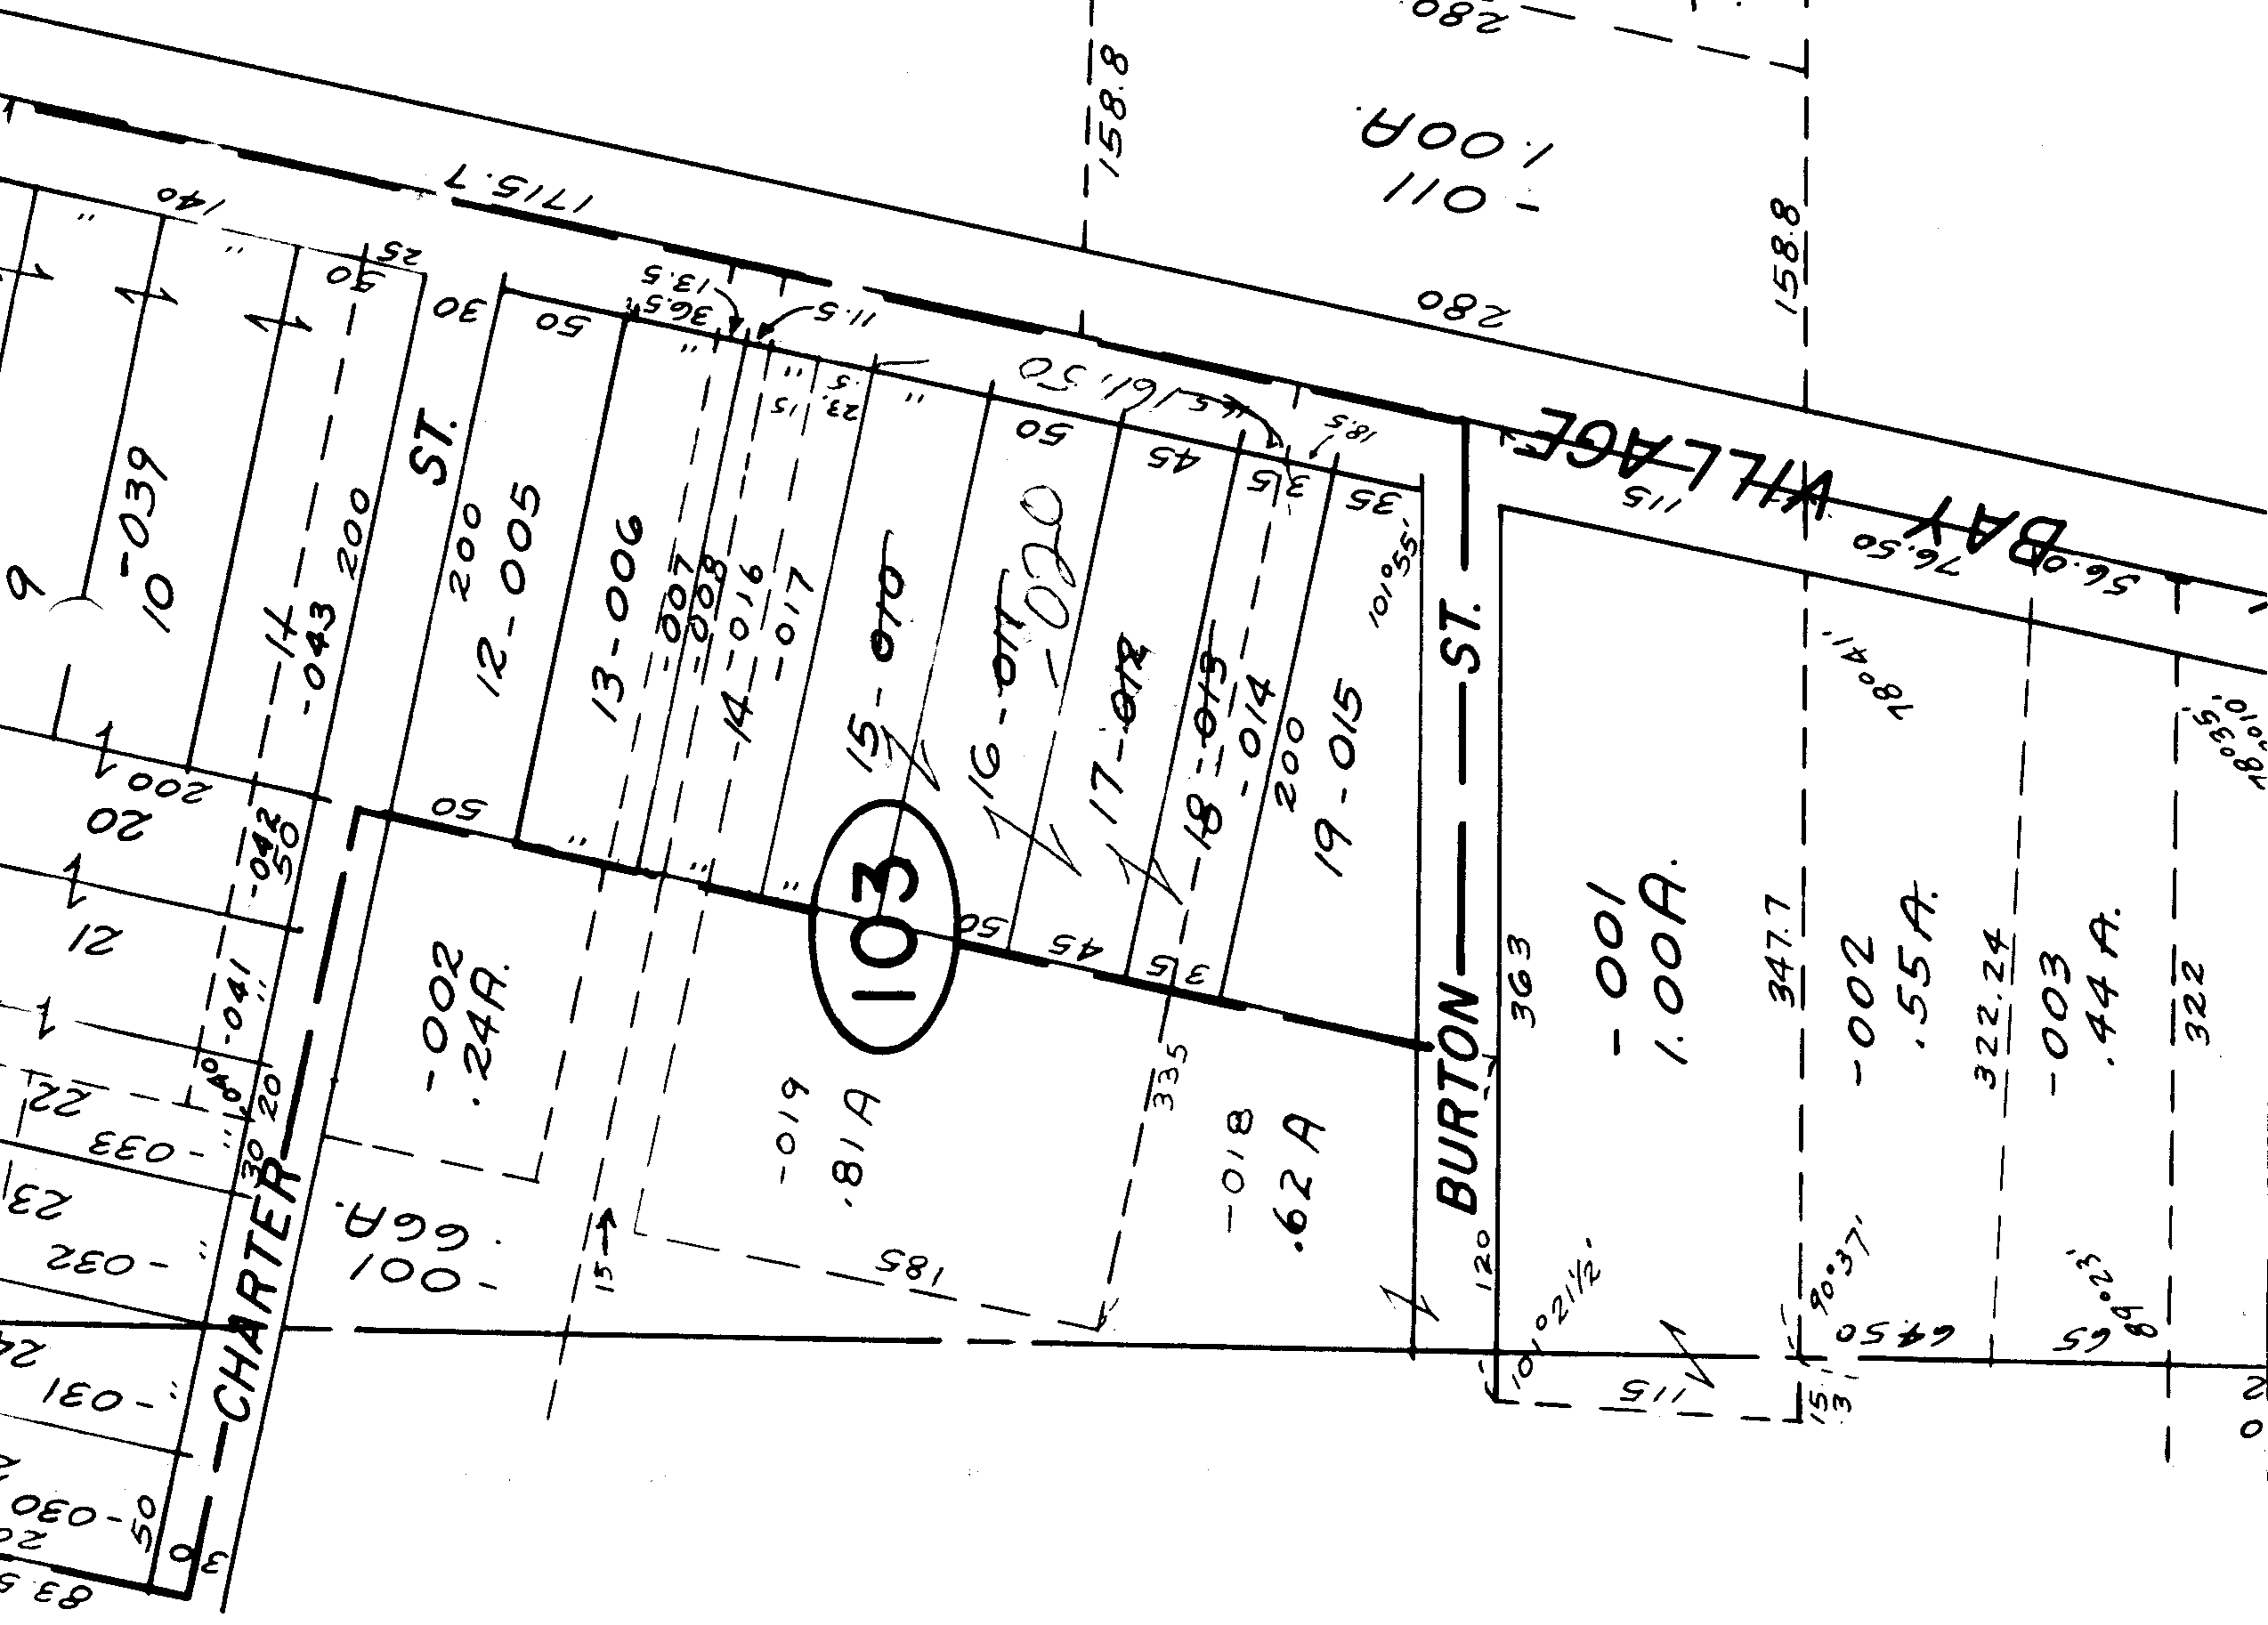

JUN 16 1969