

#2770

-016
11.28A.

-010
0.69A.

101

412.82

-011

018 34

300

-012
0.88A.


-019

~~013~~

~~2.43A.~~

2.09A.

203
403

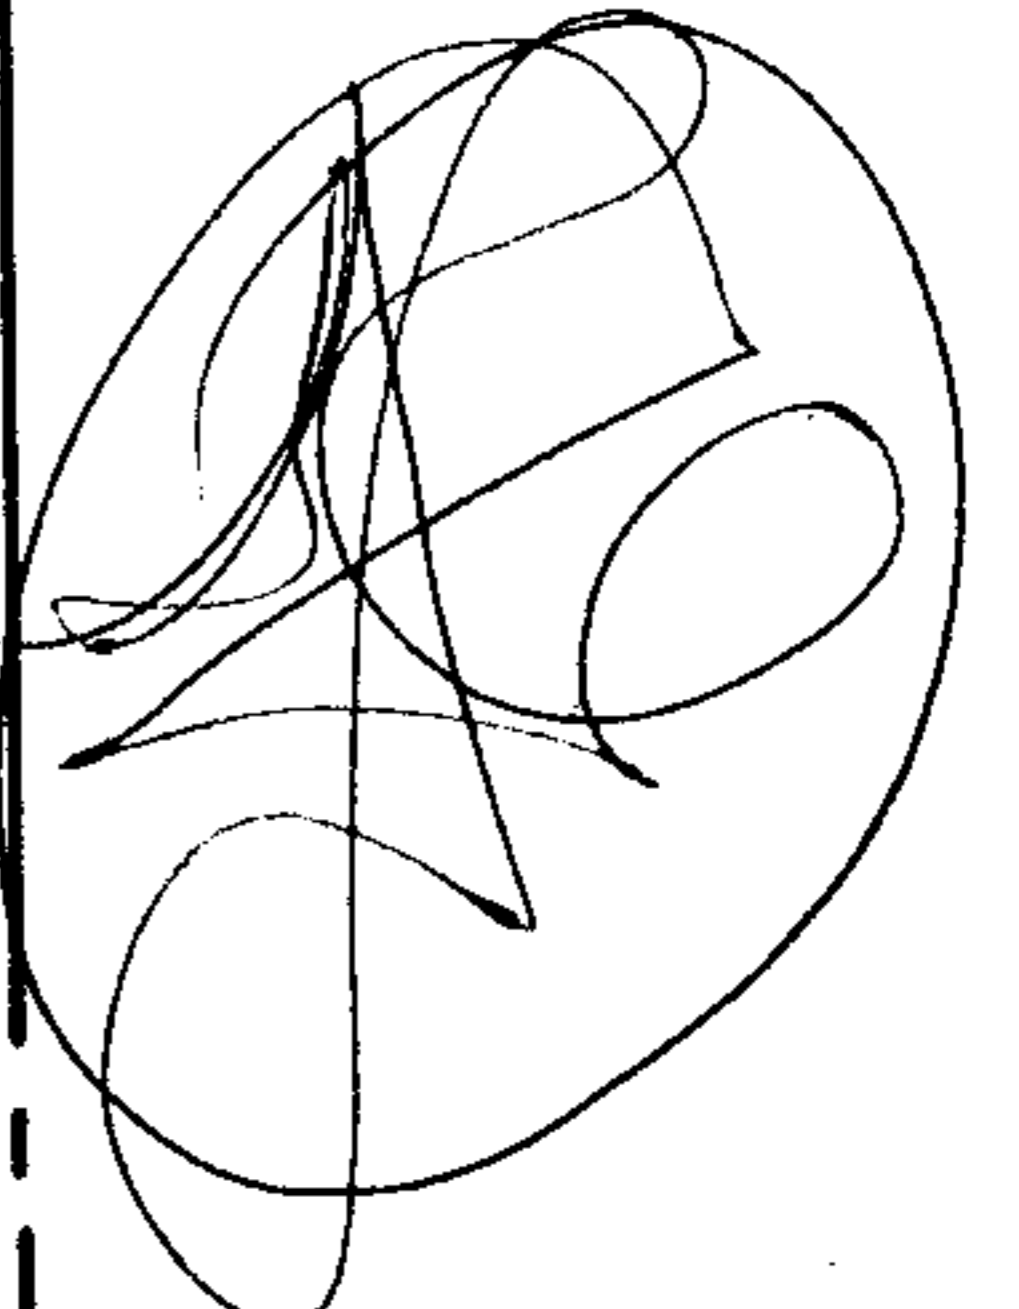

RD.

-015
0.24A.

7-15-86
SS

#2770
APPROVED
LORAIN CO.
MAP DEPT.
 DATE 6-9-69
 3-00-017B
 BY LW Hall

JUL 24 1969

5/30

E 3-00-007-A

3-00-017B

611

