



-041
27 27A

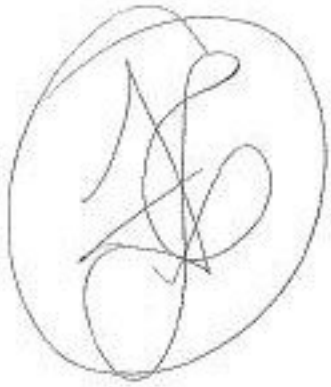


APPROVED
LORAIN CO.
MAP DEPT.
DATE 6/2/64
12-00-063-B
BY Paul Kelly

S.D.
7-25-64
2779

1964

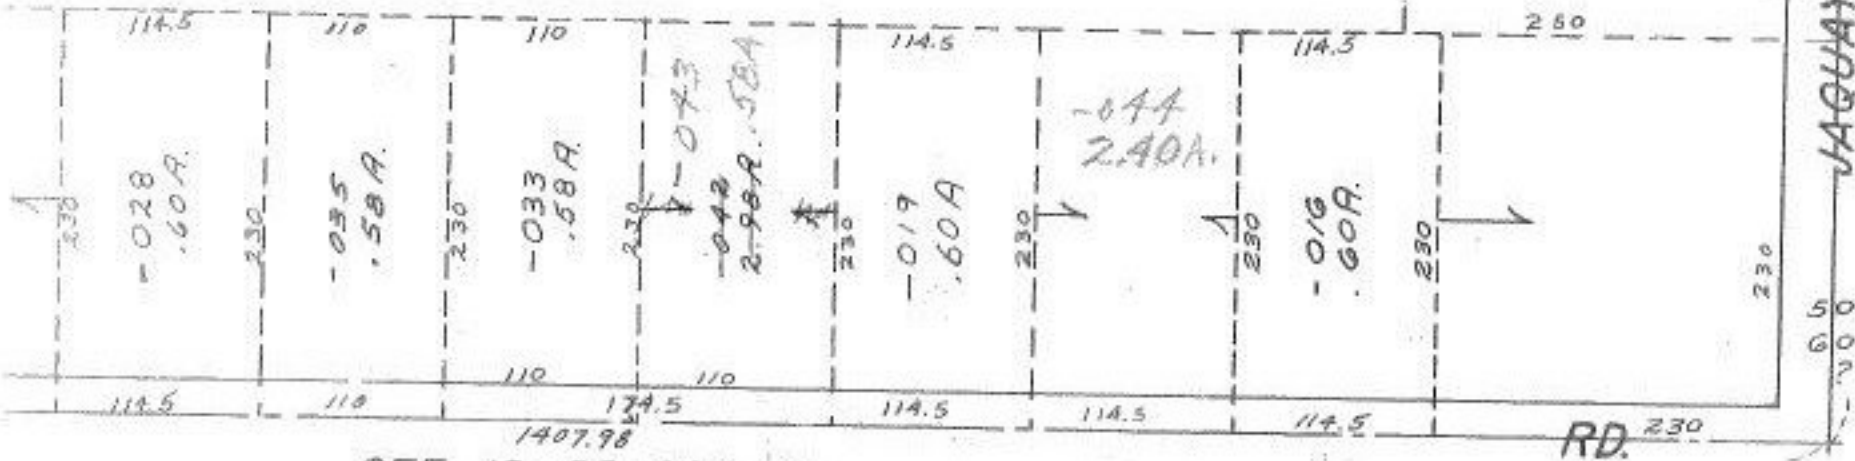

SEE 12-00-064-B

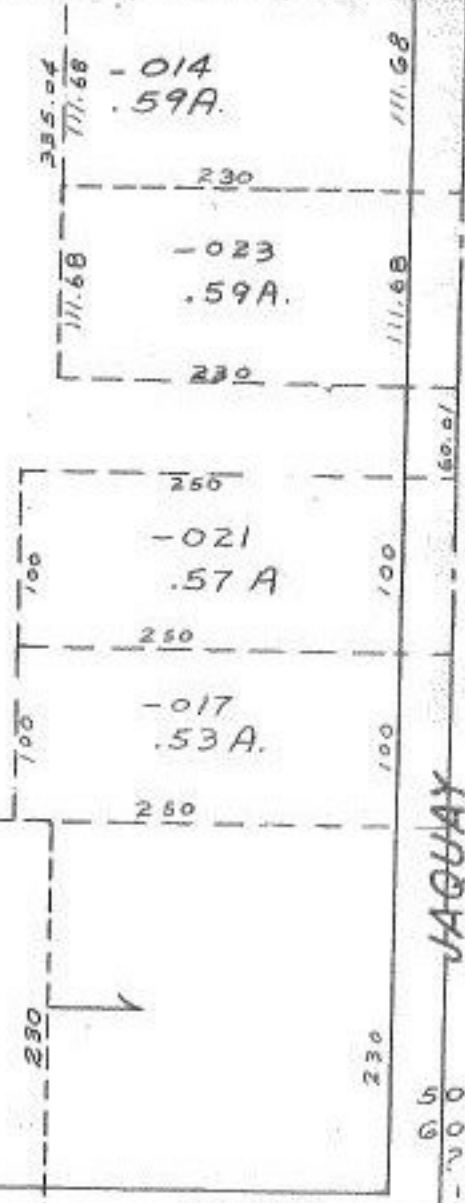

RD. 230