


(102)

425

2780



APPROVED
LORAIN CO.
M&P DEPT.
DATE 6/12/69
BY [Signature]

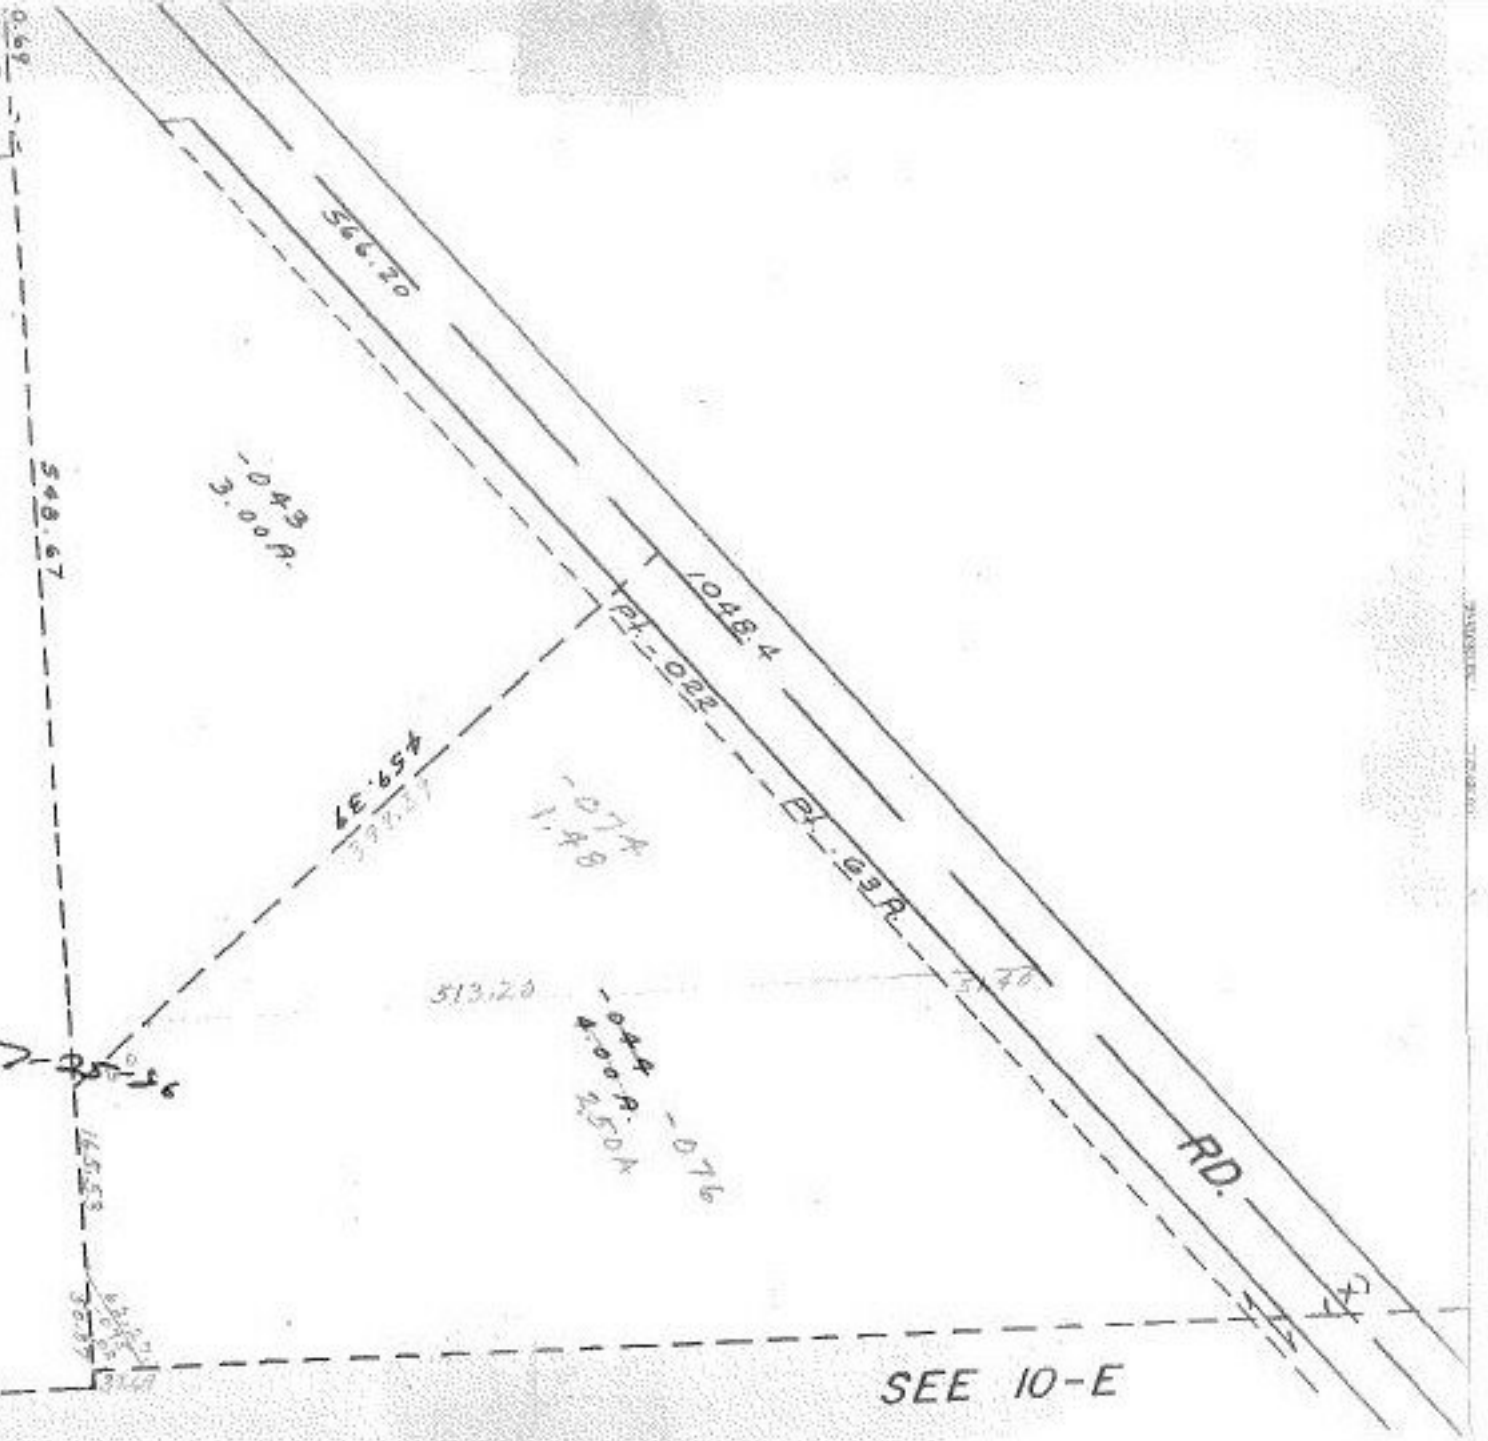

SEE 10-E