


JUN 19 1969

SEE 3-00-102-A

Map Page 3-00-102-B

MAP CORRECTION

Pt. 010
Pt. 11.39A.

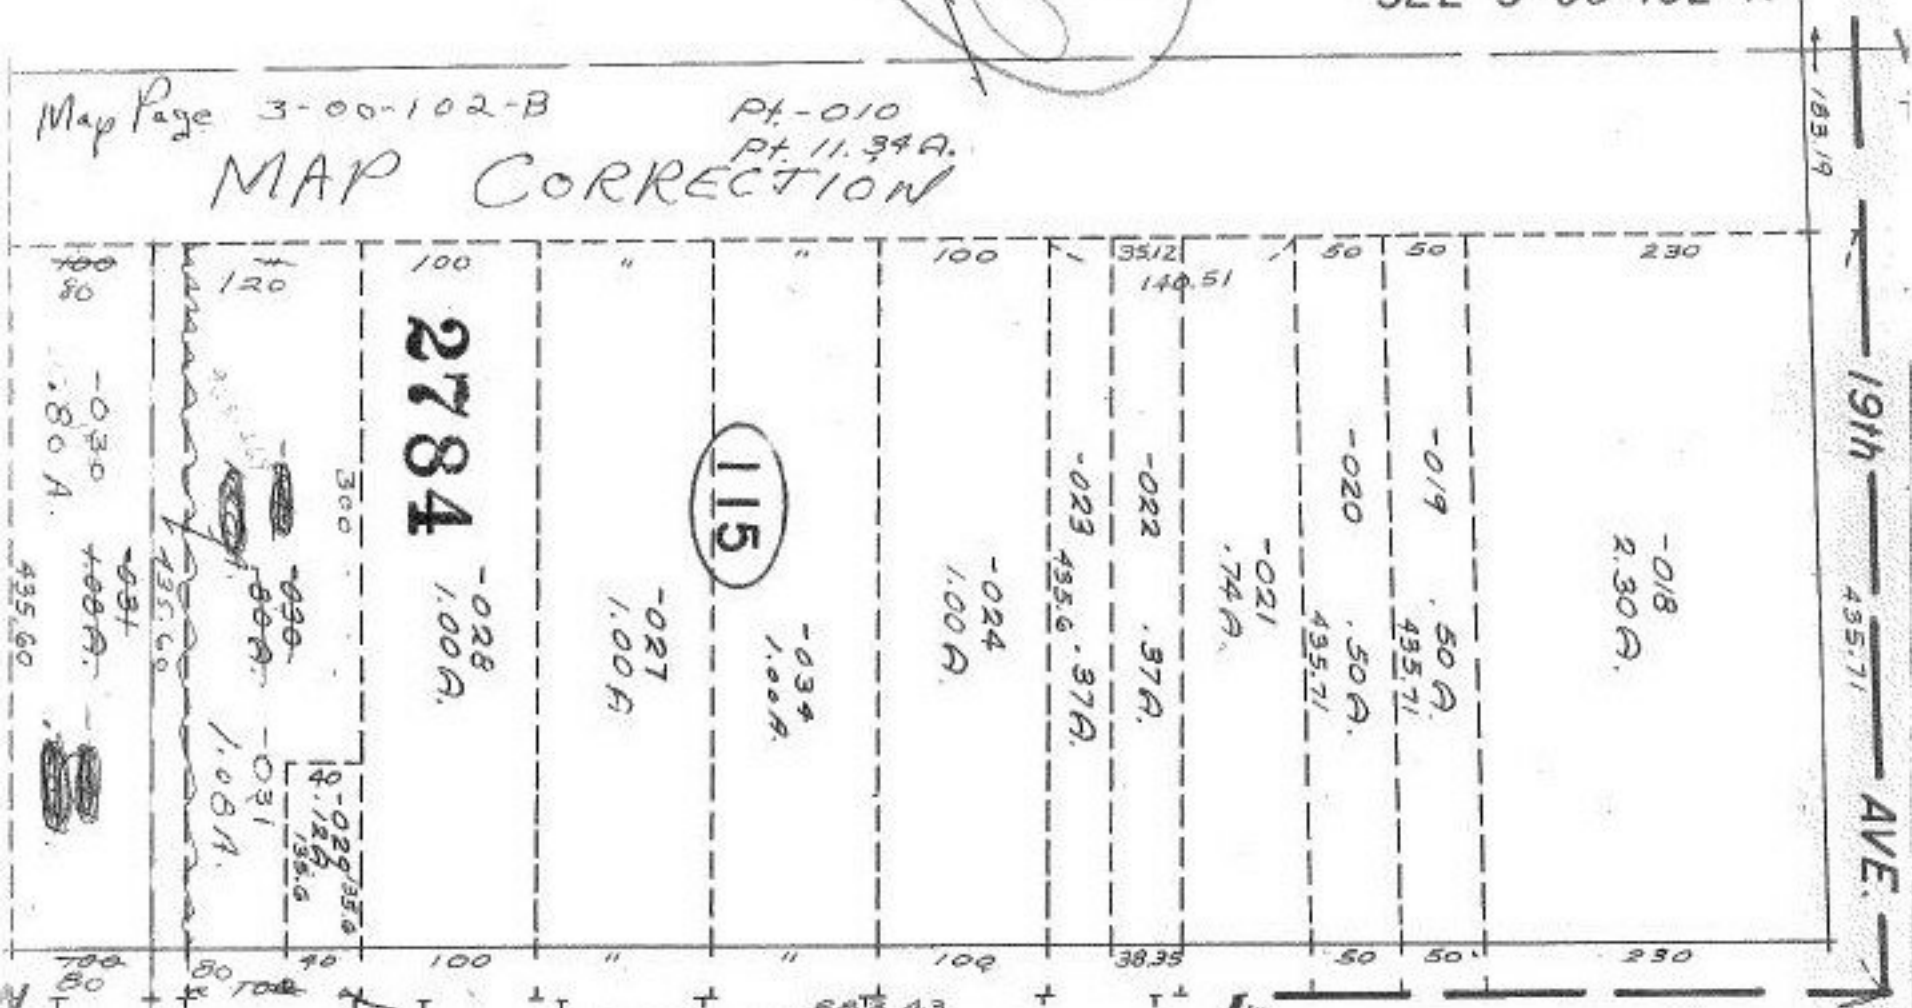

183.19
19th
435.71
AVE.

83.62 91.34 883.43 101.73

37	105	105	37
4247-001	4246-006	4235-001	
4248-002	4245-007	4236-002	
4249-003	4244-008	4237-003	

20th

120
150
180
210
240
270
300

115

2784

20th

100
80
-030
+00A.
435.60

120
-030
+00A.
435.60

100
-028
1.00A.

"
-027
1.00A.

"
-034
1.00A.

100
-024
1.00A.

35/2
140.51
-022
.37A.
-023
435.6
.37A.

50
-021
.74A.
-020
.50A.
435.71

50
-019
.50A.
435.71

230
-018
2.30A.

100
80
-020
.34A.

80
-019
.42A.

100
-018
250

"
-016
.38A.

100
-016
.38A.

100
-016
.38A.

38.35
-022
.37A.

50
-020
.50A.
435.71

50
-019
.50A.
435.71

230
-018
2.30A.