

CARLISLE TWP

AUG 1 1969

SEE 10-00-008-6

APPROVED
LORAIN CO.
MAP DEPT.
DATE 6-19-69
10-00-008C
BY L. W. HALL

#2803
 323
 8.8
 7-25-66

Pt. -033
Pt. 26.41R

N


-032
90R

-031
2.69R

221
-038
422Ac

~~4.19R~~
-039
4.07R

114

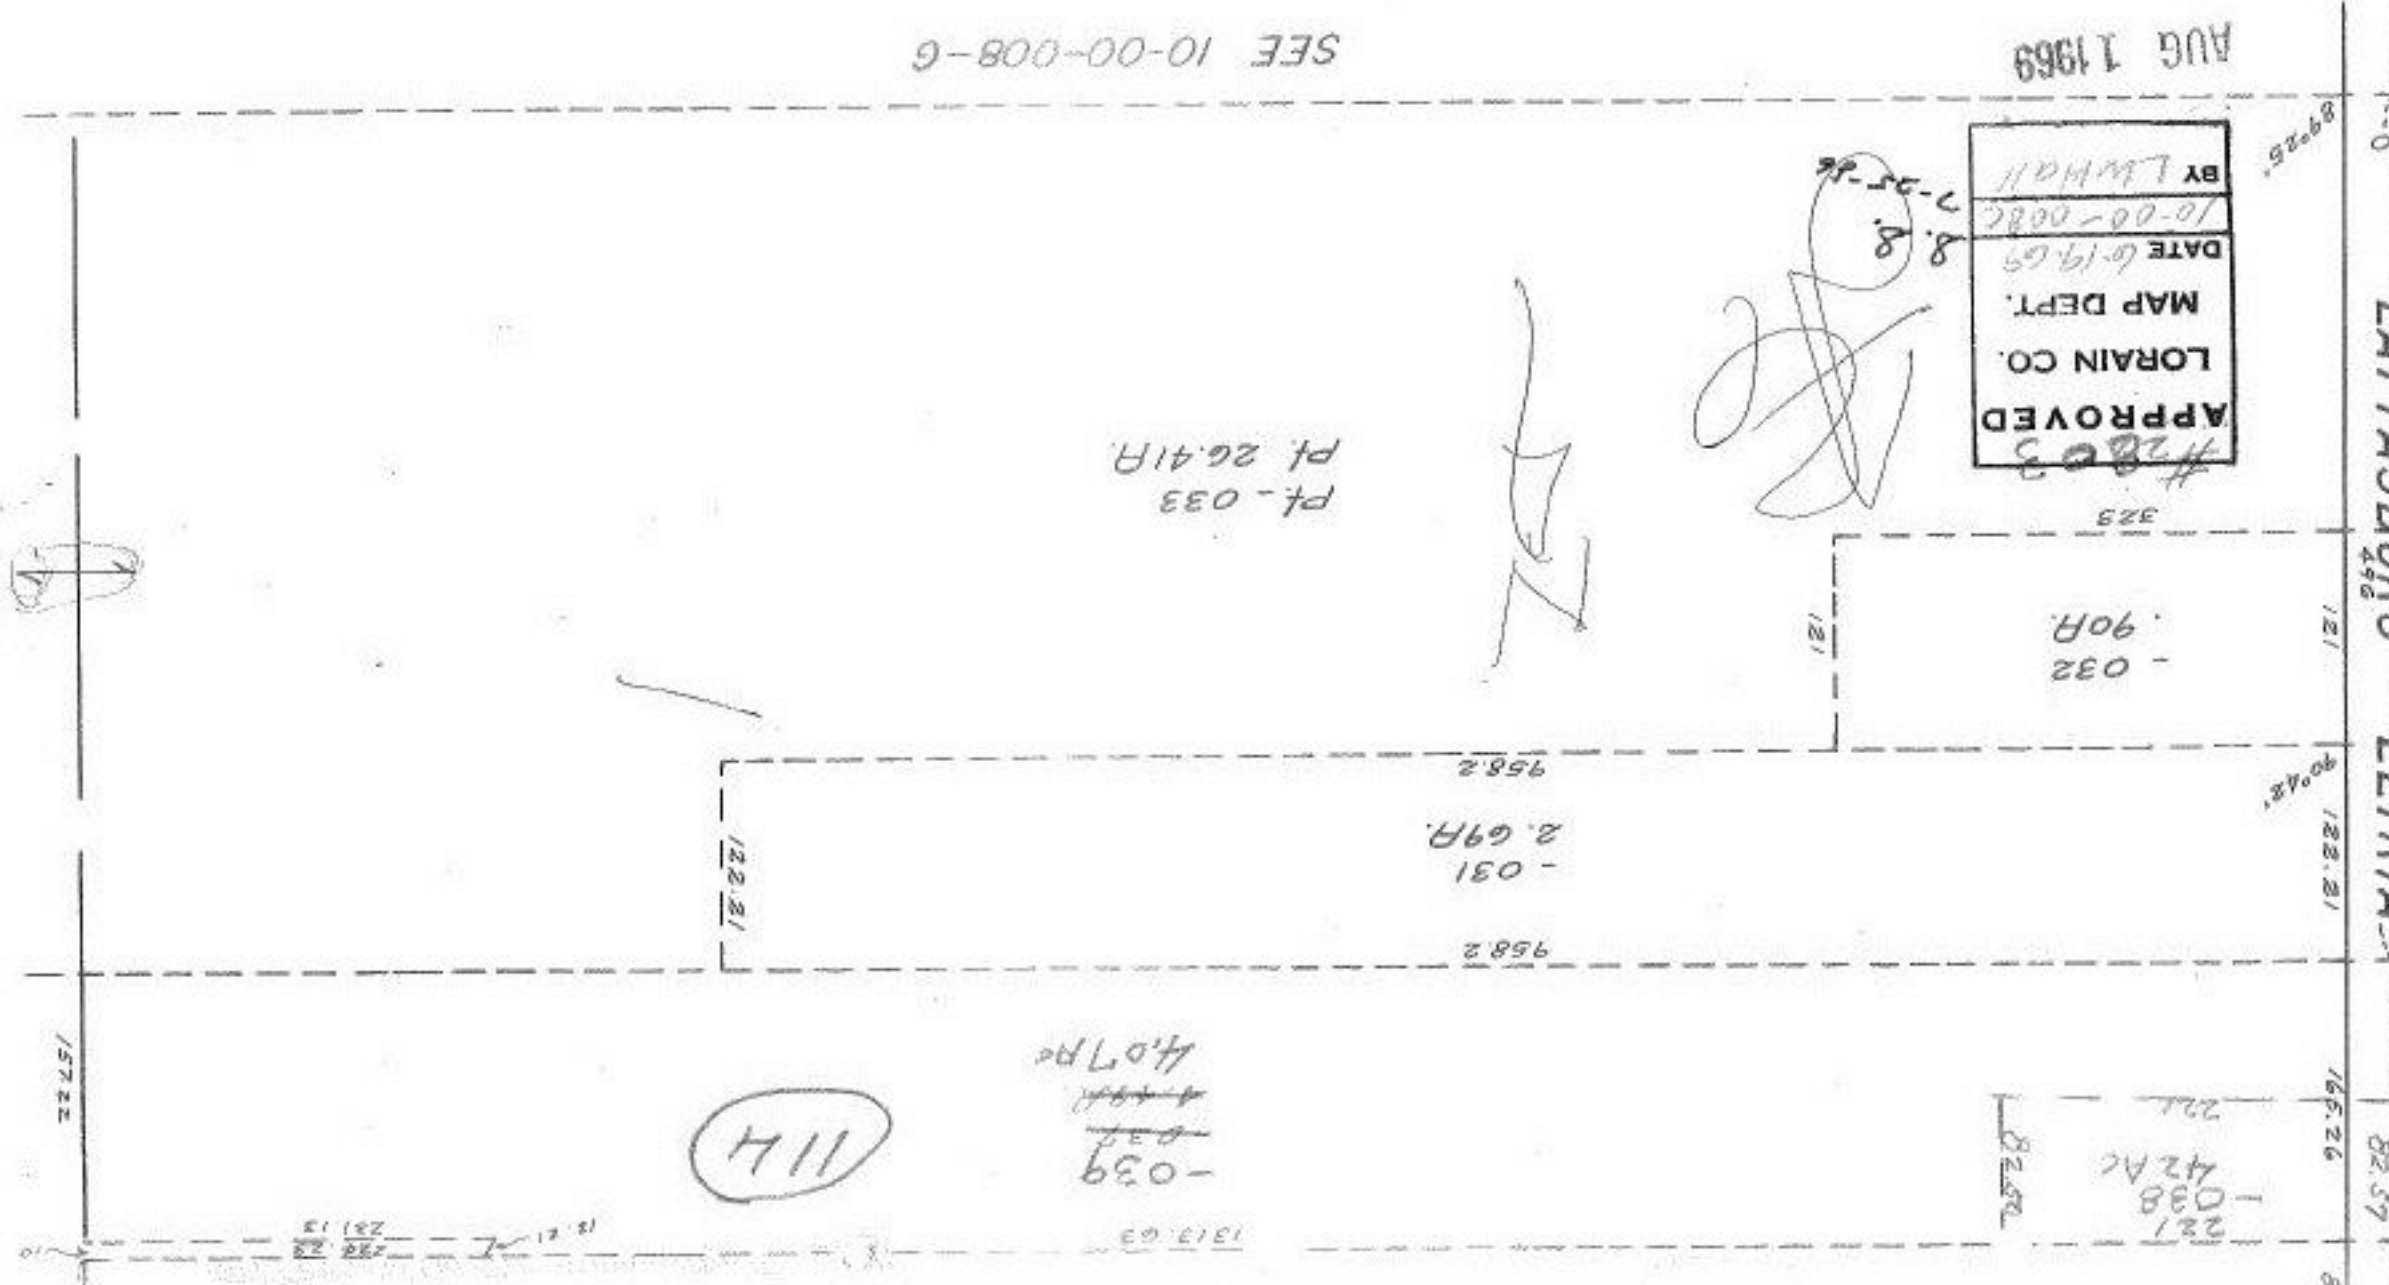

LATASBURG - ELYRIA