

SEE 16-00-015-A

924.48

2.03 ~~GRAFTON~~ ~~EASTERN~~

100

462.46

001
100 A. Dup.
75 A. Pl.

1.035 A.

450.20
- 010

451.36

008

1.97 A

- 012
4.75 A.

462.33

100

190

AUG 4 1969


Corrected

- 013
- 014

22.49 A.
17.74



APPROVED
LORAIN CO.
MAP DEPT.
DATE 8/18/69
BY R.W. Kellogg

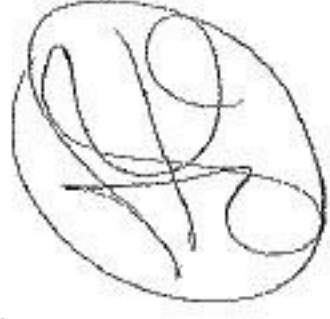

AUG 21 1969

APPROVED
LORAIN CO.
MAP DEPT.
DATE 7/10/69
BY B.K. ...

2867

17-25-80