
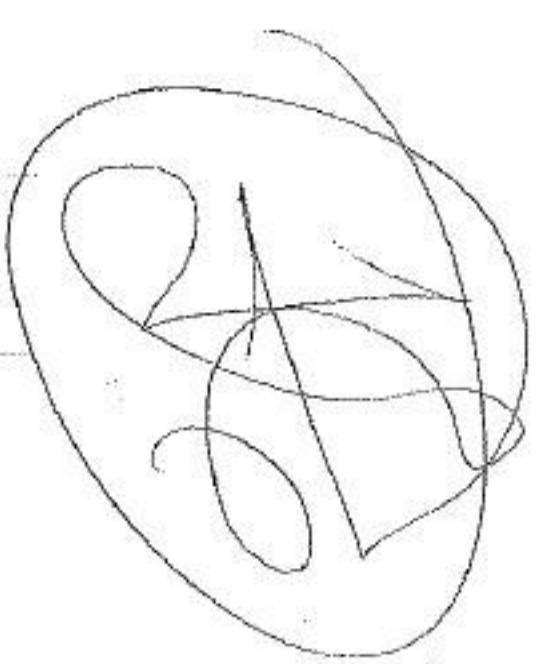


SEE 5-00-040-A

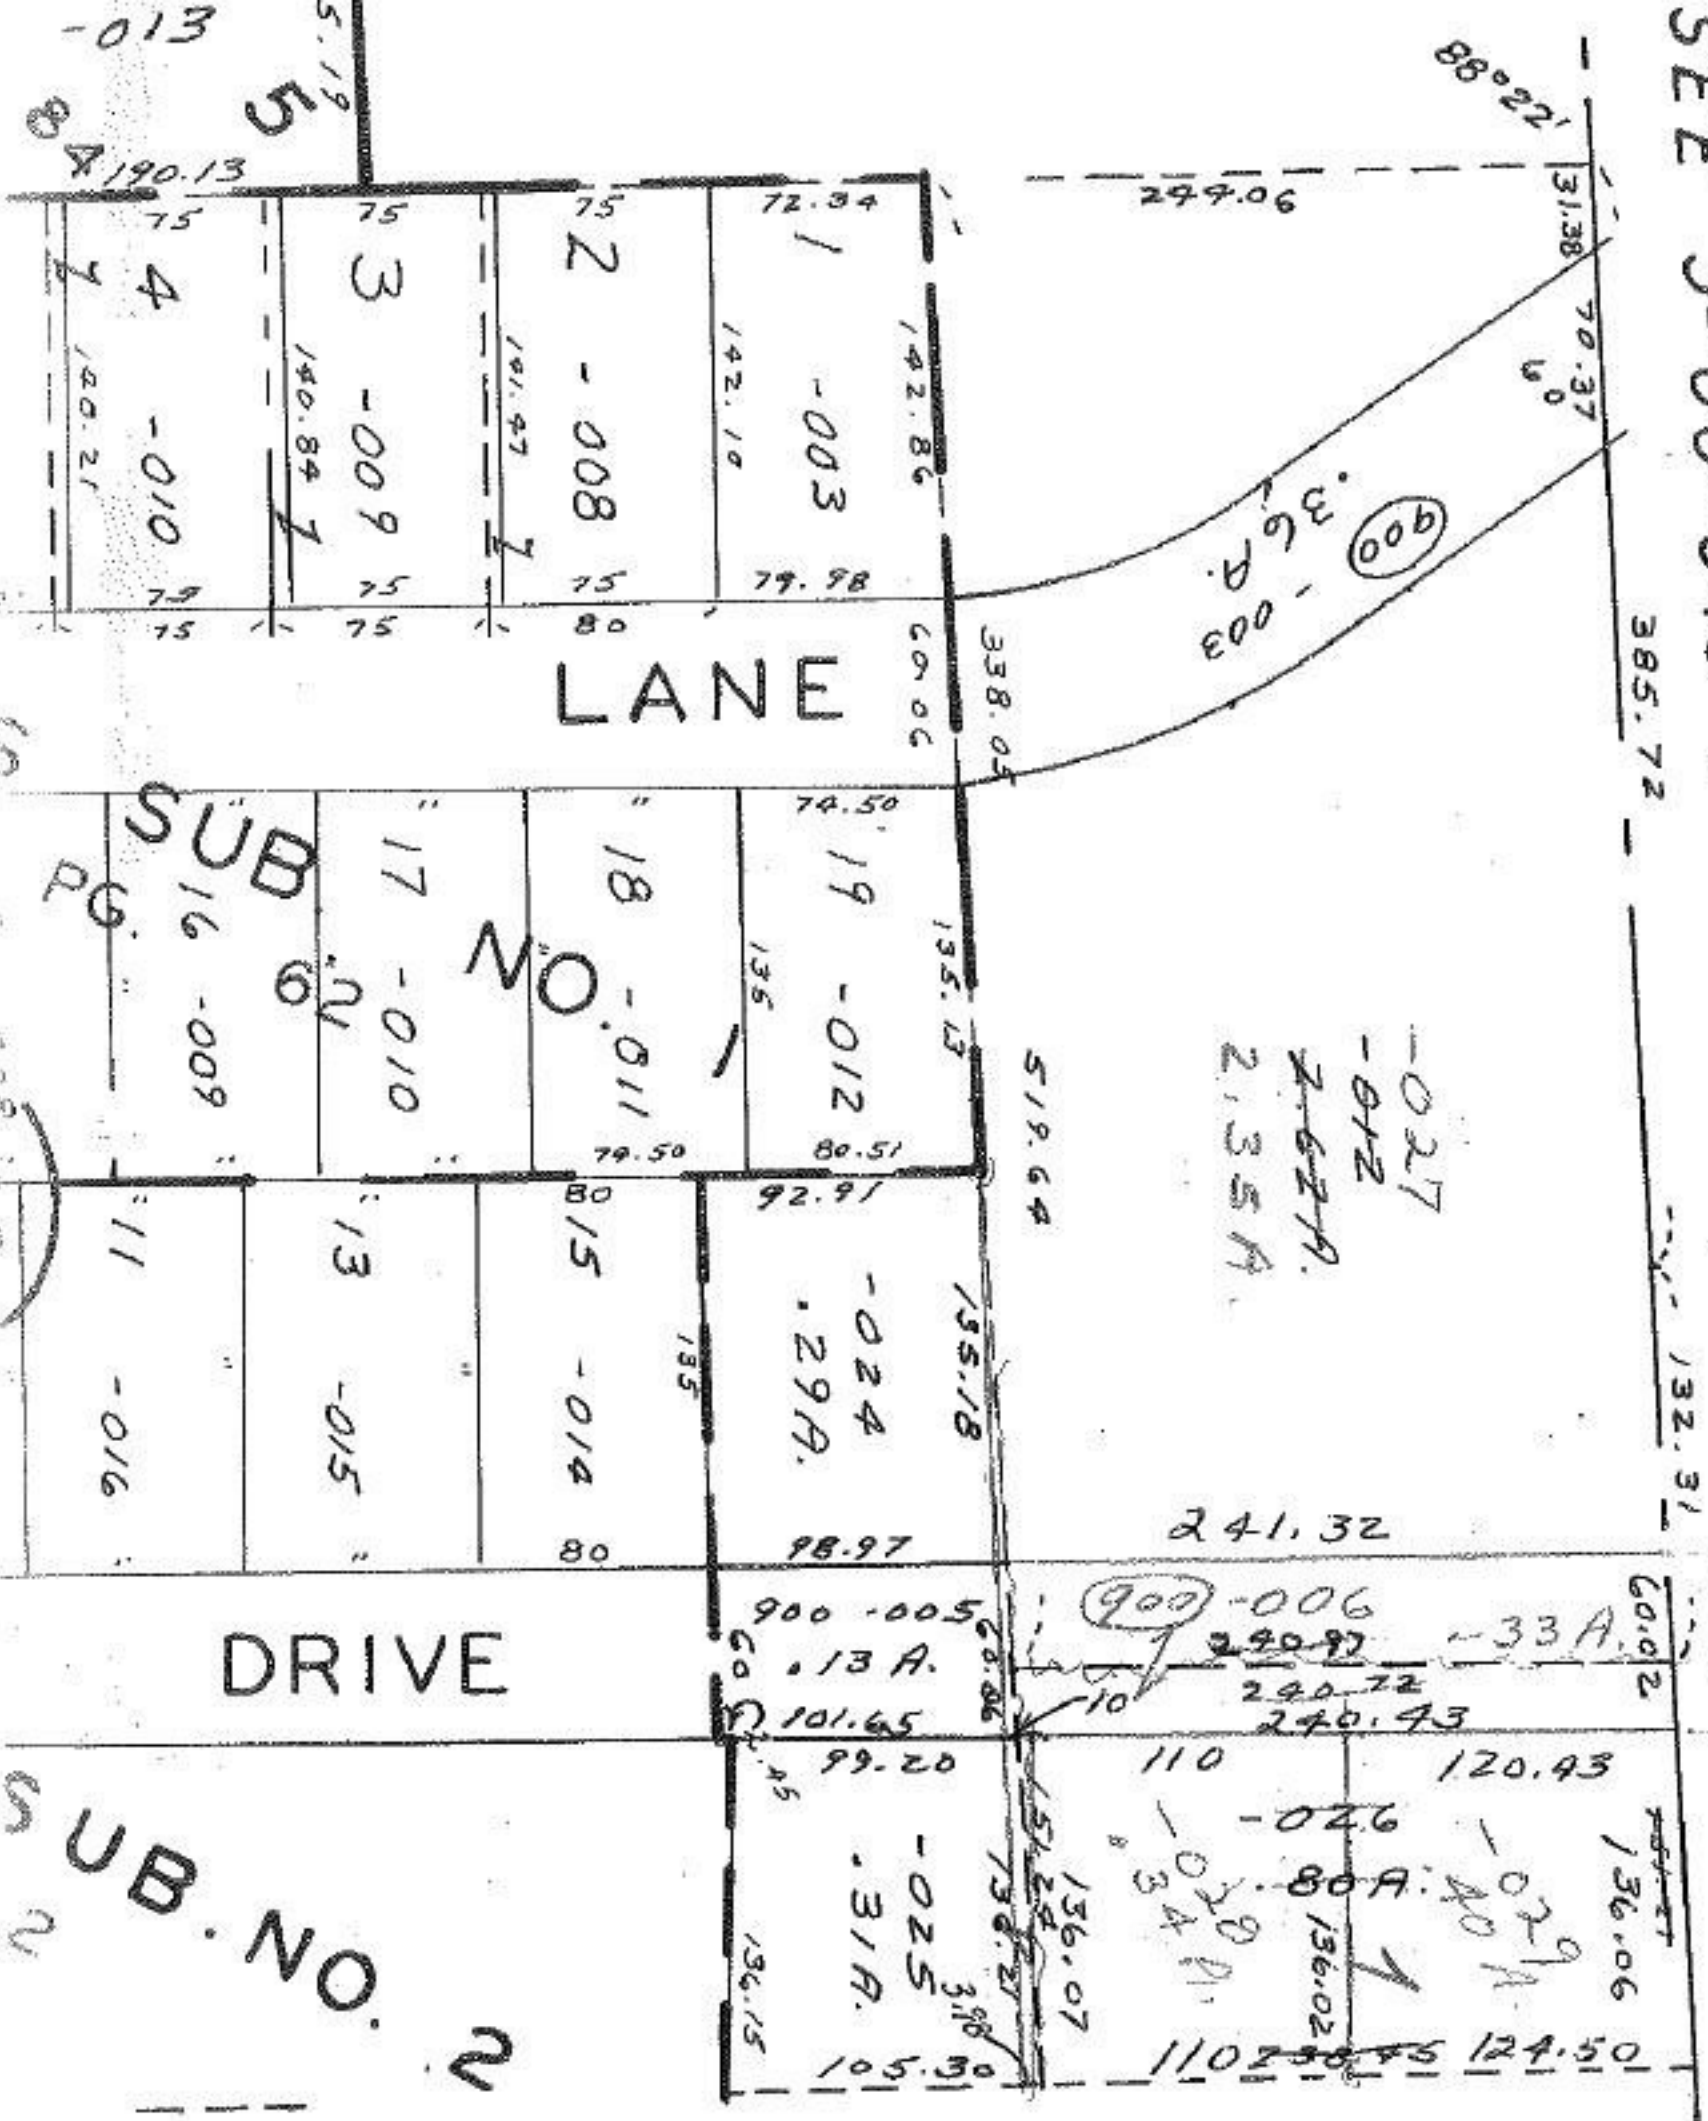

2873

APPROVED
 LORAIN CO.
 MAP DEPT.
 DATE 7-15-69
 5-00-039-A
 BY *[Signature]*

AUG 4 1969

7-16-69 K.L.