


SEE 3-00-075-B

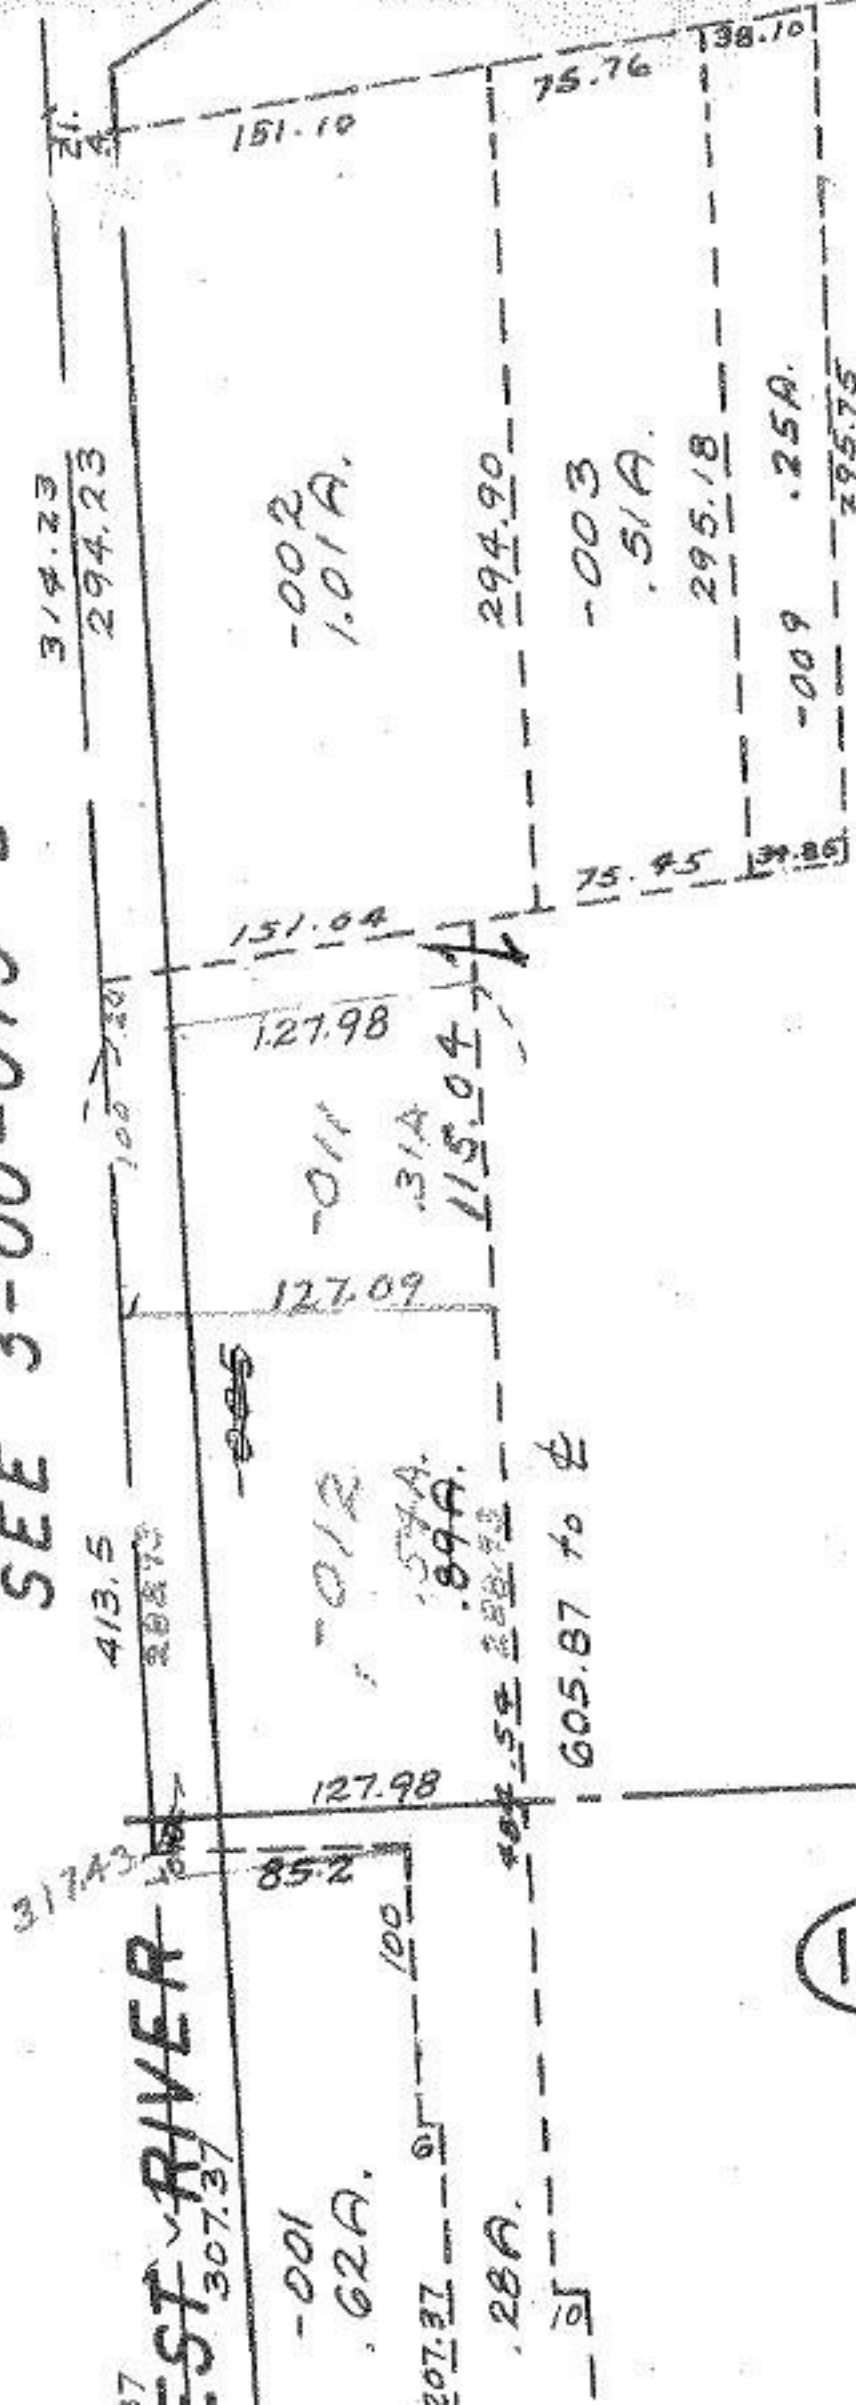

-010
8.90 A.

2882
APPROVED
LORAIN CO.
MAP DEPT.
 DATE 7/22/69
 Pg 3-00-075-C
 BY Red Kellan

SEP 4 1989

116

-004
2.11 A.

-003
.76 A.

Old