


Pt. -019
Pt. 5.63A.


-074 str trans.
-054 split

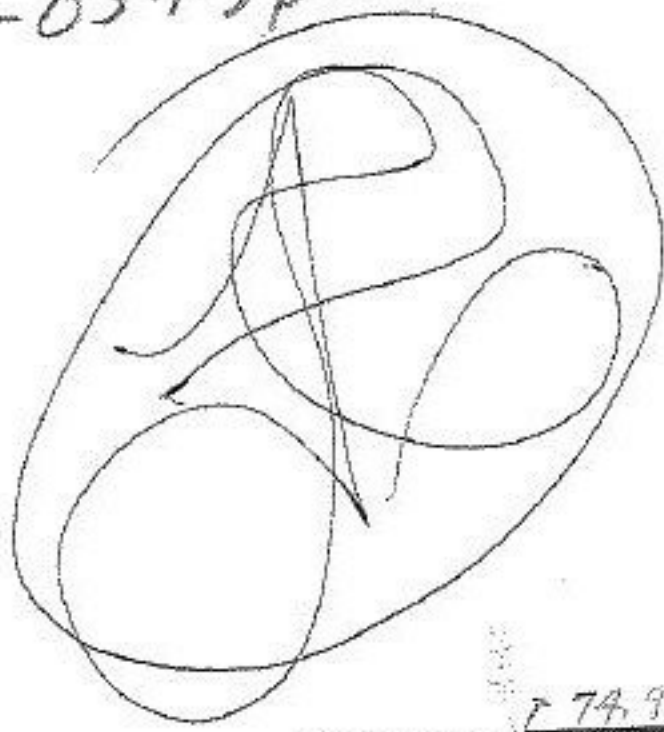

2896

APPROVED
LORAIN CO.
MAP DEPT.
DATE 7/25/69
R. 18-00-028-A
BY
R. J. K. [Signature]

AUG 18 1969 8-8.
7-25-86

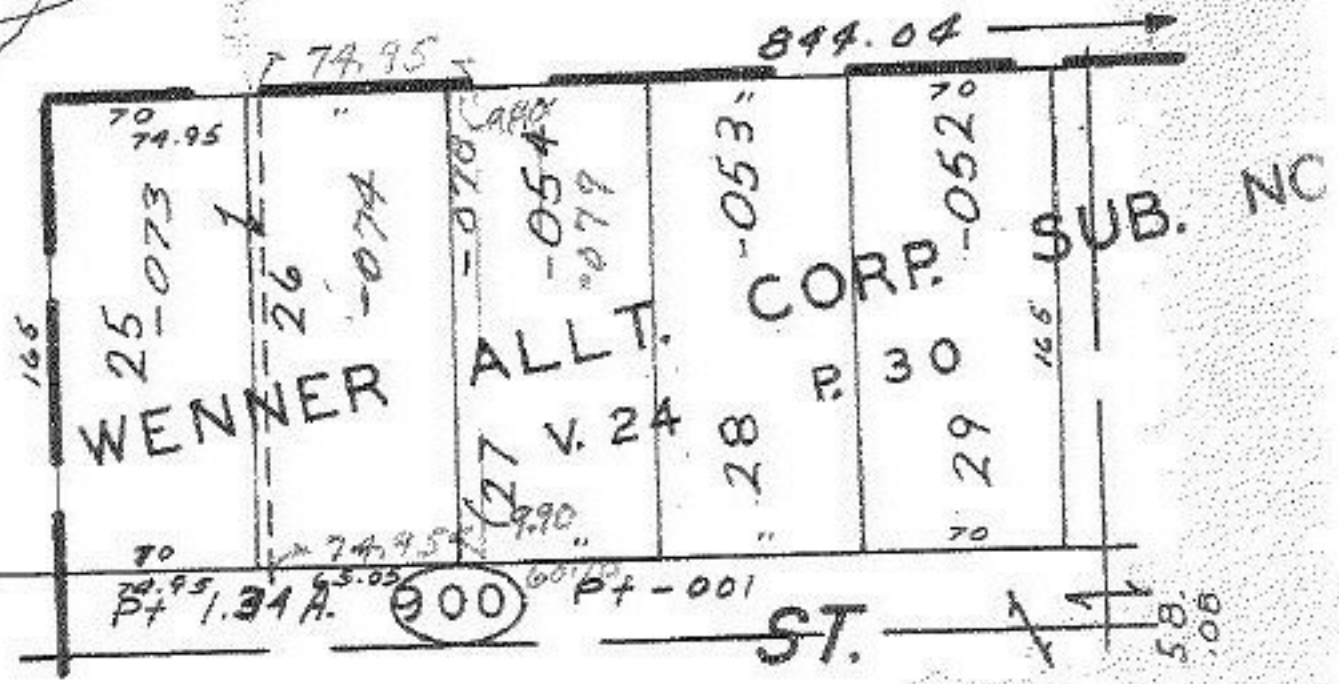

58.08
JONES

0-028-C

58.08