


LAKE SE

CLEVELAND

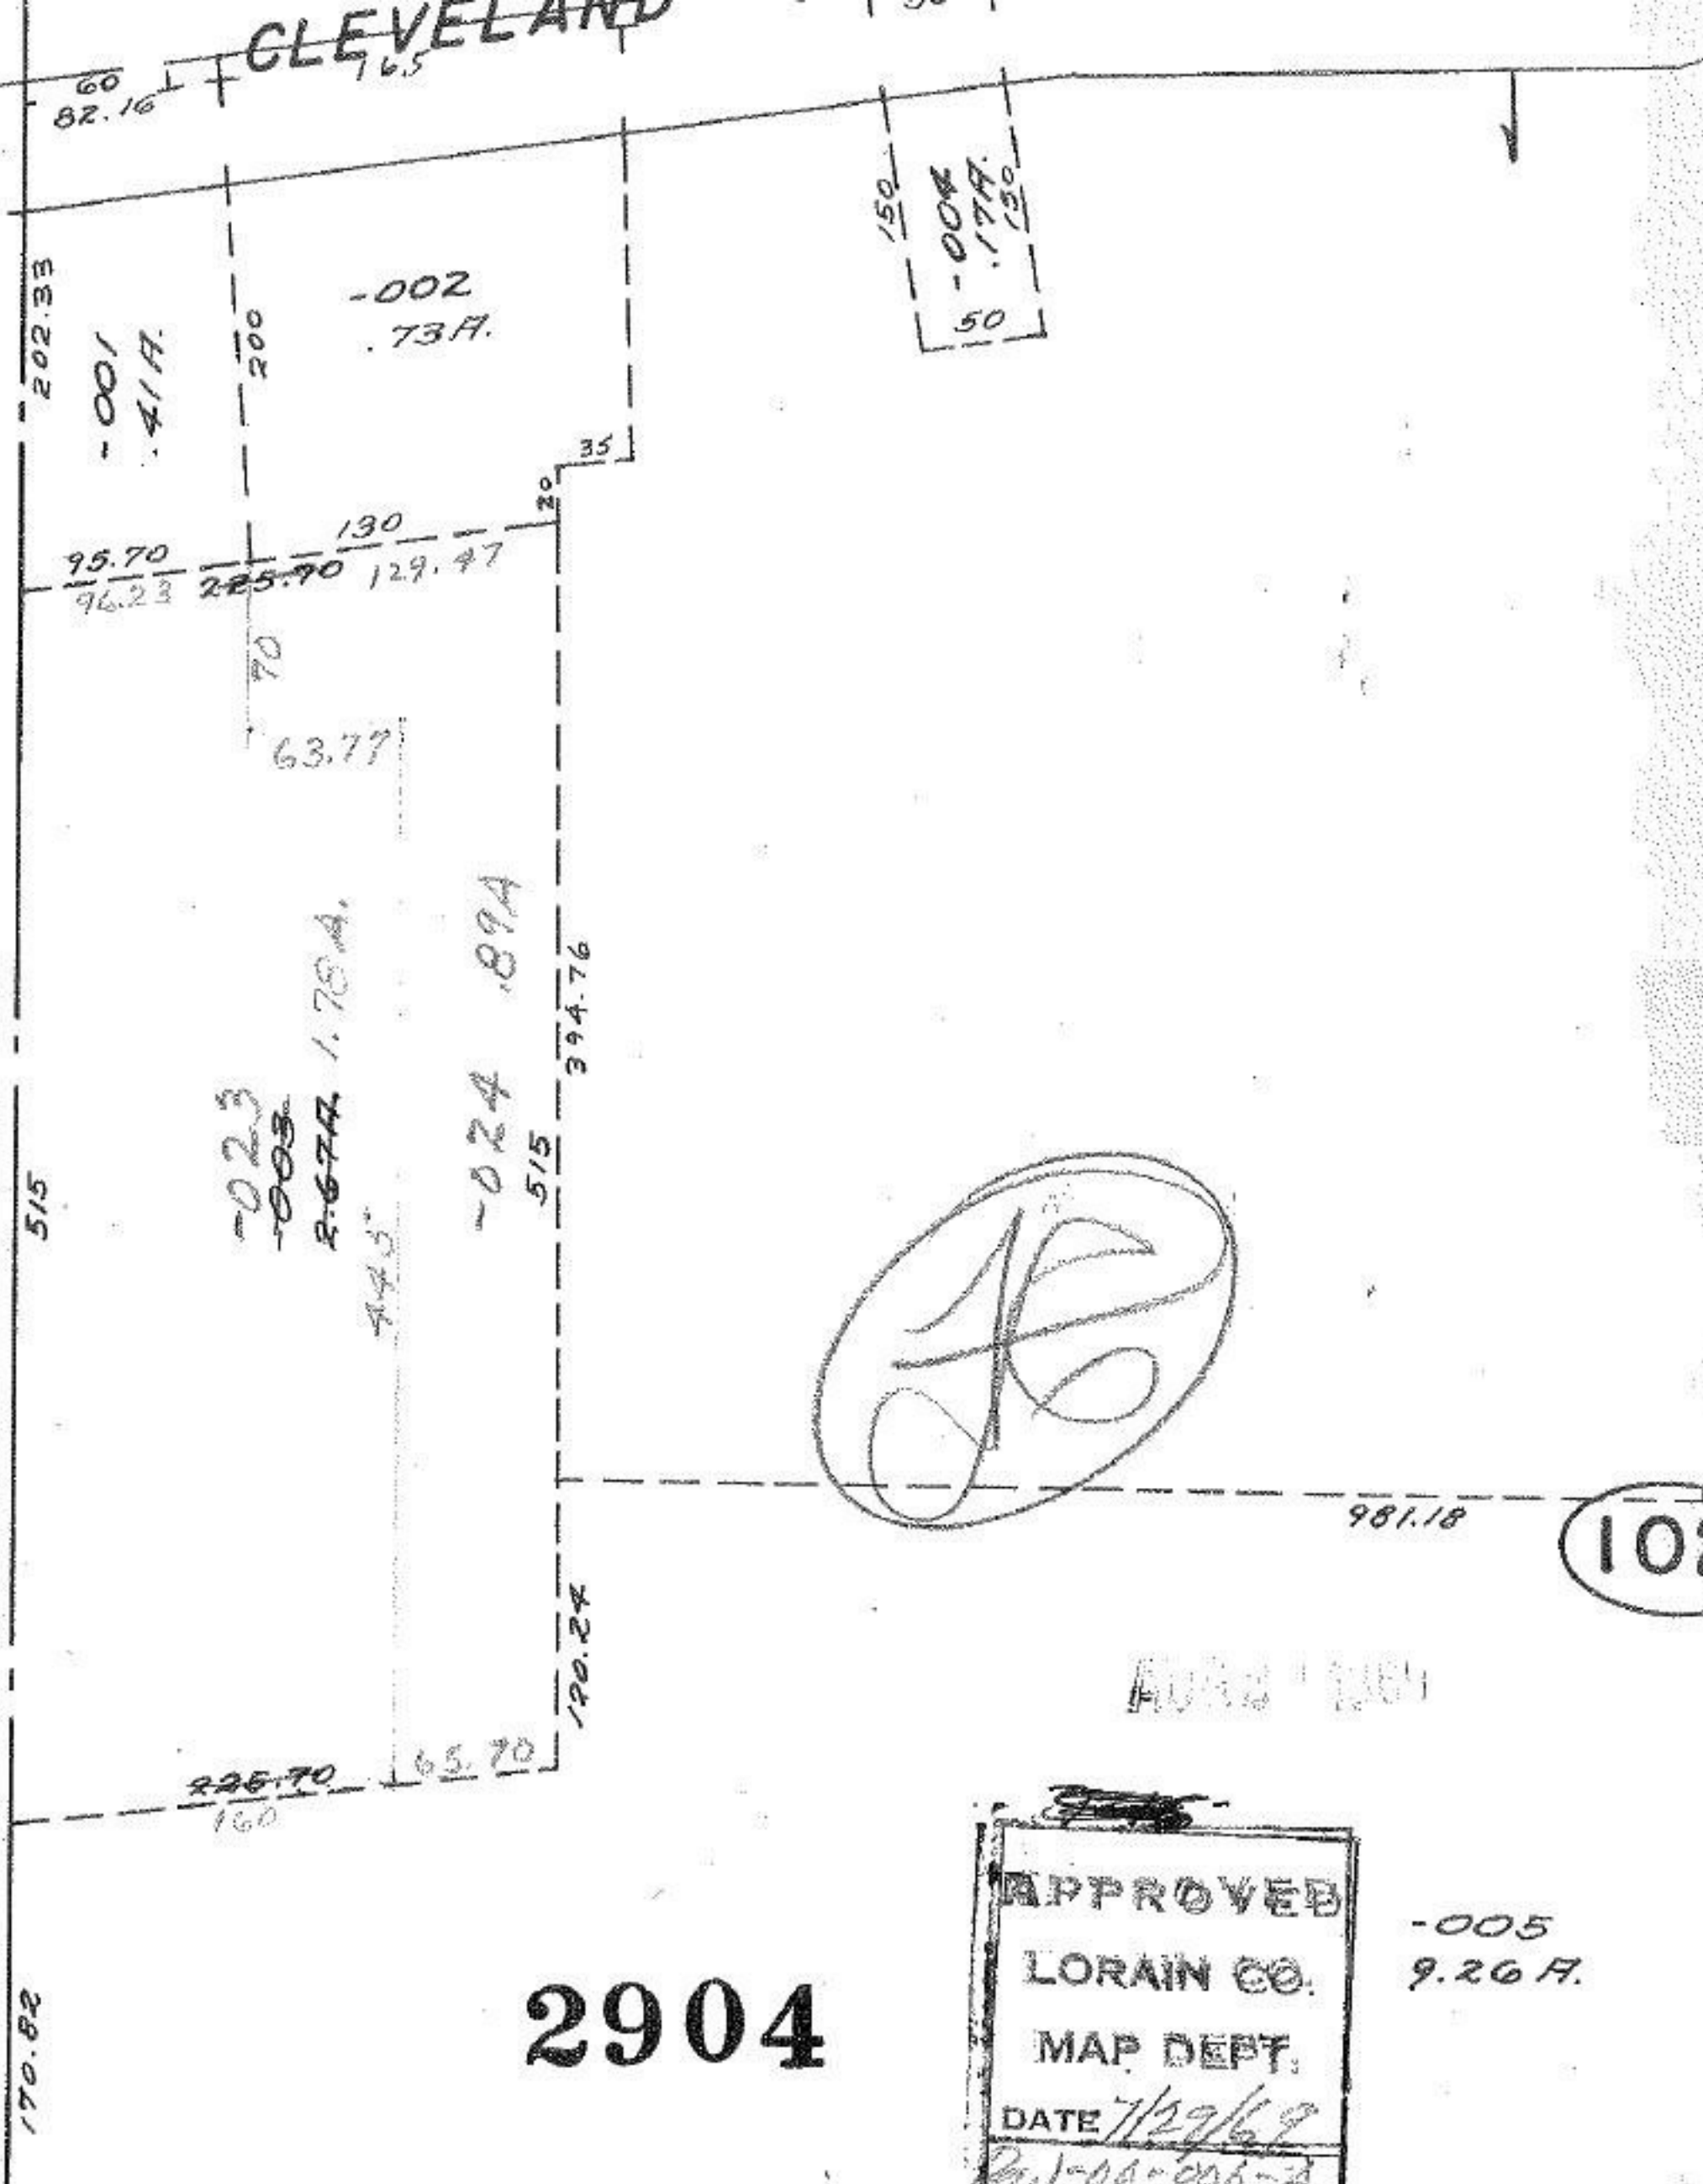

$$\begin{array}{r} 225.70 \\ 160 \\ \hline 65.70 \end{array}$$

$$\begin{array}{r} 225.70 \\ 96.23 \\ \hline 129.47 \end{array}$$

102

2904

APPROVED

LORAIN CO.

MAP DEPT.

DATE 7/29/69

BY

-005
9.26 A.