

Be Sure To Correct acreage  
+ Parcel Nos on two adjacent  
Tax Map Pgs. L W Hall


2907

Page 6-127  
Acre M. 40.00 A.  
Pt. - 1.78

RD

WEST RIDGE

Pt. -007  
Rt. 39.37

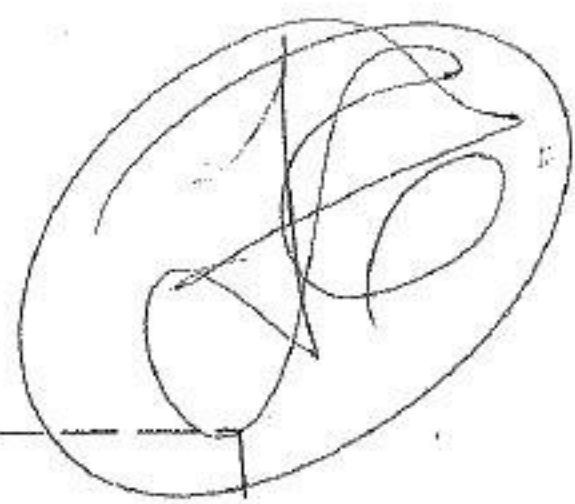

208

Page 6-129



**2907**  
AUG 15 1969

APPROVED  
LORAIN CO.