



2925

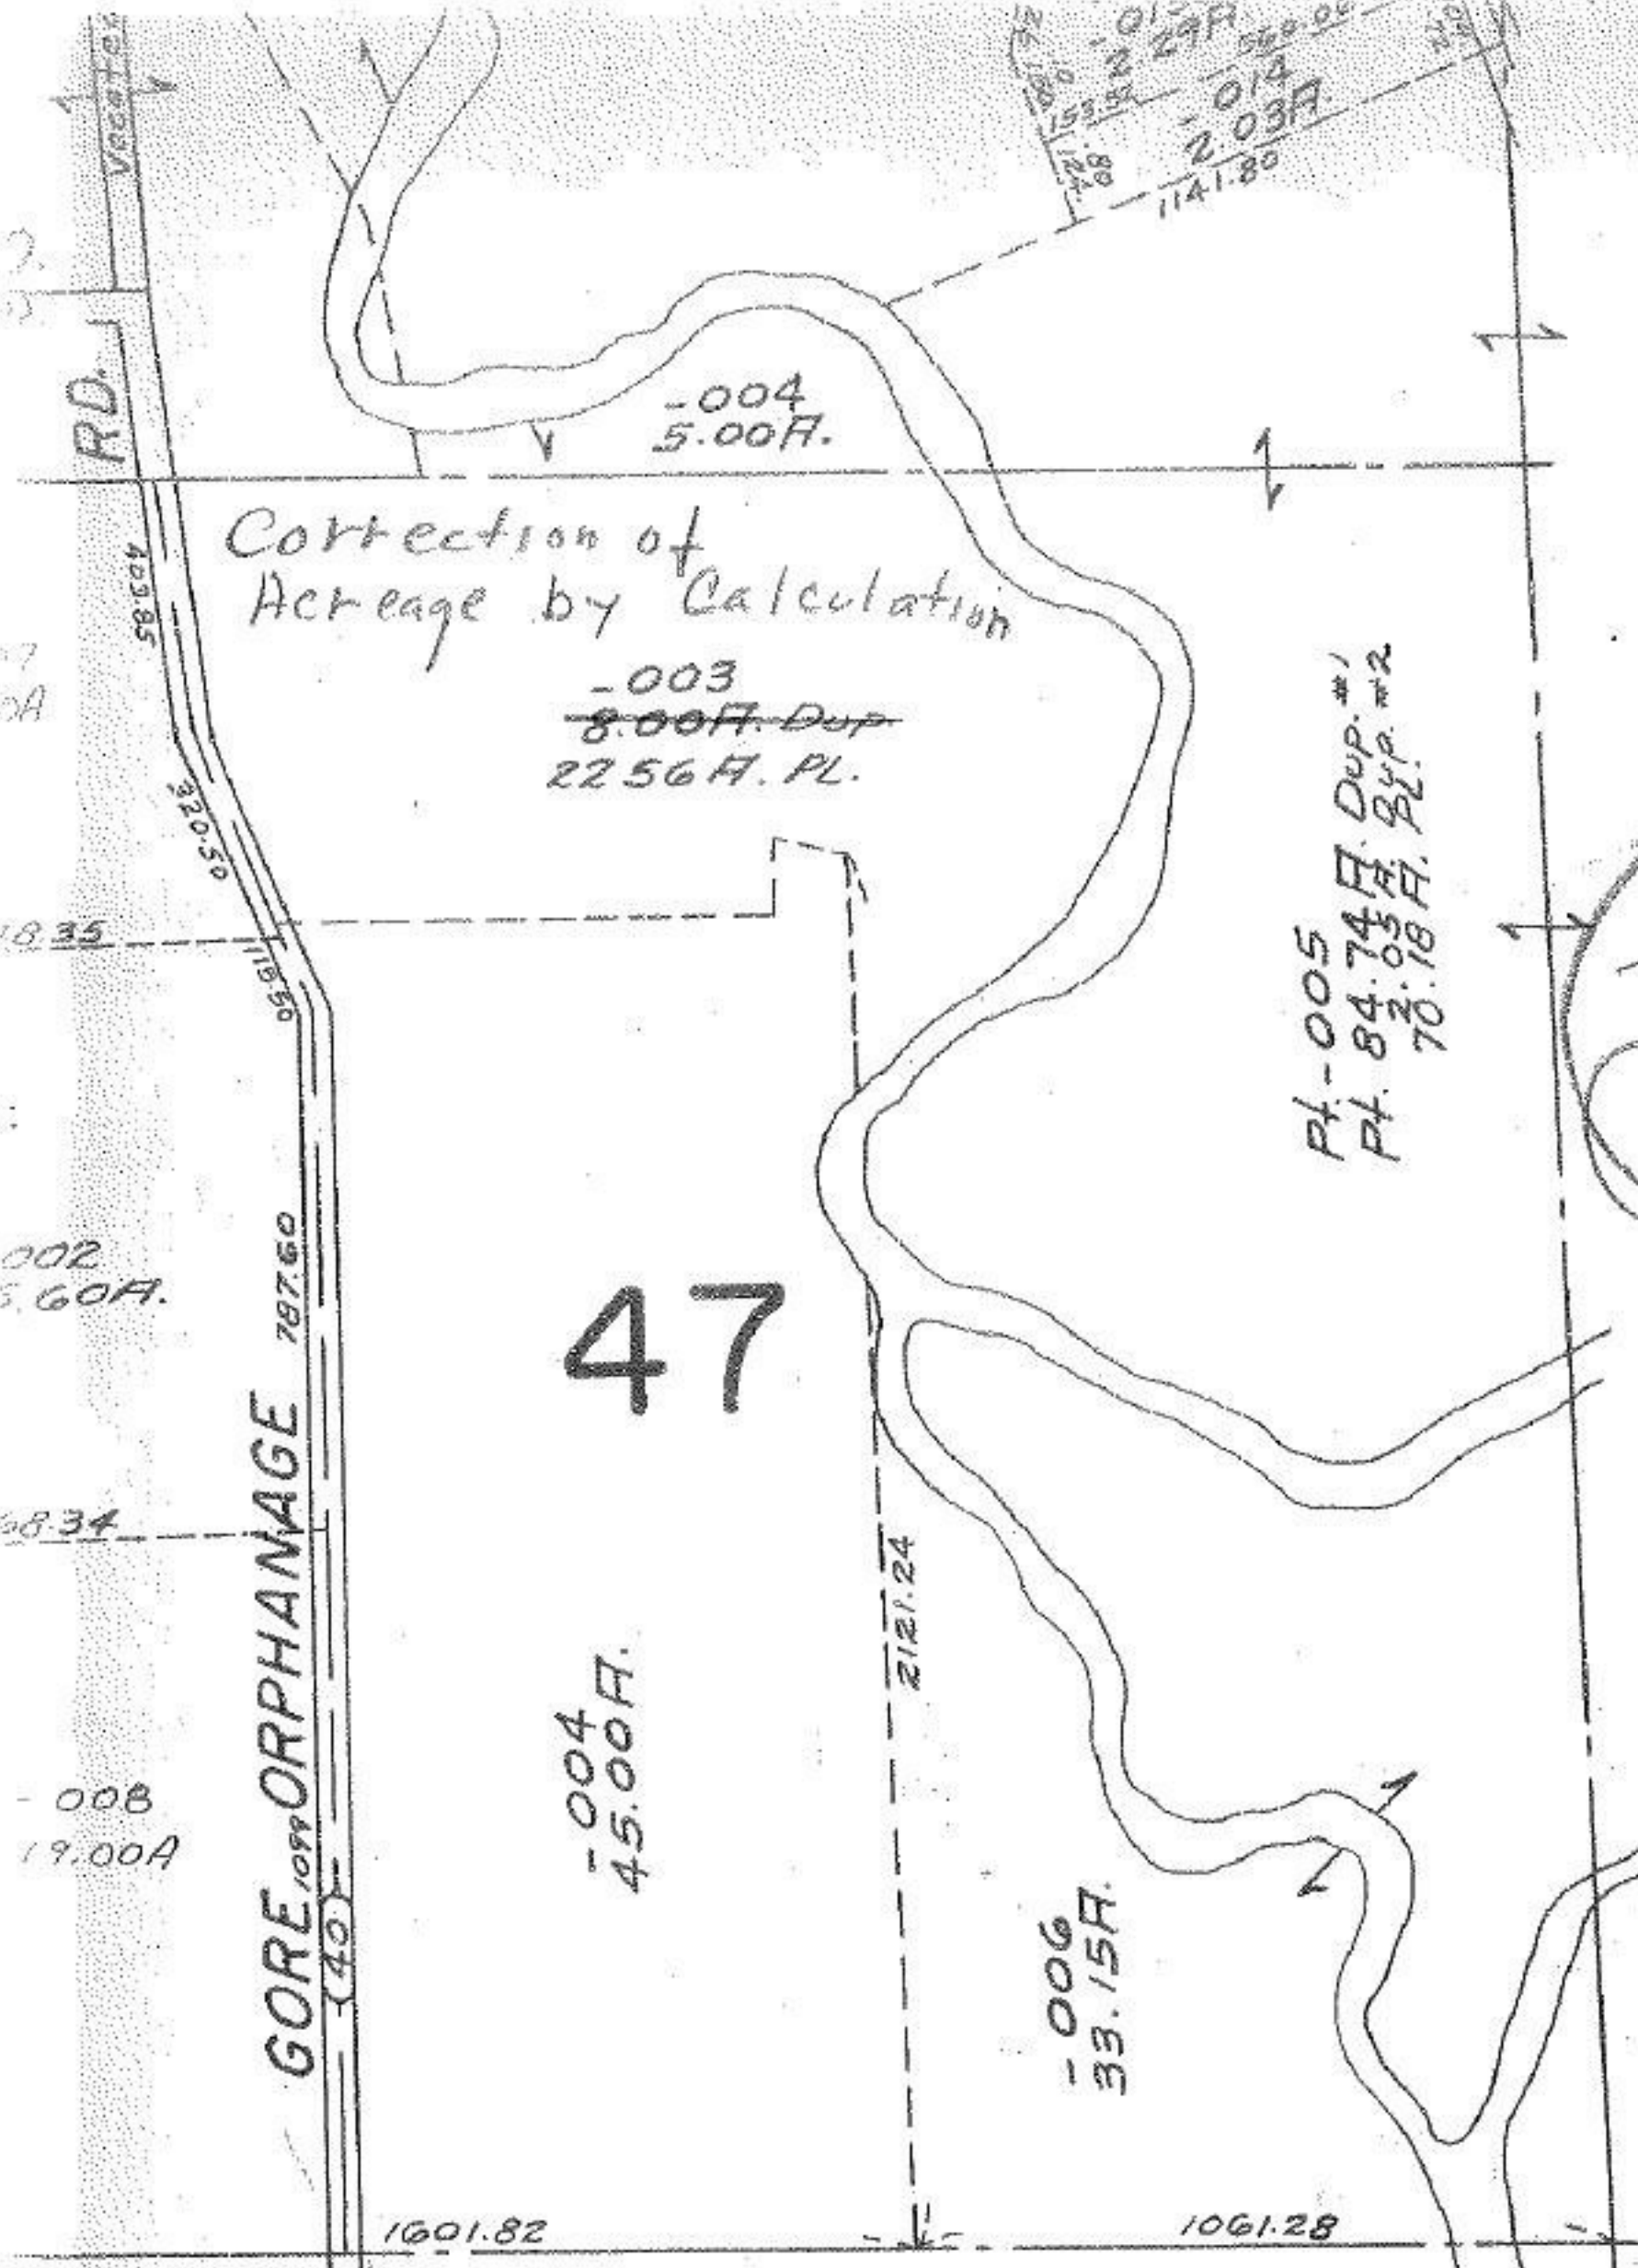

Correction of
Acreage by Calculation

-003
~~8.00F. Dup~~
22.56 F. PL.

Pt. -005
Pt. 84.74 F. Dup. #1
Pt. 70.18 F. Dup. #2

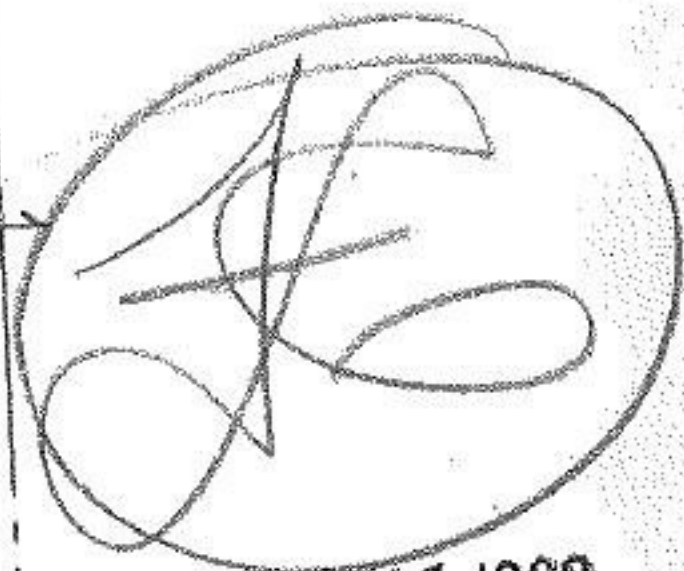

AUG 21 1969

#2925
 APPROVED
 LORAIN CO.
 MAP DEPT.
 DATE 8-6-69
 LE
 BY LWHall

#2925