


2948

Robson Rd

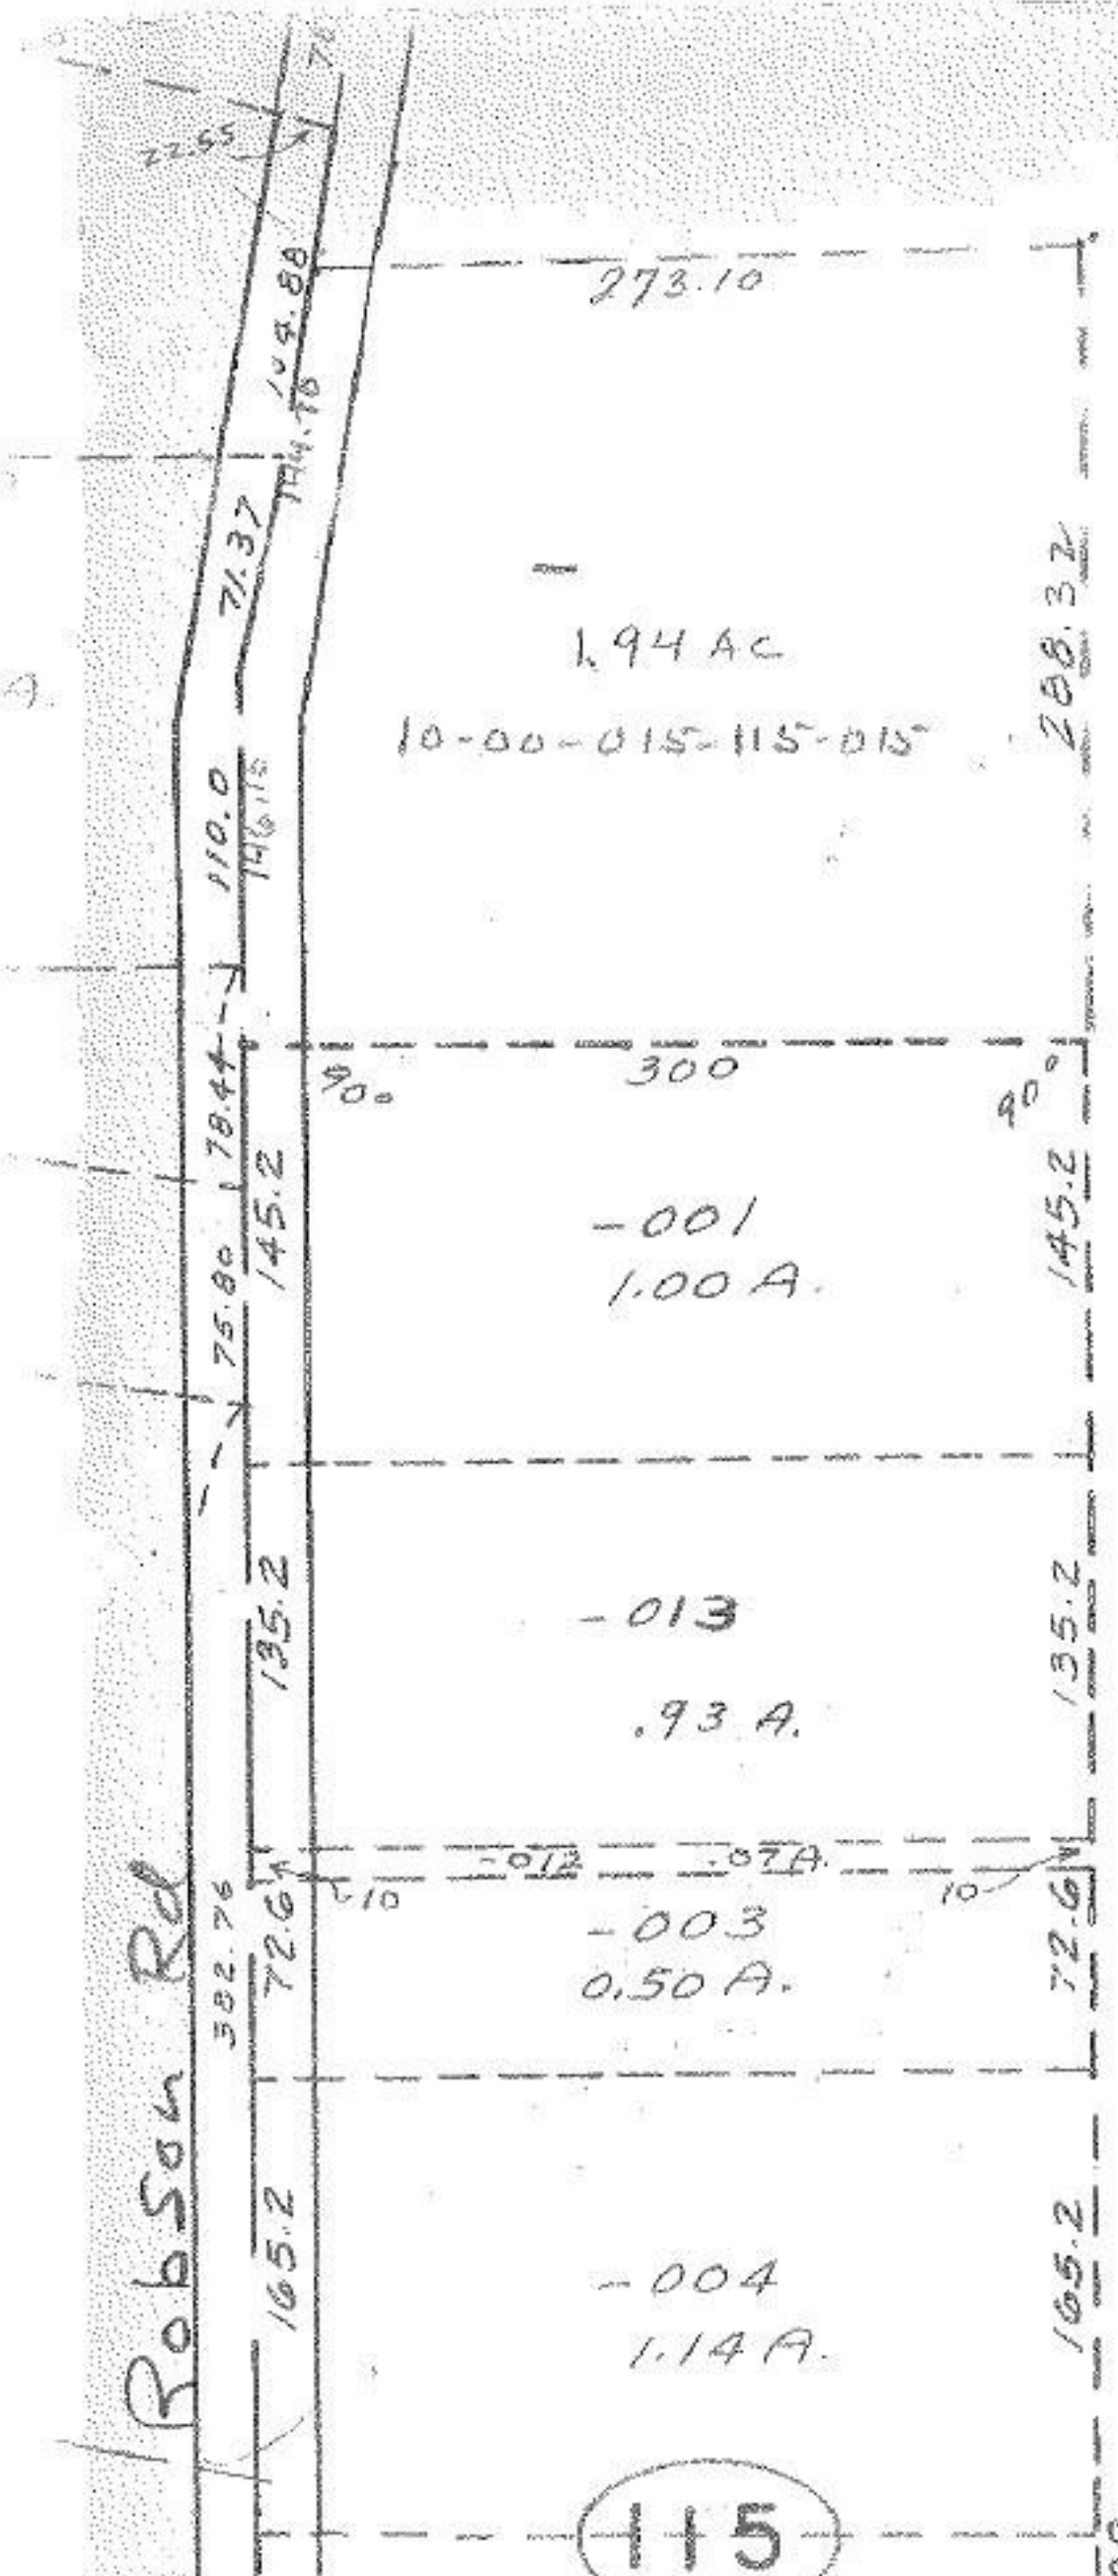

Note Change

~~114~~ 115

Pt. -022  
Pt. 27.26 A.  
Pt 10-00-015-115-016  
25.32

S.S. 7-25-85



SEP 5 1969

APPROVED  
LORAIN CO.  
MAP DEPT.  
DATE 8-14-69  
10-00-015F

Change of Block No

Robson Rd  
P.P. 110  
2870.34

SEE 10-00-015-G