
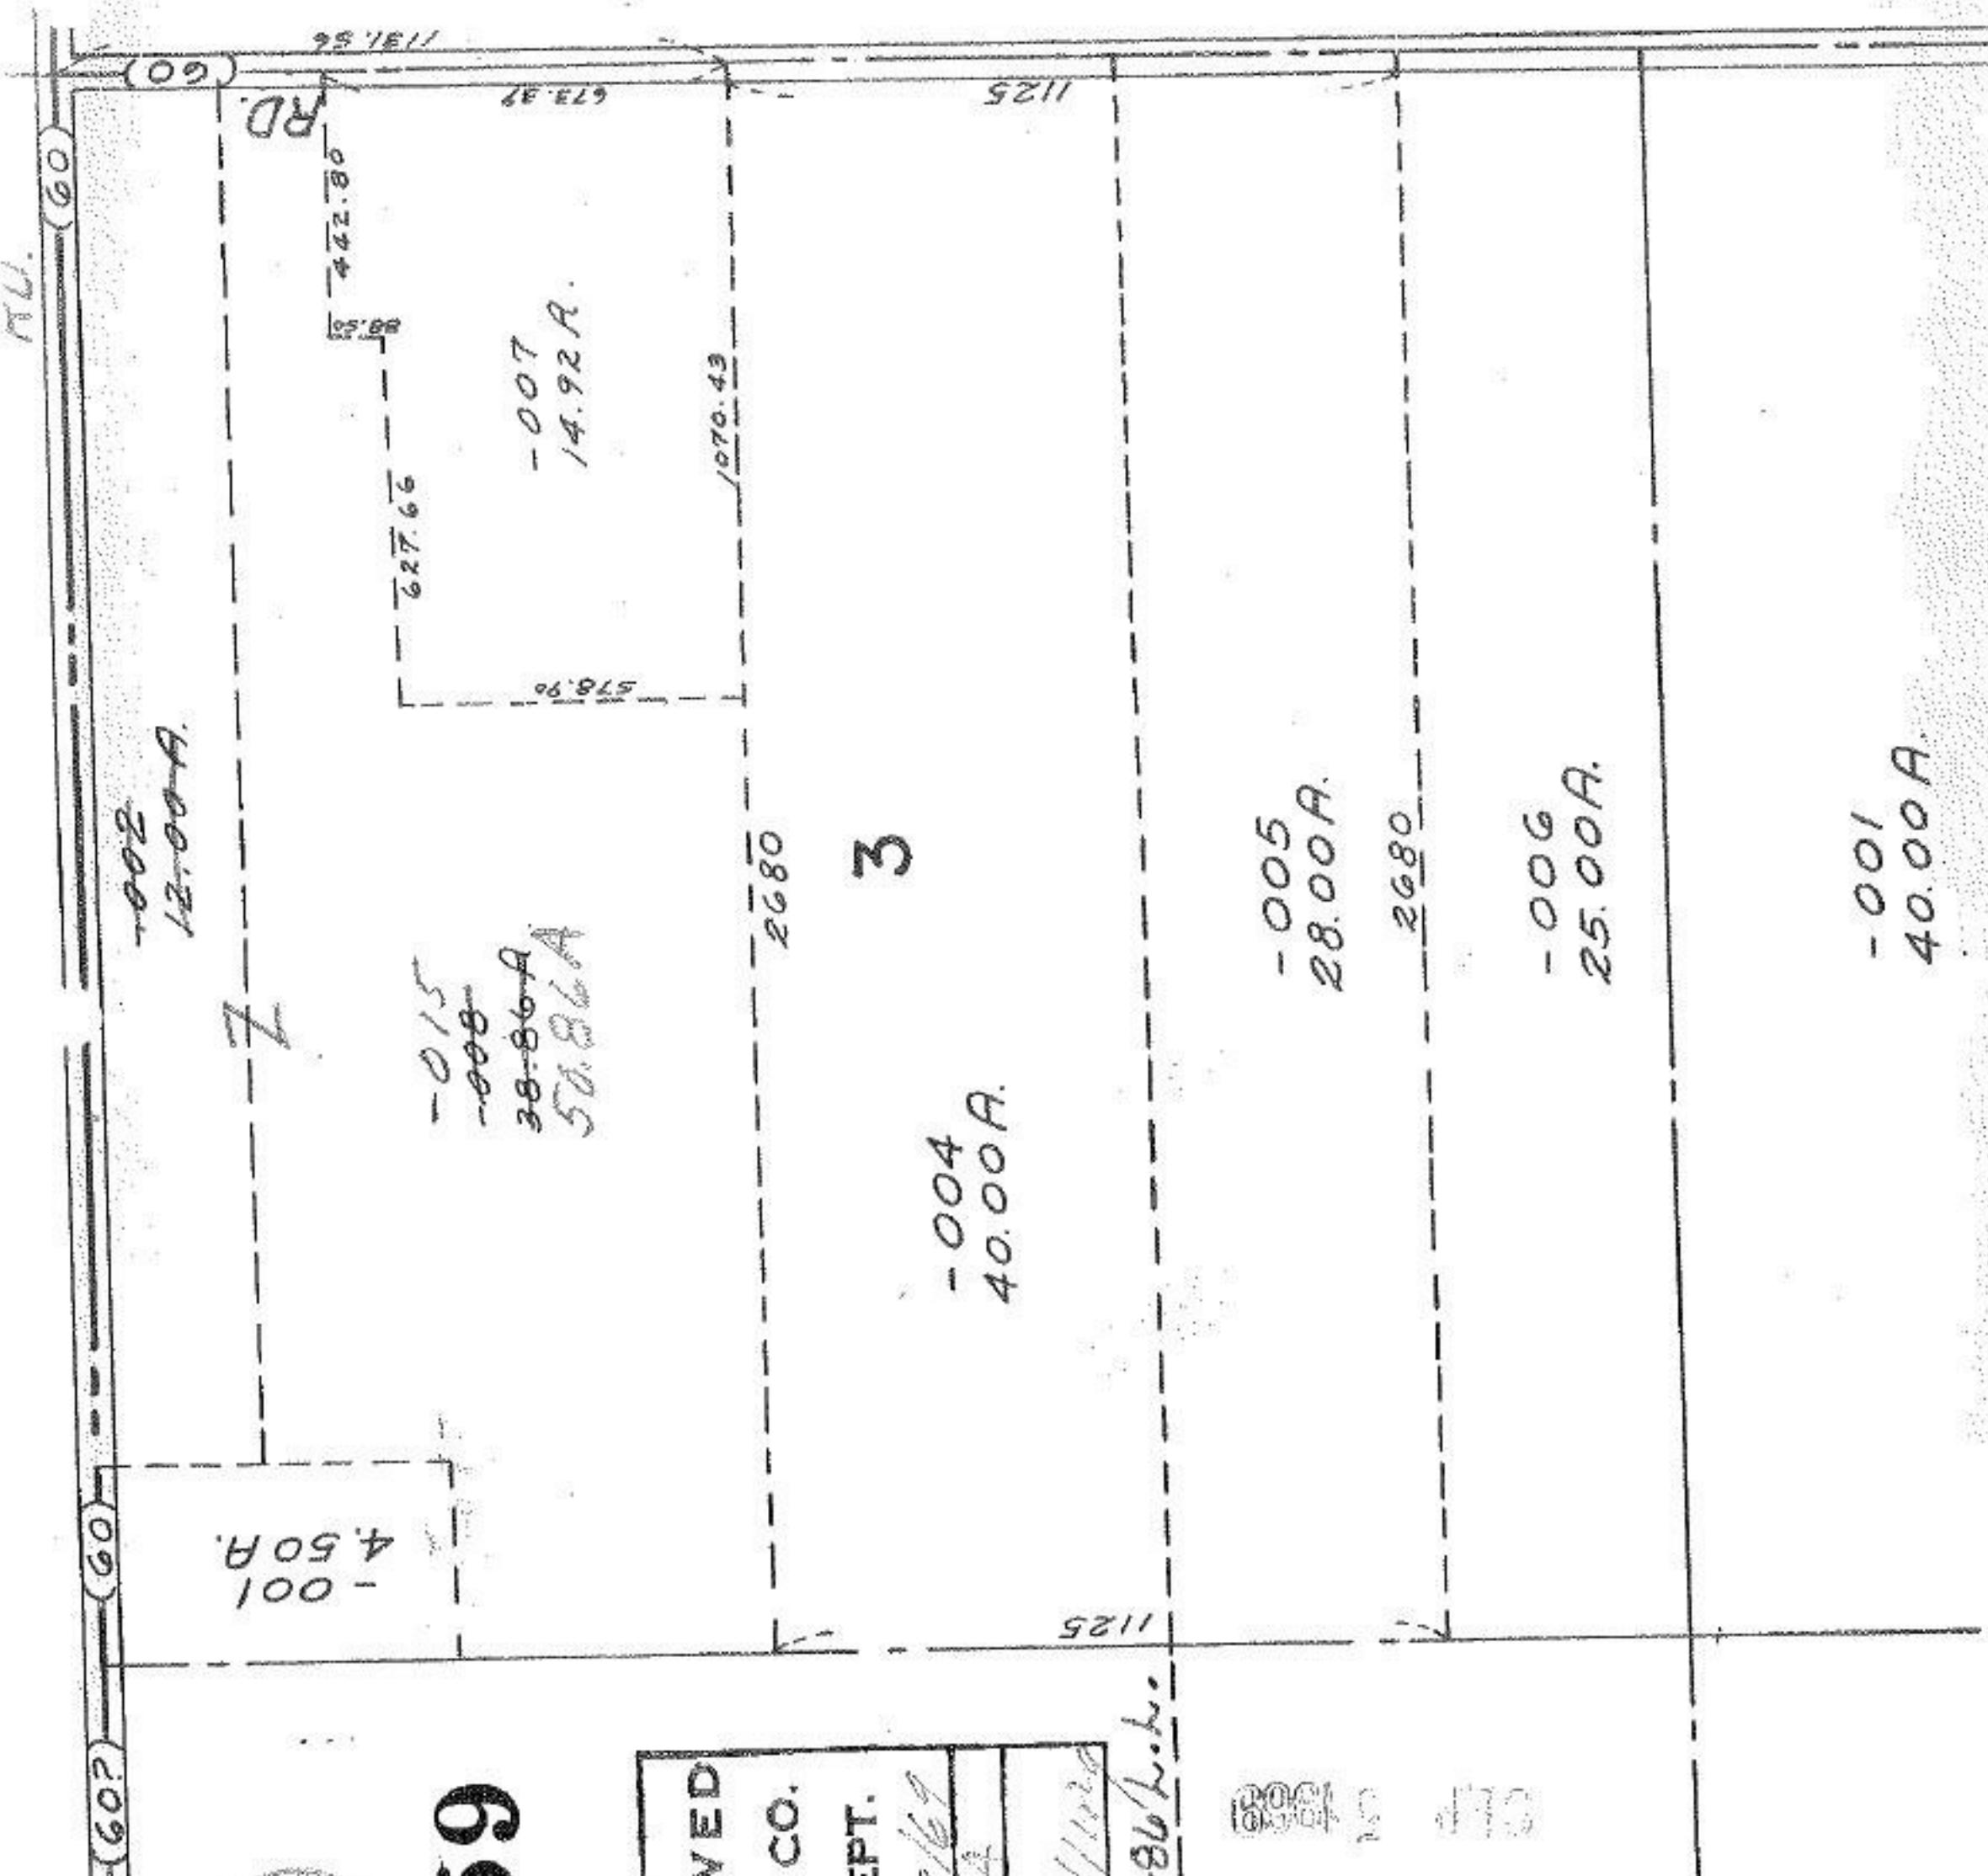


2969

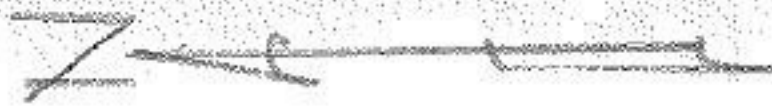

-002  
12.00A.

7

-001  
4.50A.

-015  
~~-008~~  
38.86A  
50.86A

-007  
14.92A.

2680

3

-004  
40.00A.

-005  
28.00A.

2680

-006  
25.00A.

-001  
40.00A.

59

VED  
 I CO.  
 EPT.  
 9/69  
 A  
 11/10

86 h. h.

830 20 470