
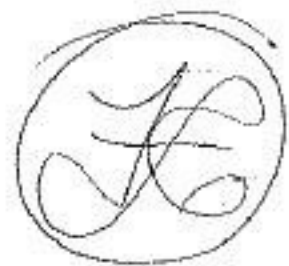


2984

SEE 20-05

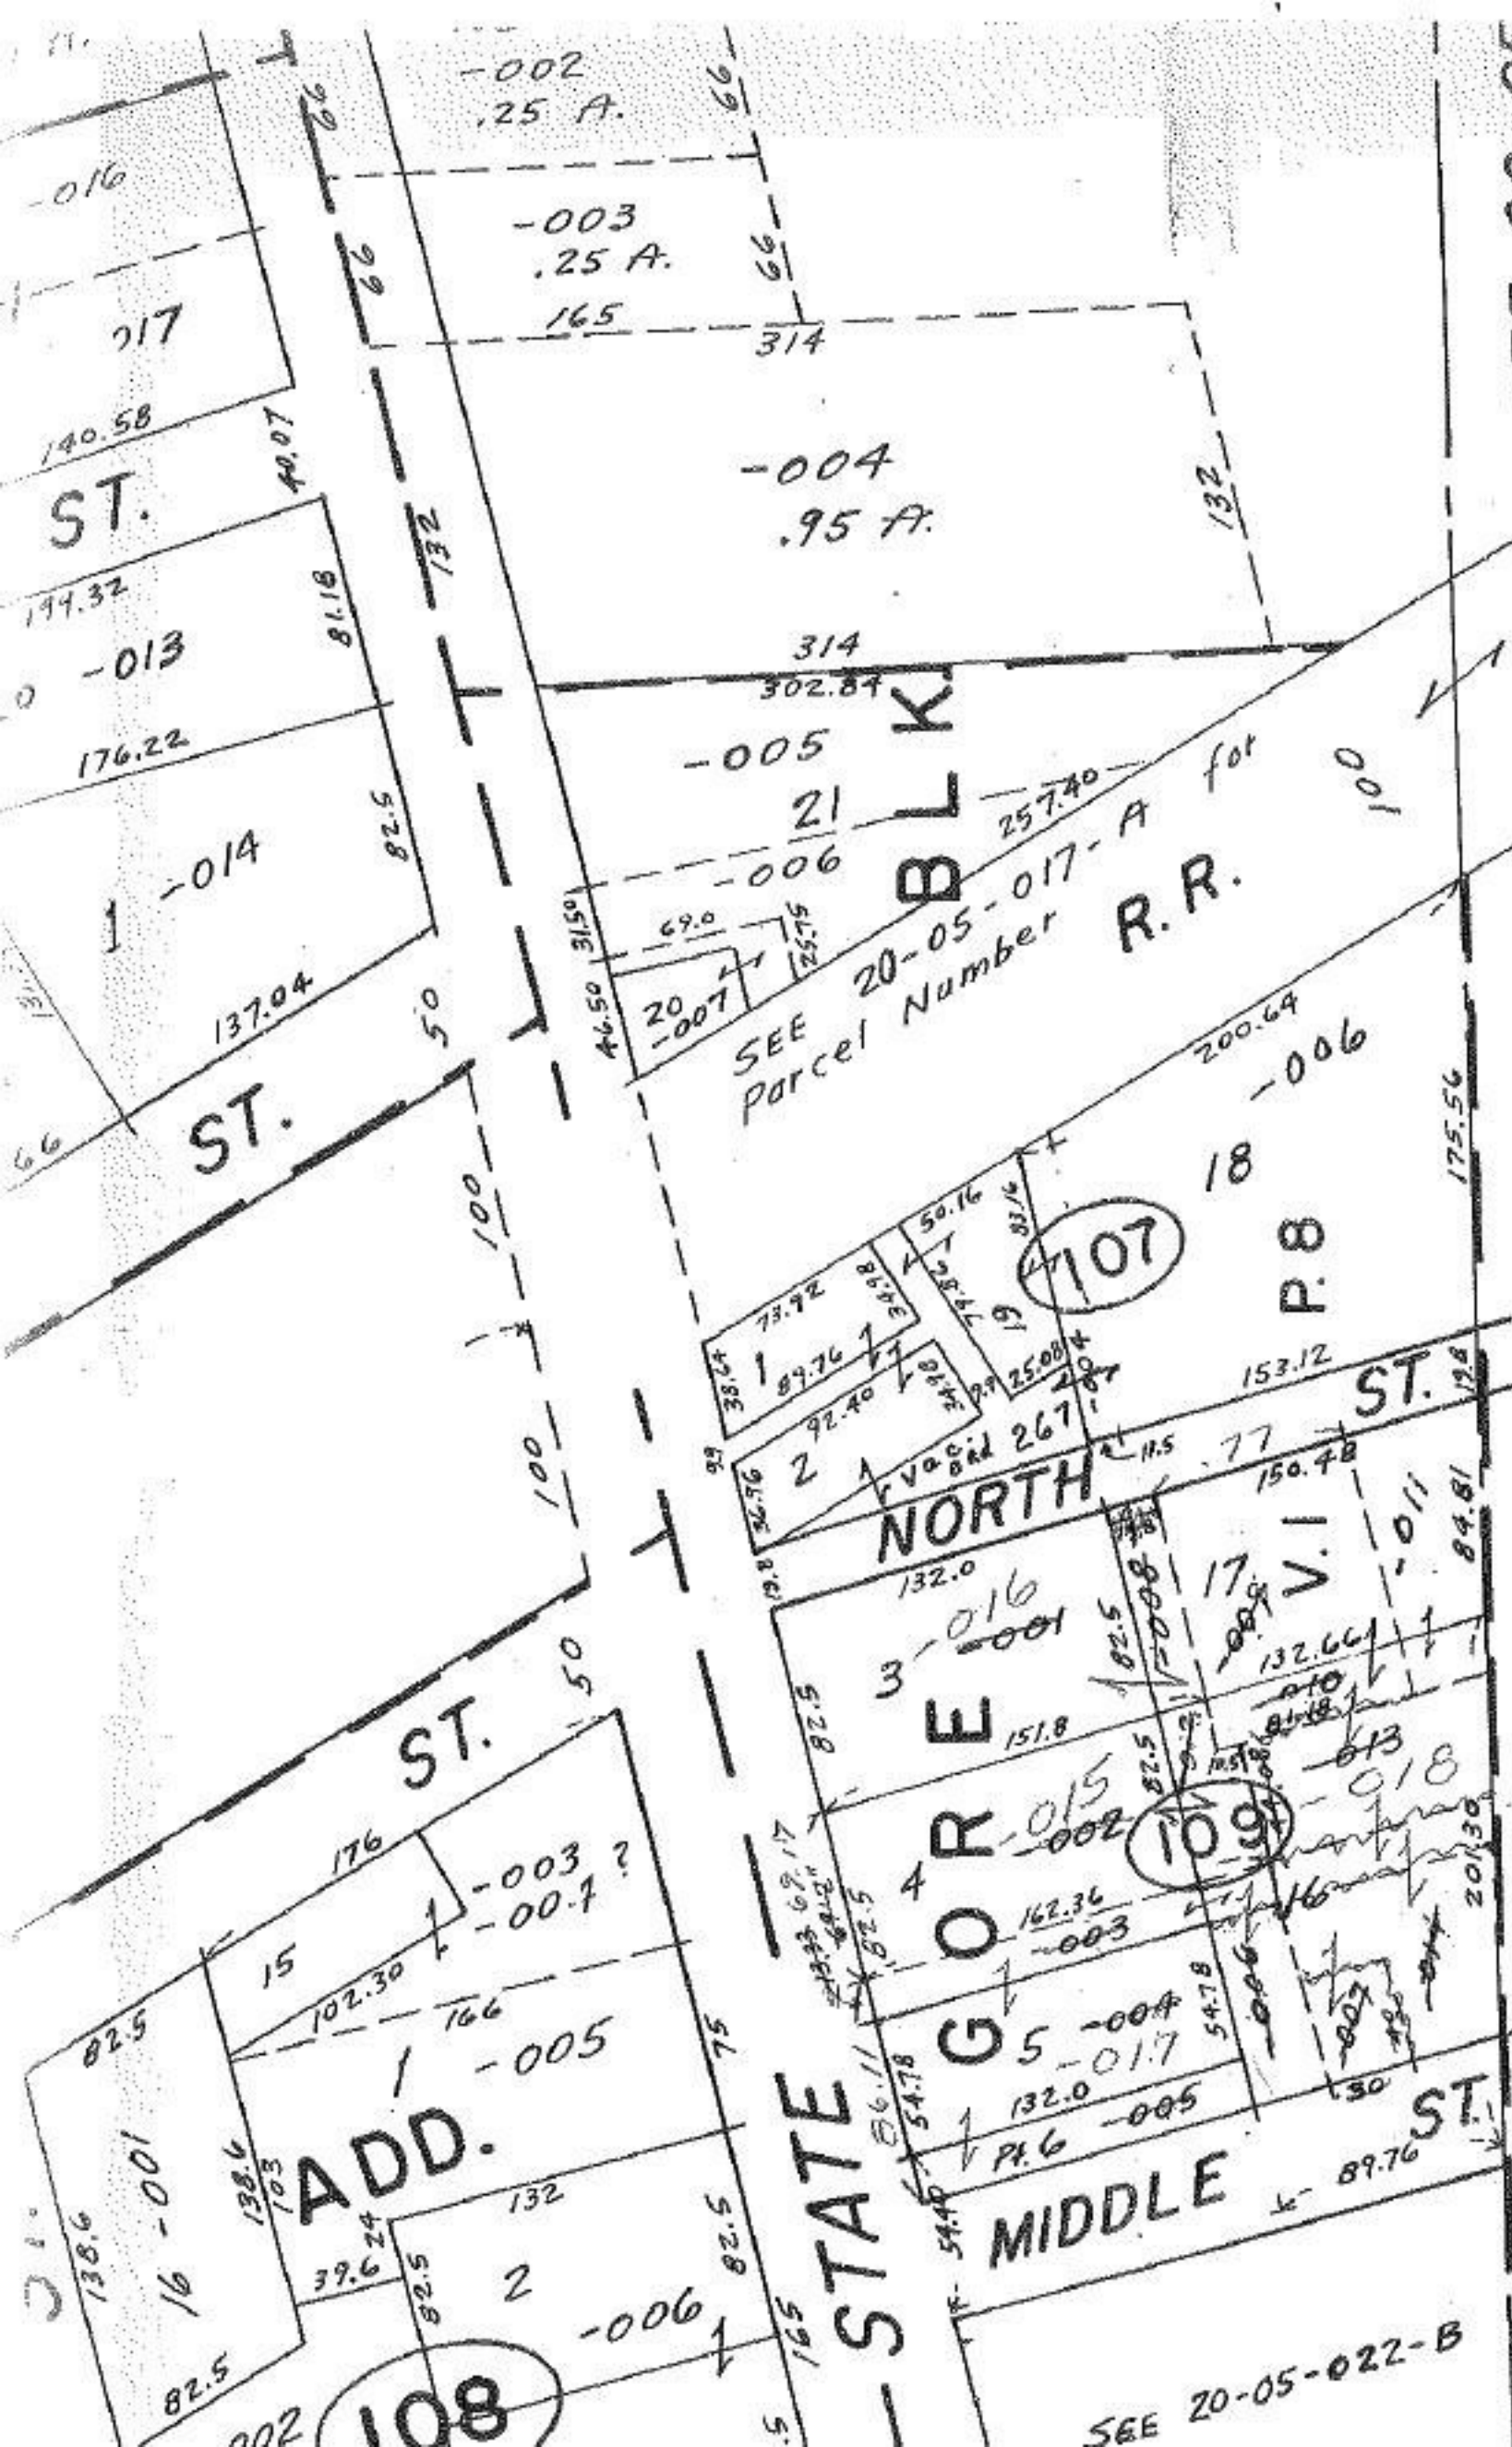

2984

APPROVED  
 LORAIN CO.  
 MAP DEPT.

DATE 8-22-69

20-05-023-B

BY [Signature]

SEE 20-05-022-B