


2986

-015-B

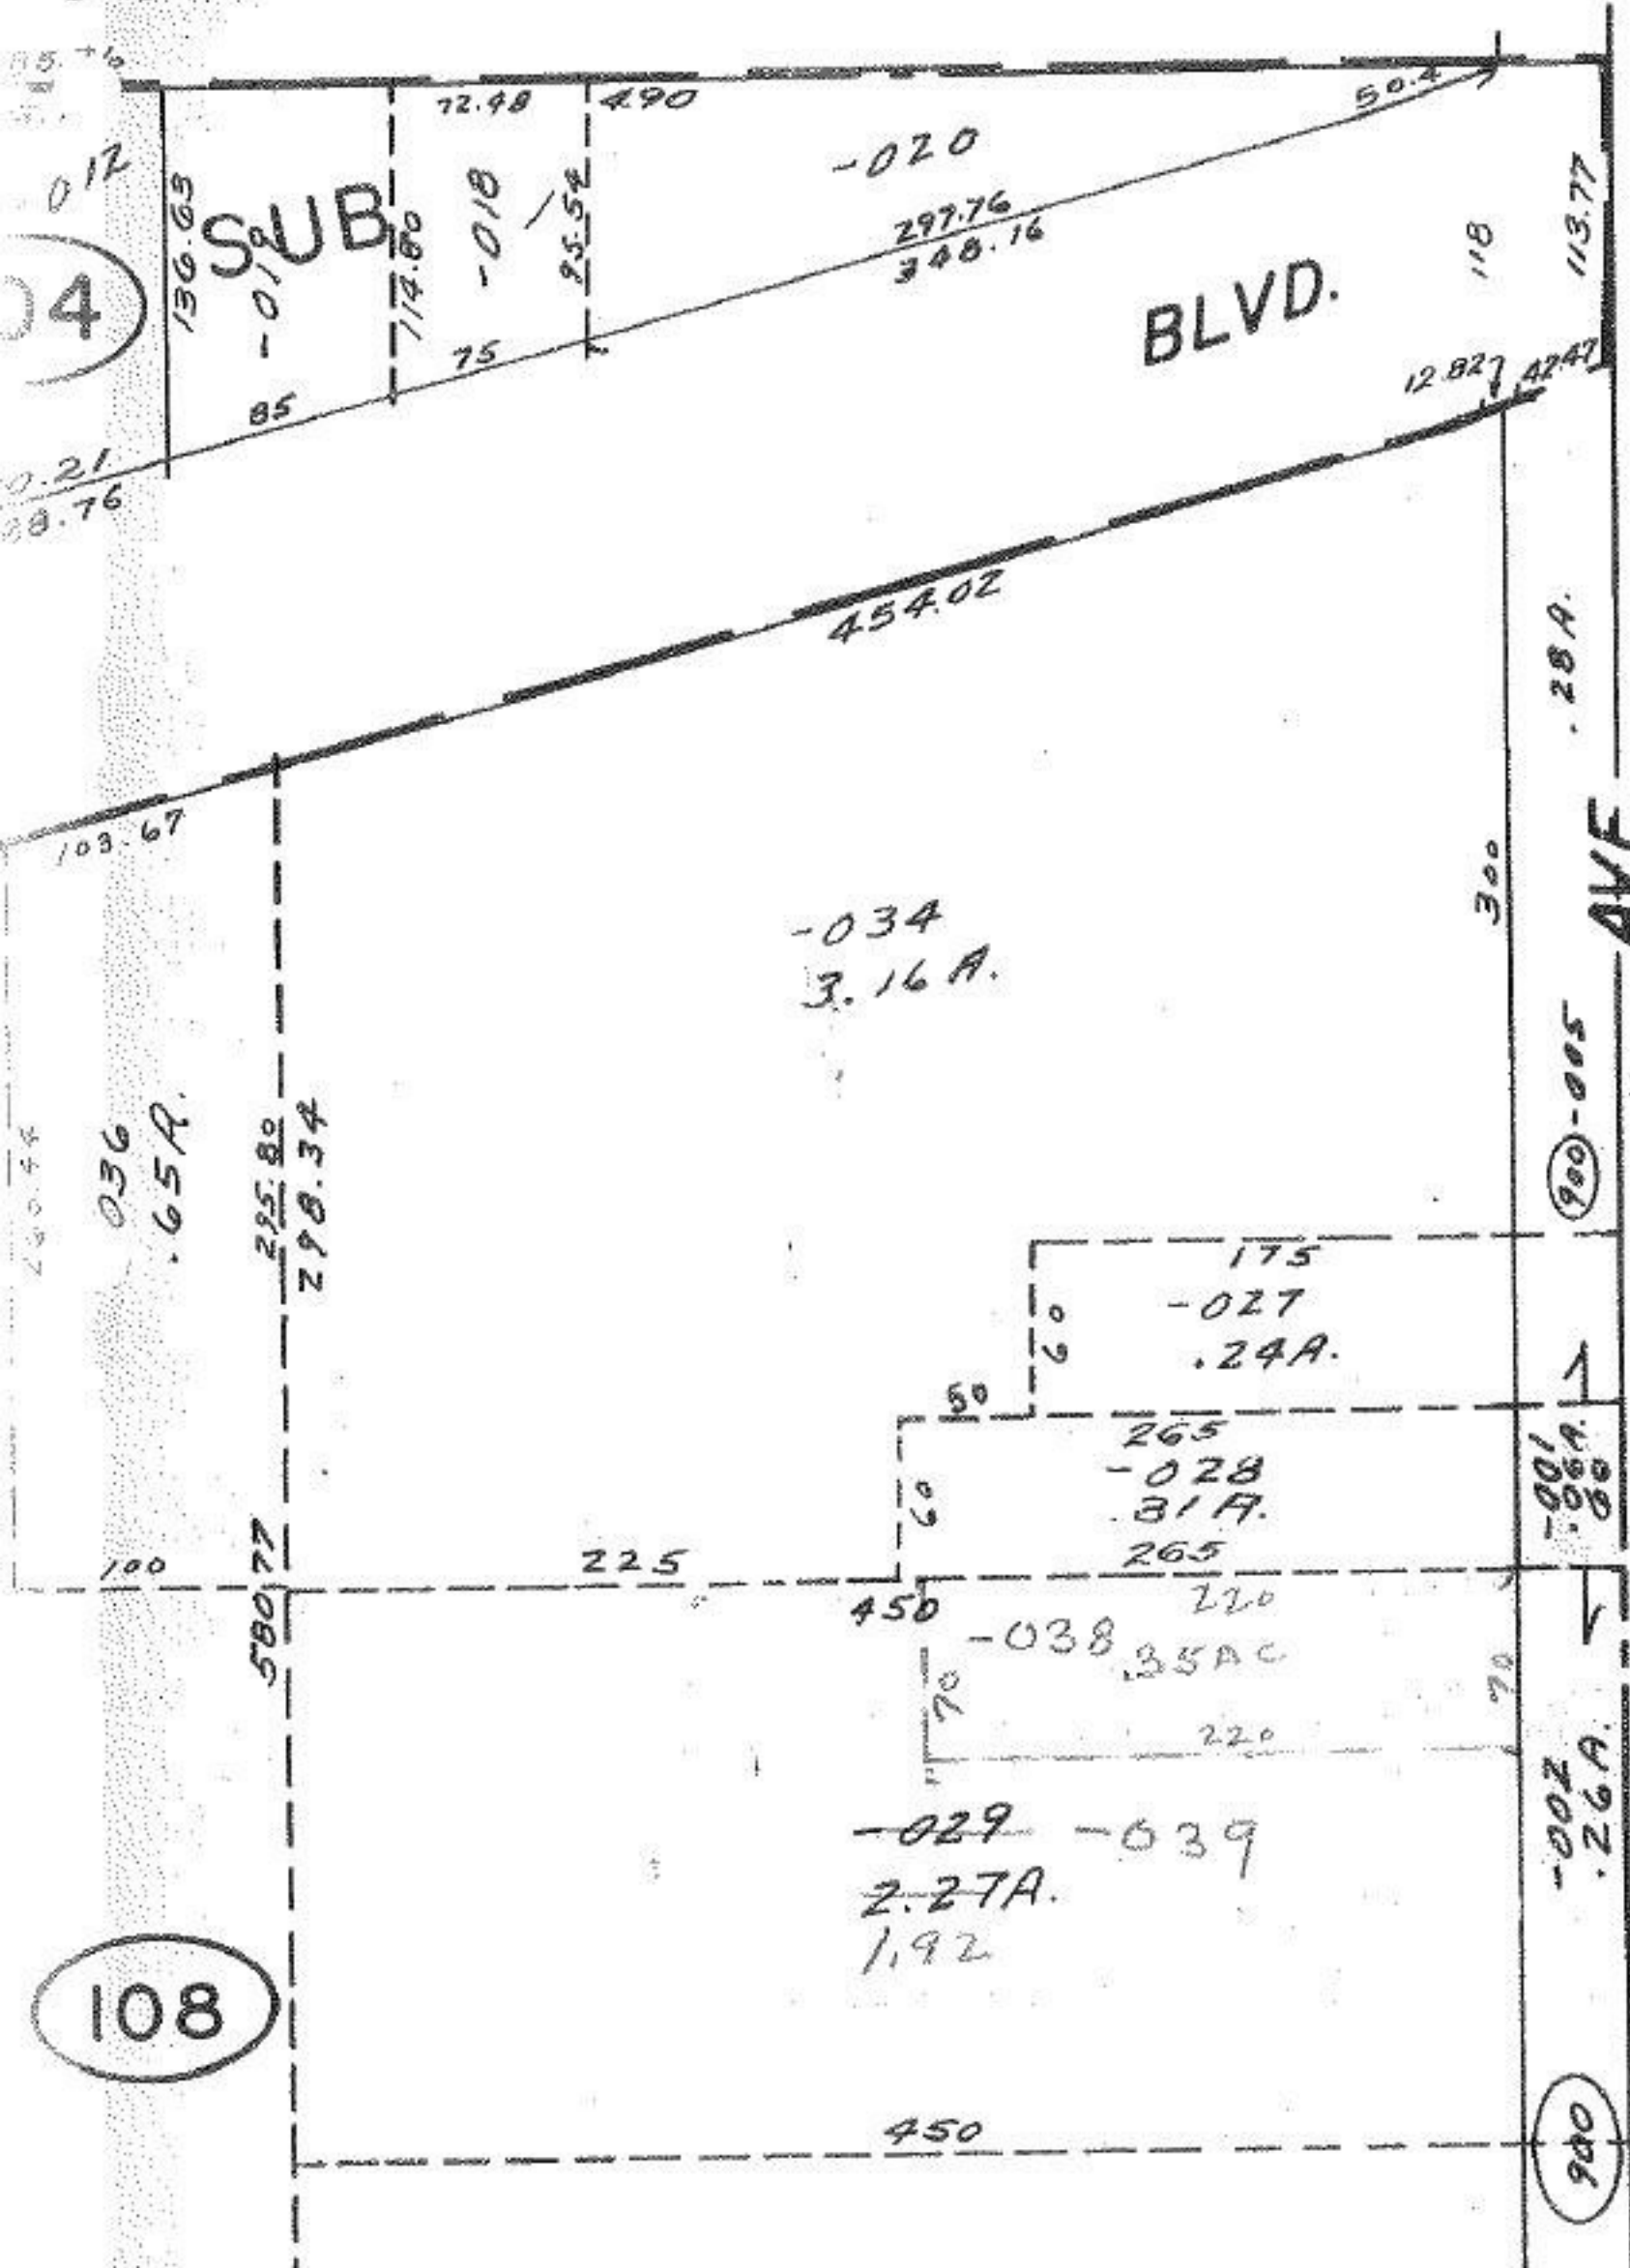

SEP 4 1969

#2986  
 APPROVED  
 LORAIN CO.