


BERLIN — ELYRIA



83.26 116.7

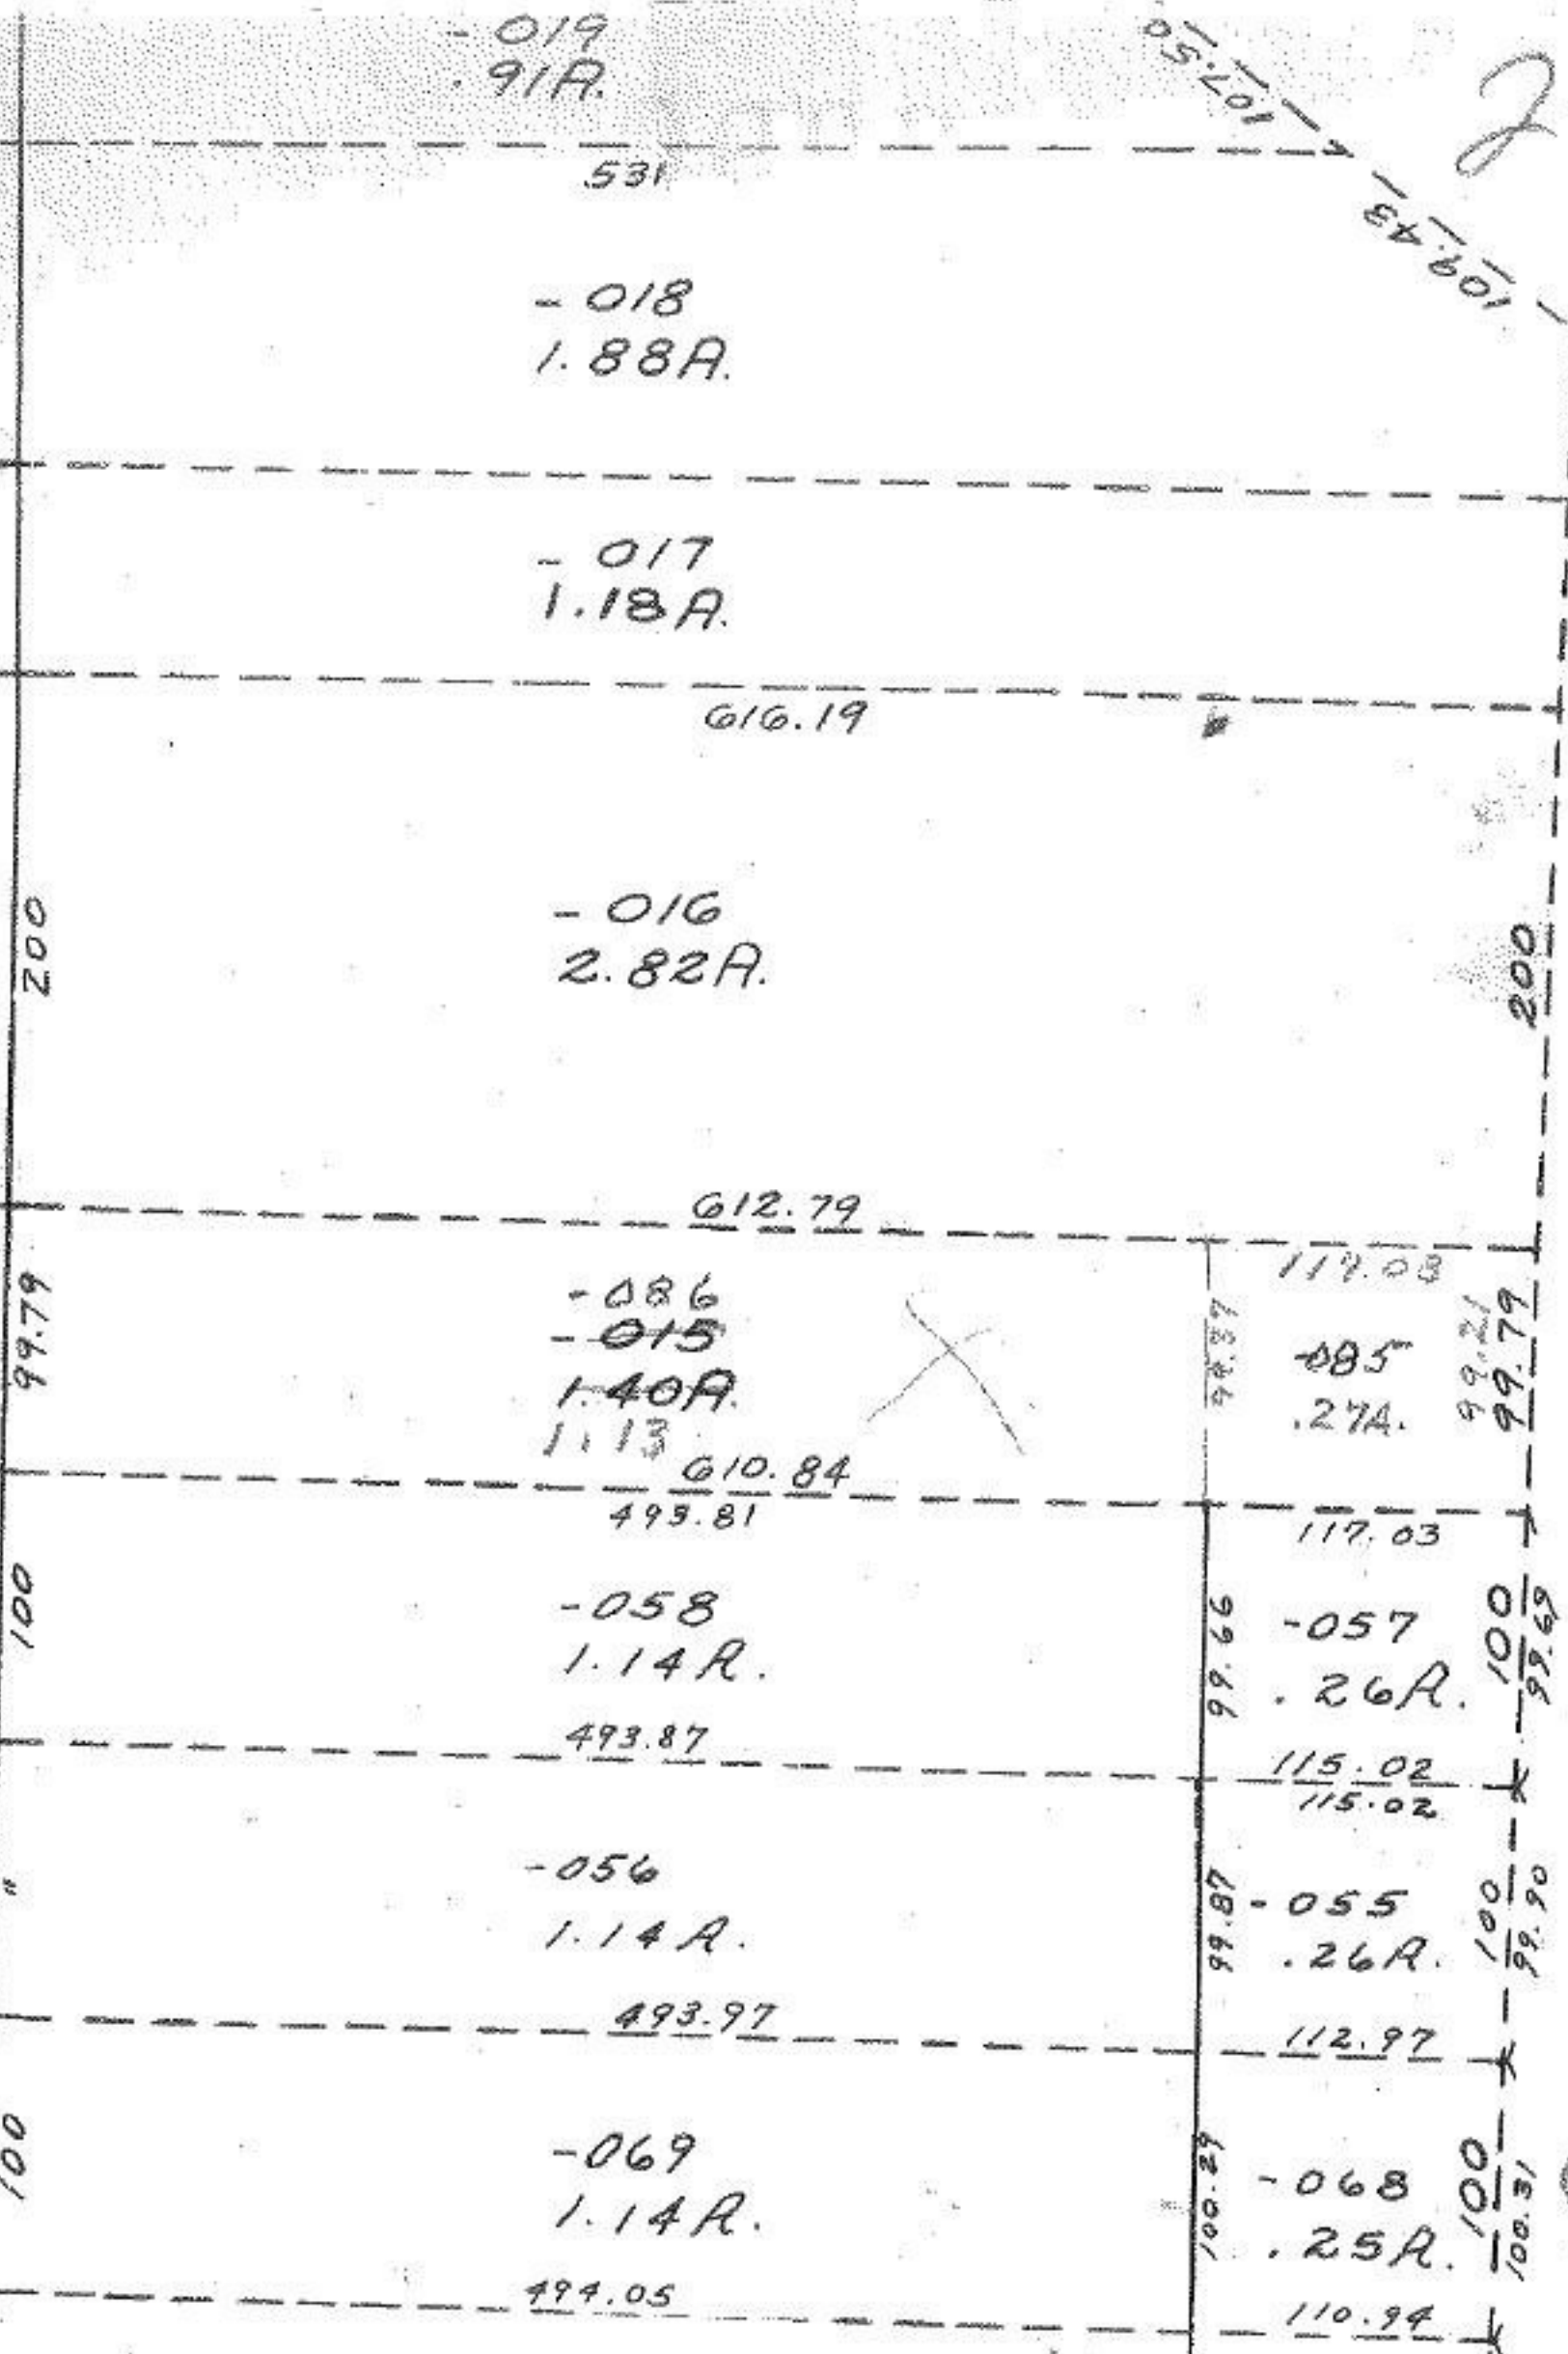

2990

SEE 10-00

2990

5 1969

S.S. 7-29-69

RED	CO.	PT.	169	0-B	128
-----	-----	-----	-----	-----	-----