


AN

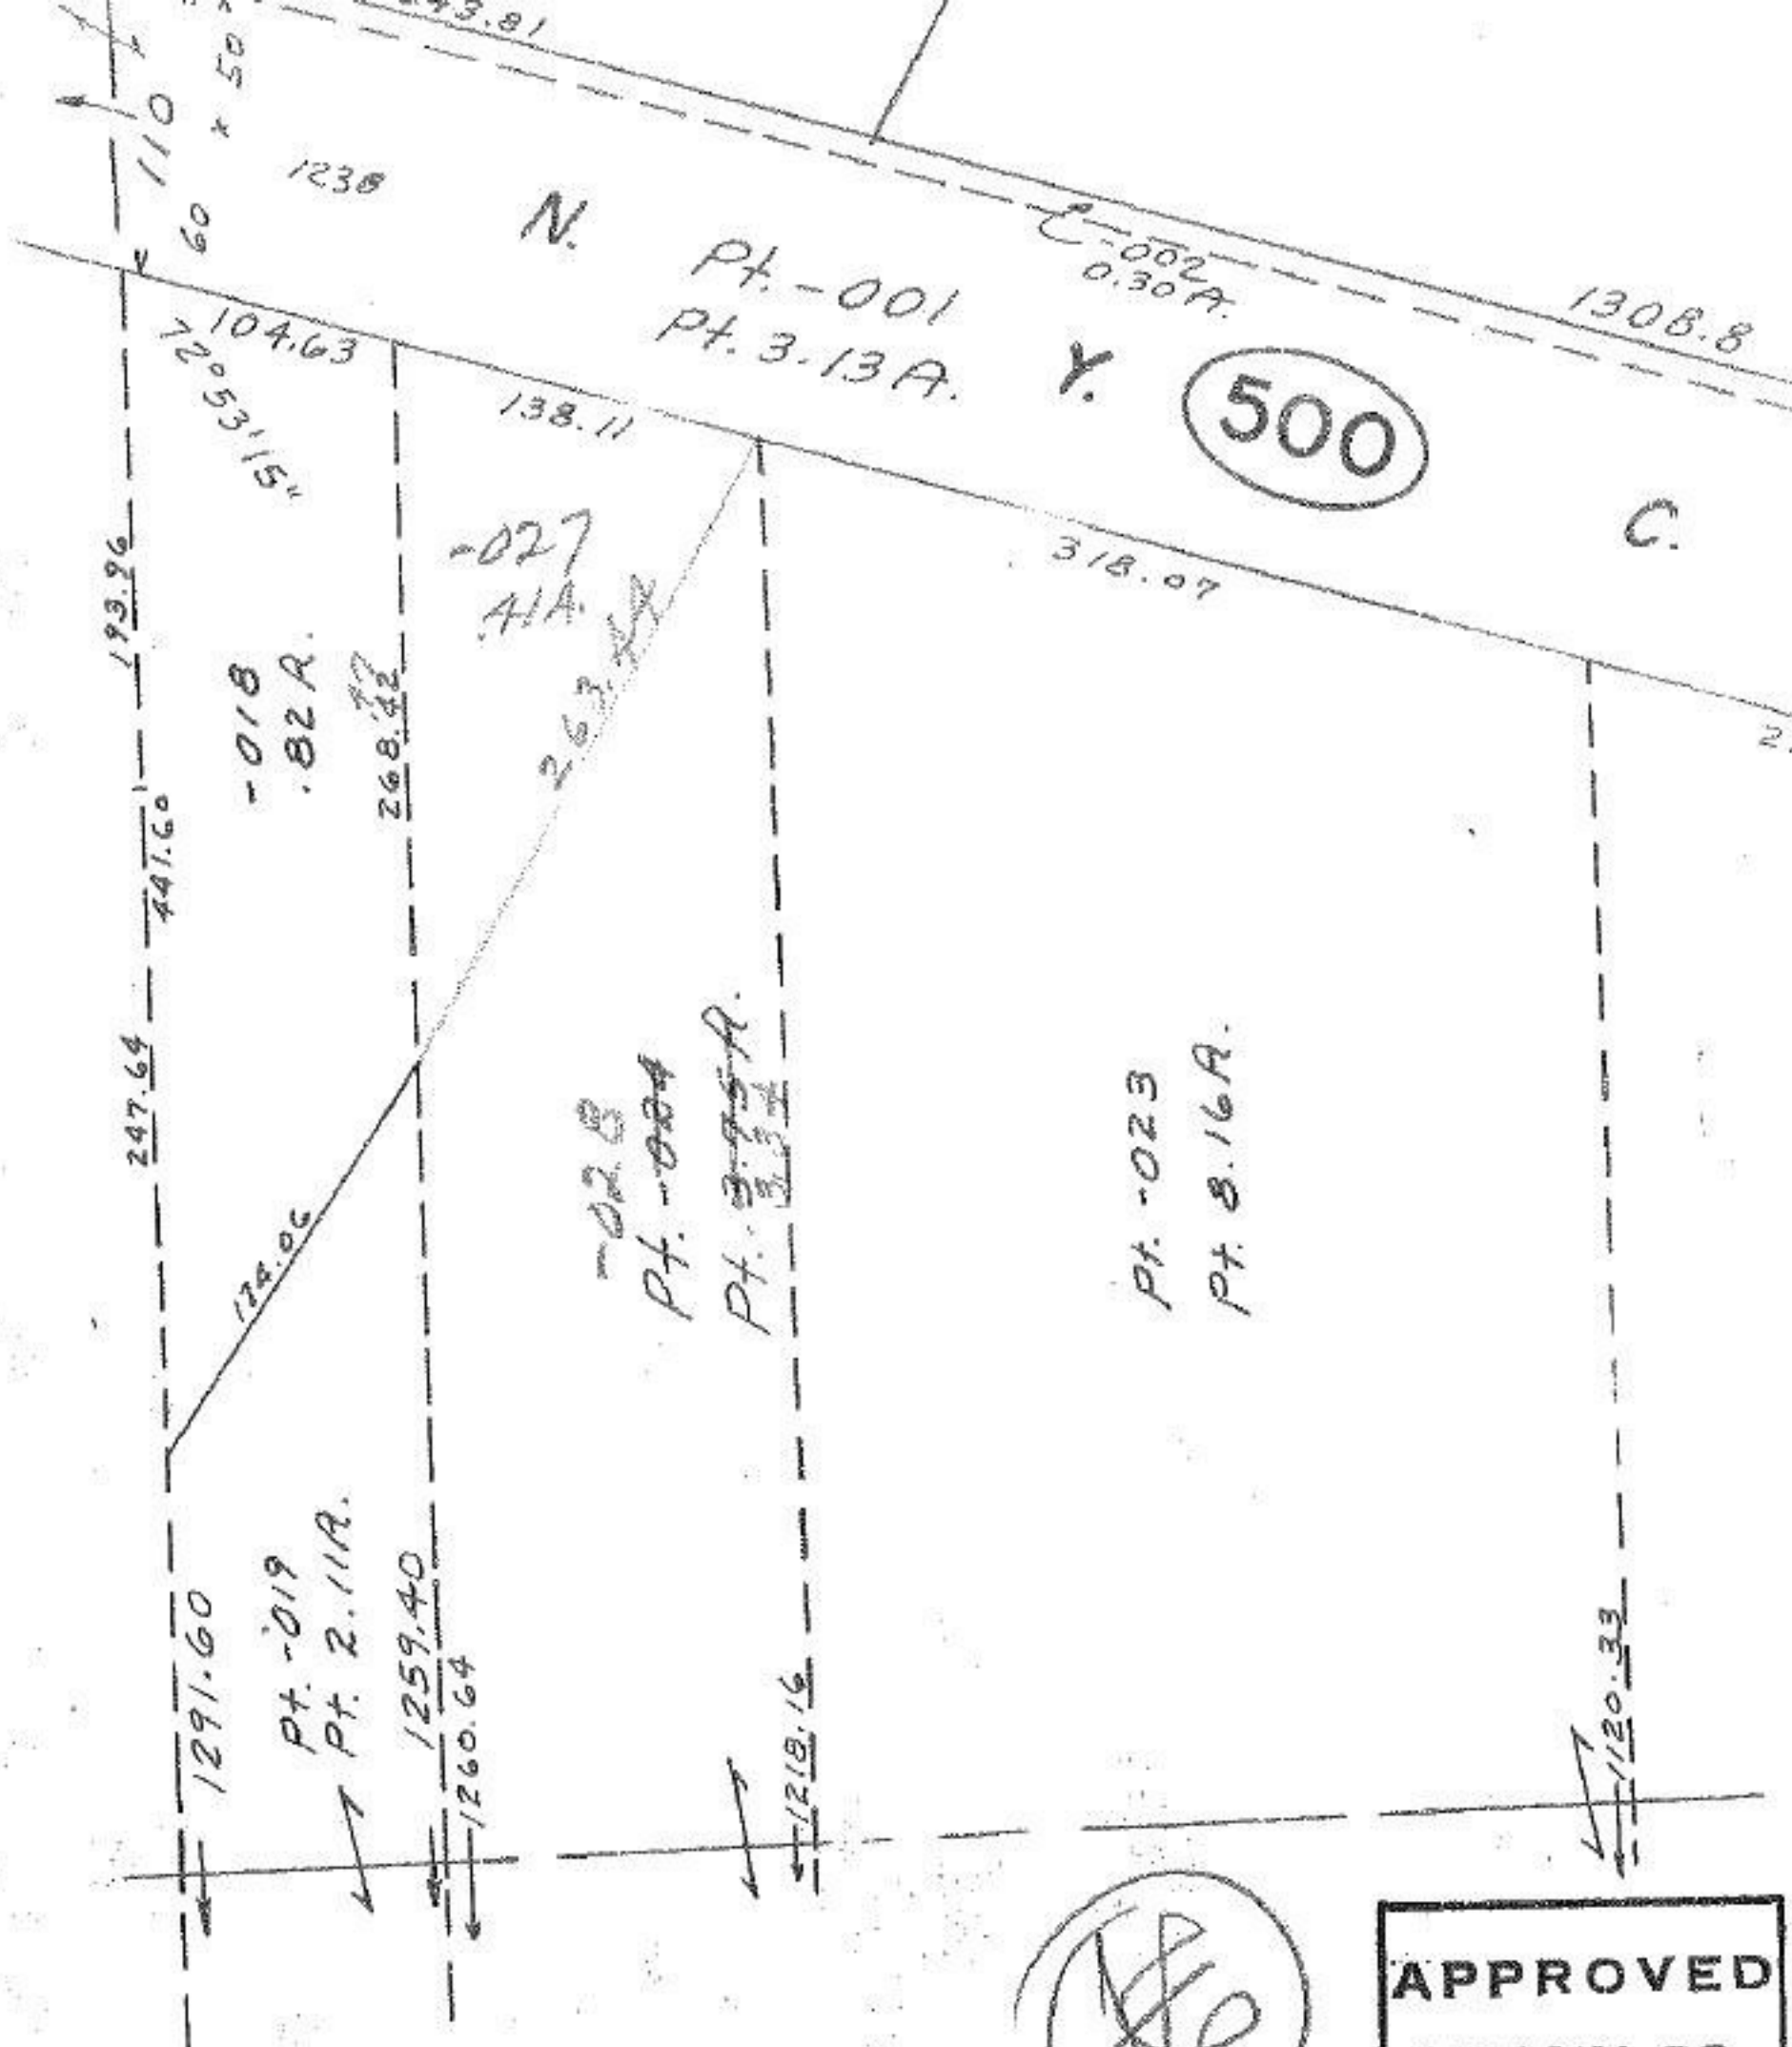

*(Handwritten signature in a circle)*

3001  
SEP 4 1969

APPROVED
LORAIN CO.
MAP DEPT.
DATE 8/29/69
BY [Handwritten Signature]

ELYRIA TWP.

SCALE: 1" = 100'

Copyright 1963  
Revised 3-5-69

6-75