
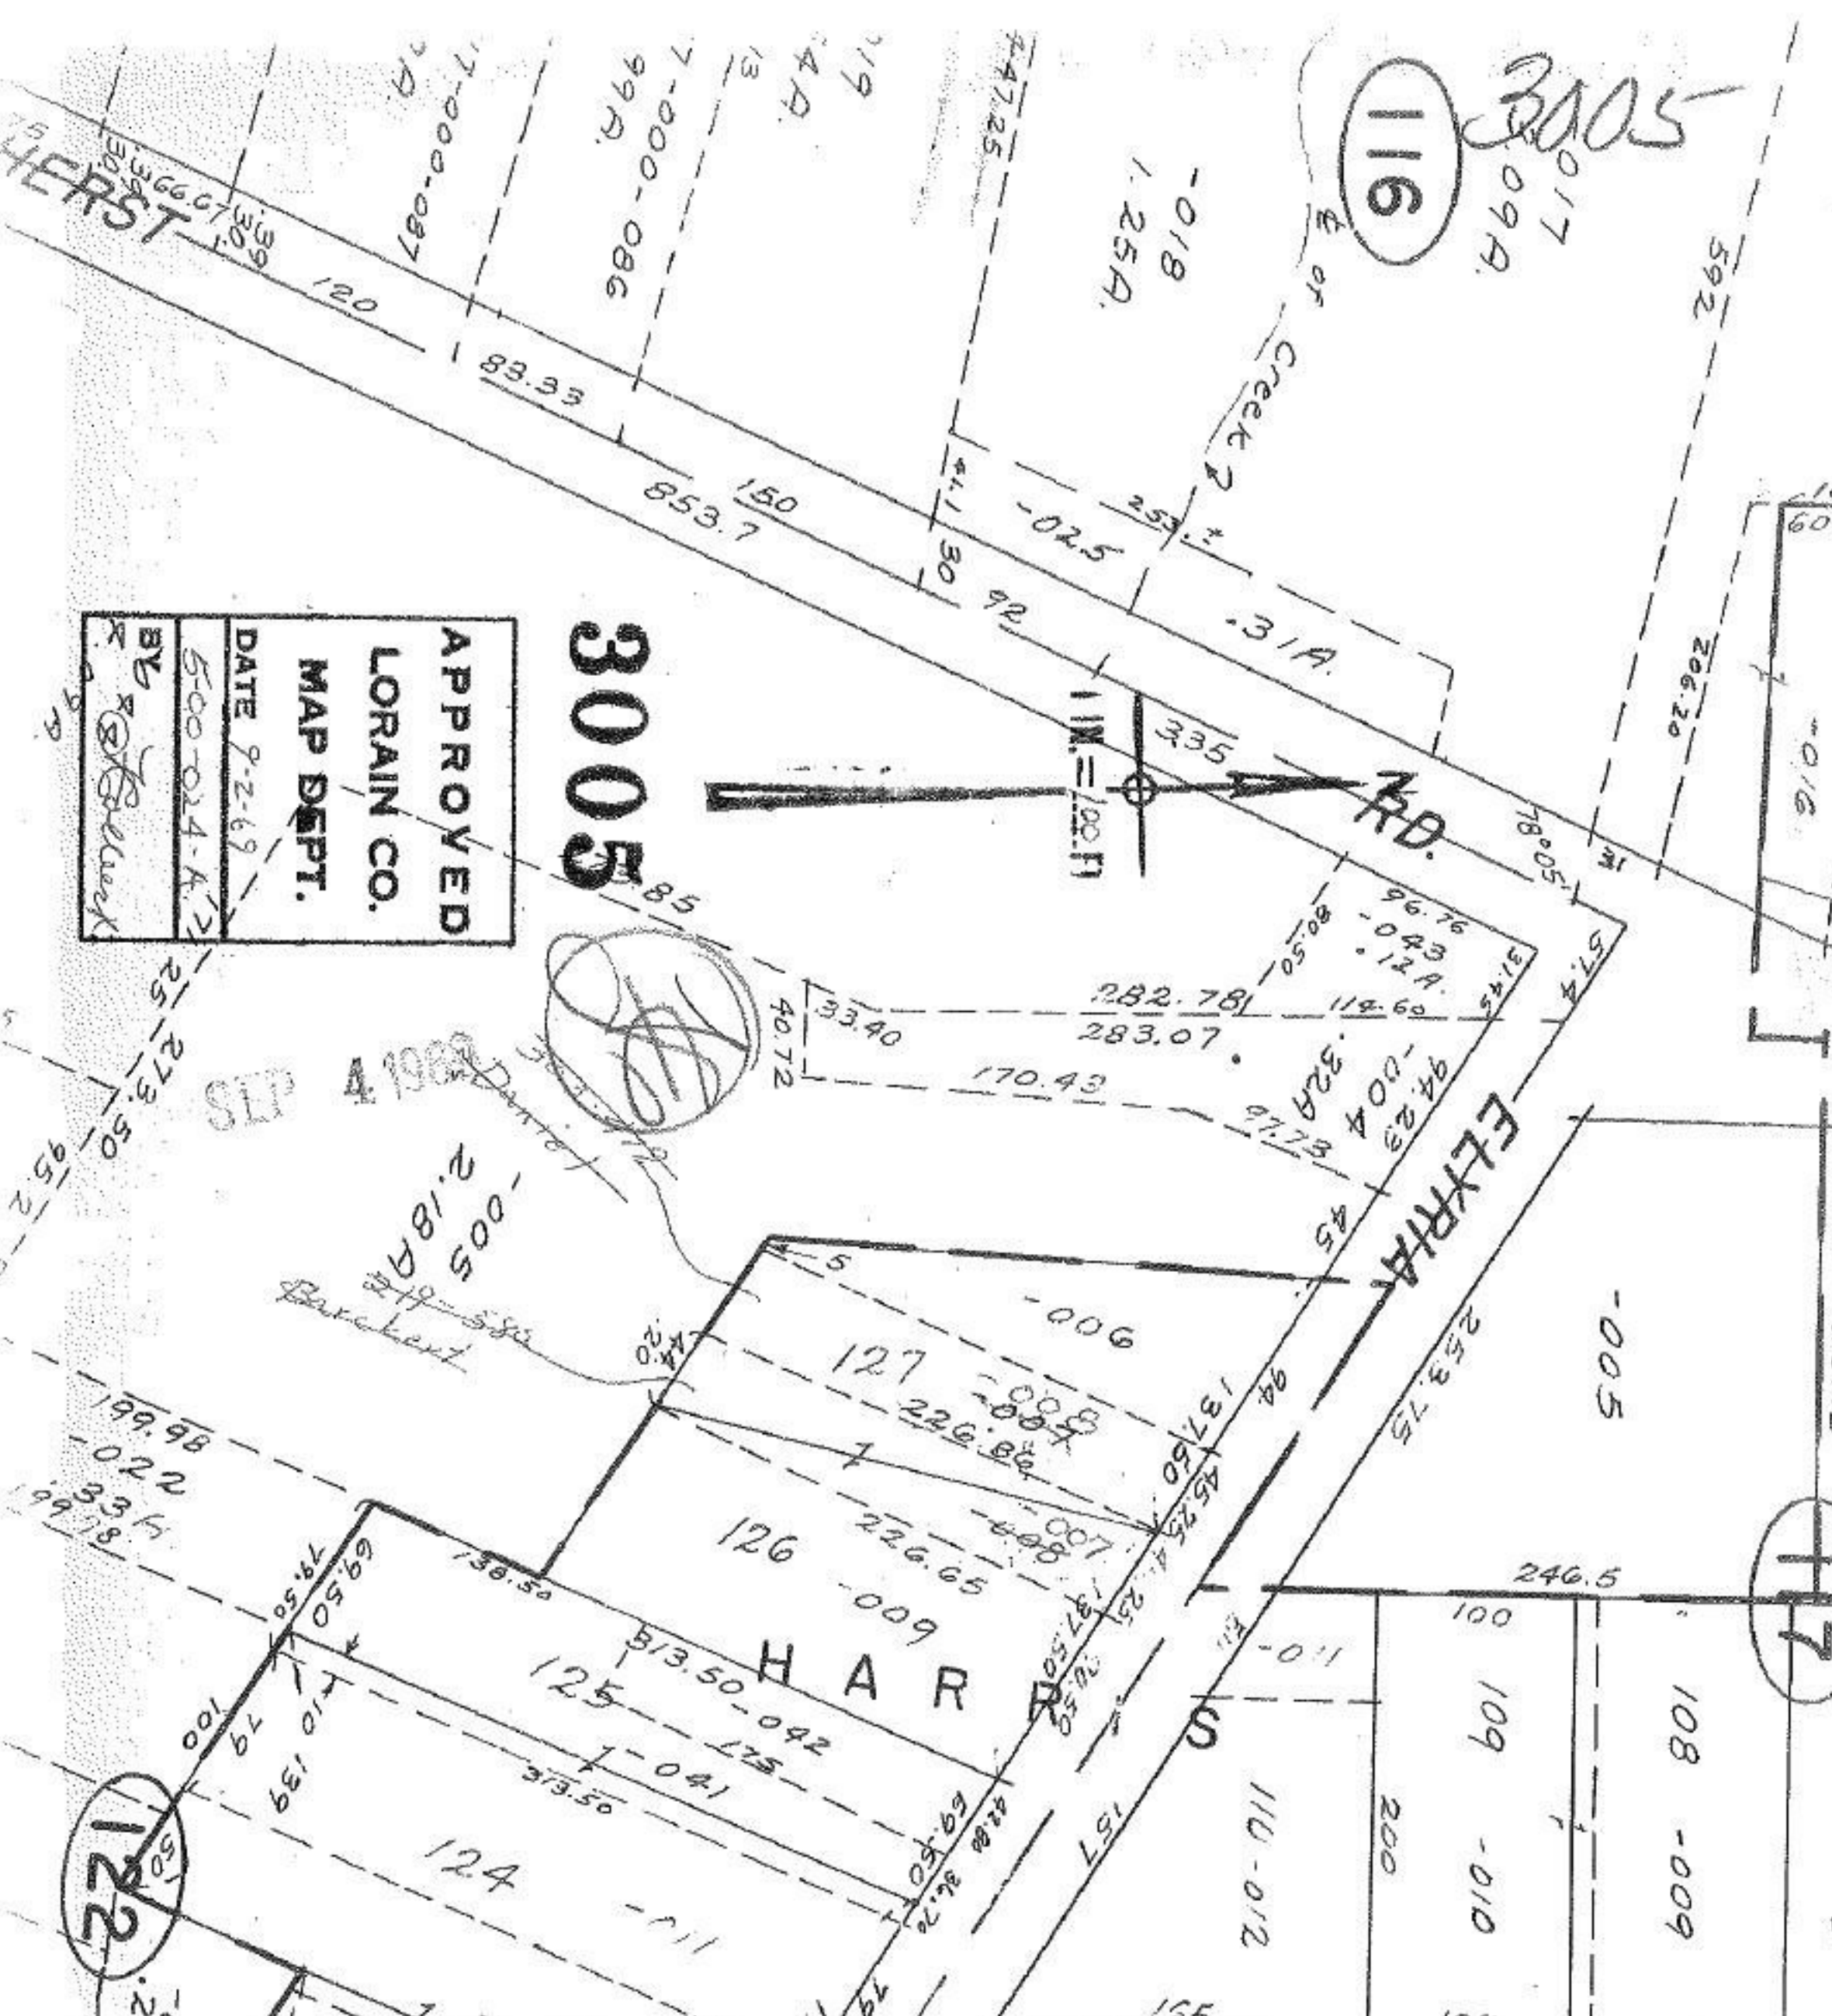


3005  
017  
099  
116

**APPROVED**  
**LORAIN CO.**  
**MAP DEPT.**  
DATE 9-2-69  
5-00-024-A-1  
BY R. J. [Signature]  
K. [Signature]

**3005**

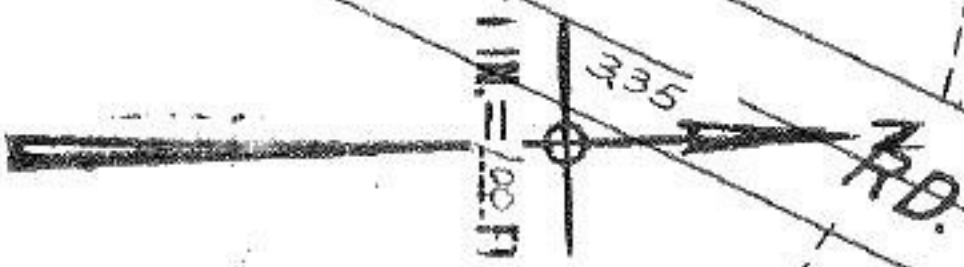

SEP 1969

Parcel  
2.18 A  
1969