

3011

-C
5.4

1364.71

~~-007~~
20.04A

1378.37

~~-009~~
~~-006~~
61.92A
41.88A

68

-002
83.69A - D.
87.00A - DUP.


-001
100
30.00A

ISLAND

857.51
-005
15.08A.

500
436
-003
5.00A
436

LAW

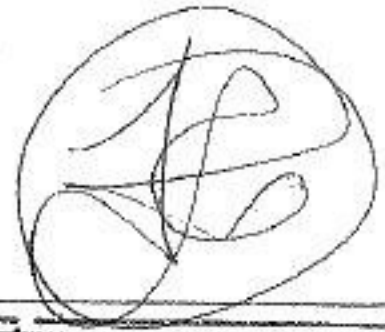

518.17 357.51

1022.83

1918.34

-008
9.69A

580.50	580.5	580.5	580.5	580.5	580.5	580.5
-006	-009	-012	-014	4.00A	2.00A	2.00A
2.00A	2.00A	2.00A	2.00A	4.00A	2.00A	2.00A
580.5	580.5	580.5	580.5	580.5	580.5	580.5
150.08	150.08	150.08	150.08	150.08	150.08	150.08

824.02
(60)

431.90

1332.31

APPROVED
LORAIN CO.
MAP DEPT.

DATE 9/13/69

By 16-H

BY

285.1

-003