


3015 ASHLA

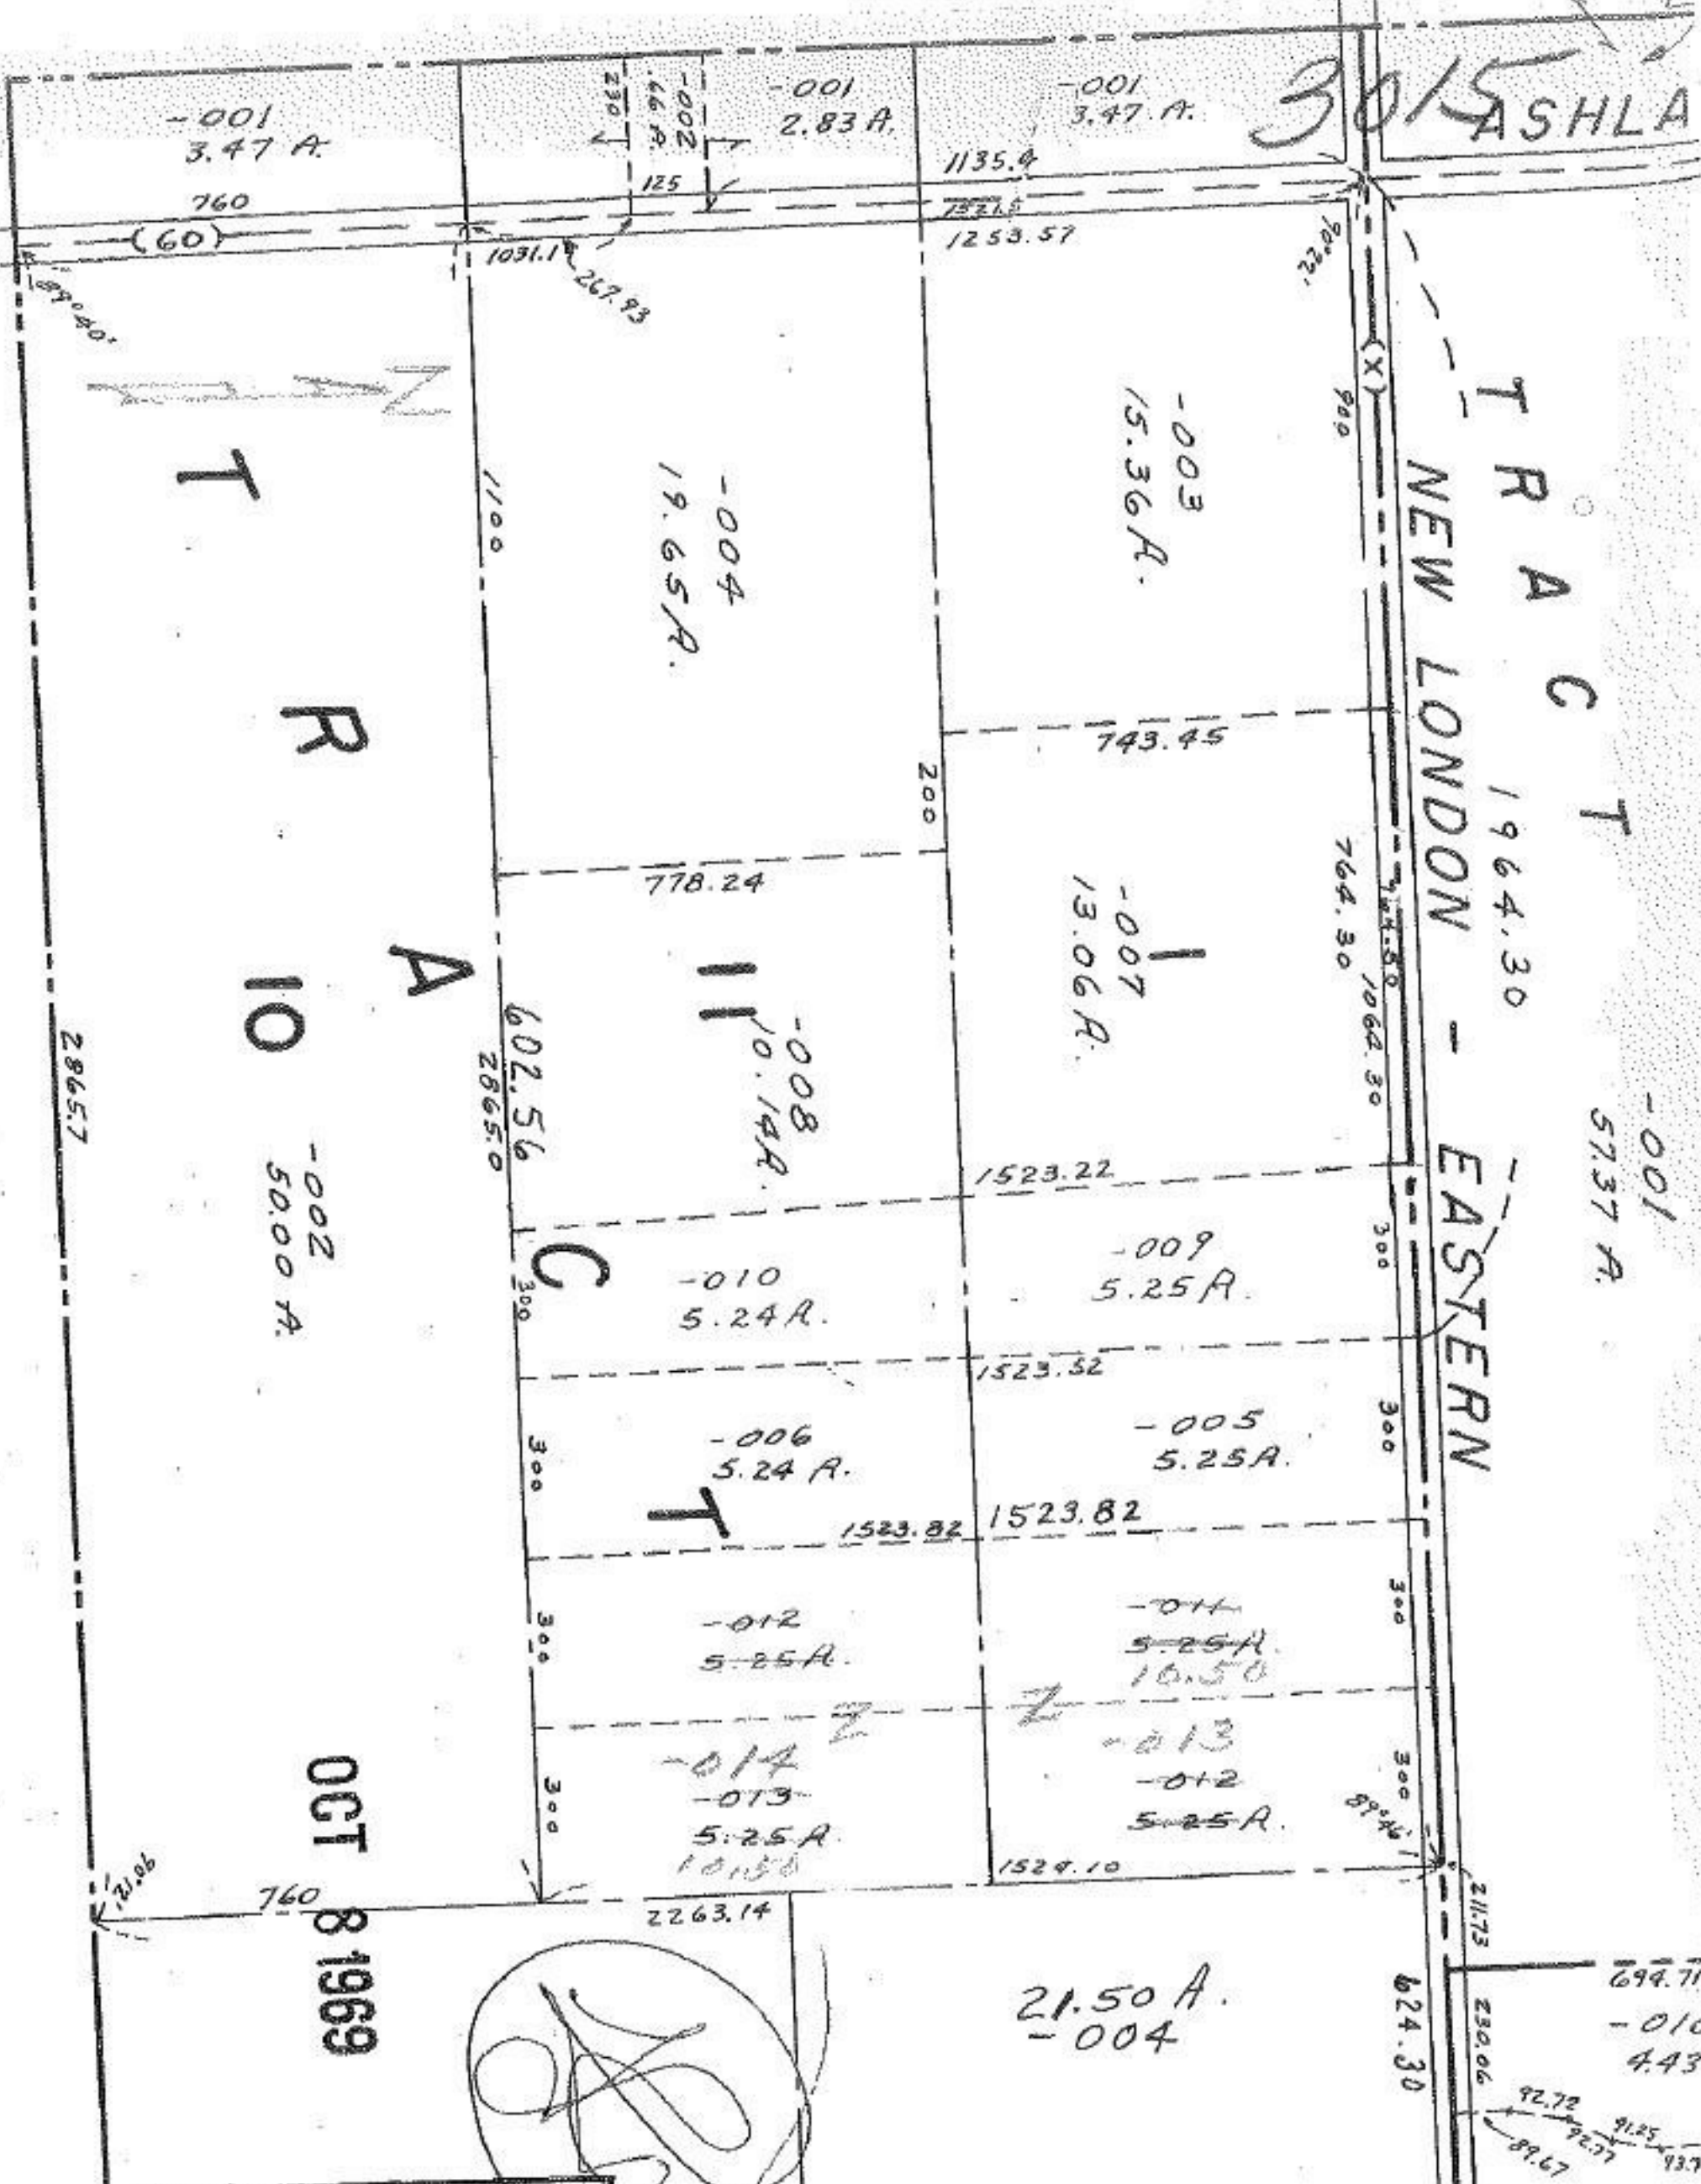

58

HUNTINGTON TWP.

SCALE: 1" = 400'

OCT 8 1969

