


3038
2

-030
148.65A

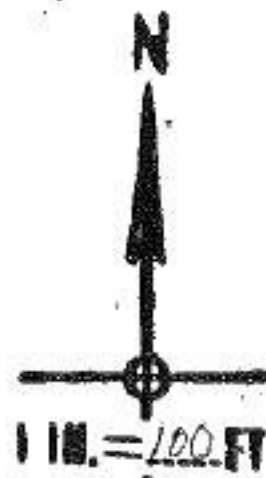

1319.0

90°01'

89°37'



~~012~~
~~49.00A~~

-035
50.00A

3038 -024
54.68A

APPROVED
LORAIN CO.
MAP DEPT.
DATE 9-15-69
10-B
BY *Hall*

OCT 8 1969

J.S.
7-29-86

1736.46

1735.0

90°03'

90°19'

348.49
1011
1000A

RUSSIA

7367.0

1367.32

(60)