


3040



APPROVED  
 LORAIN CO.  
 MAP DEPT.  
 DATE 9-16-69  
 11-00-095-B  
 BY *[Signature]*

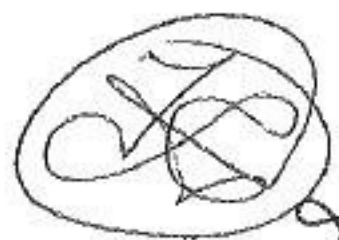


*38-05-L  
 S.P.*

OCT 8 1969

ELYRIA - TWINSBURG

3040

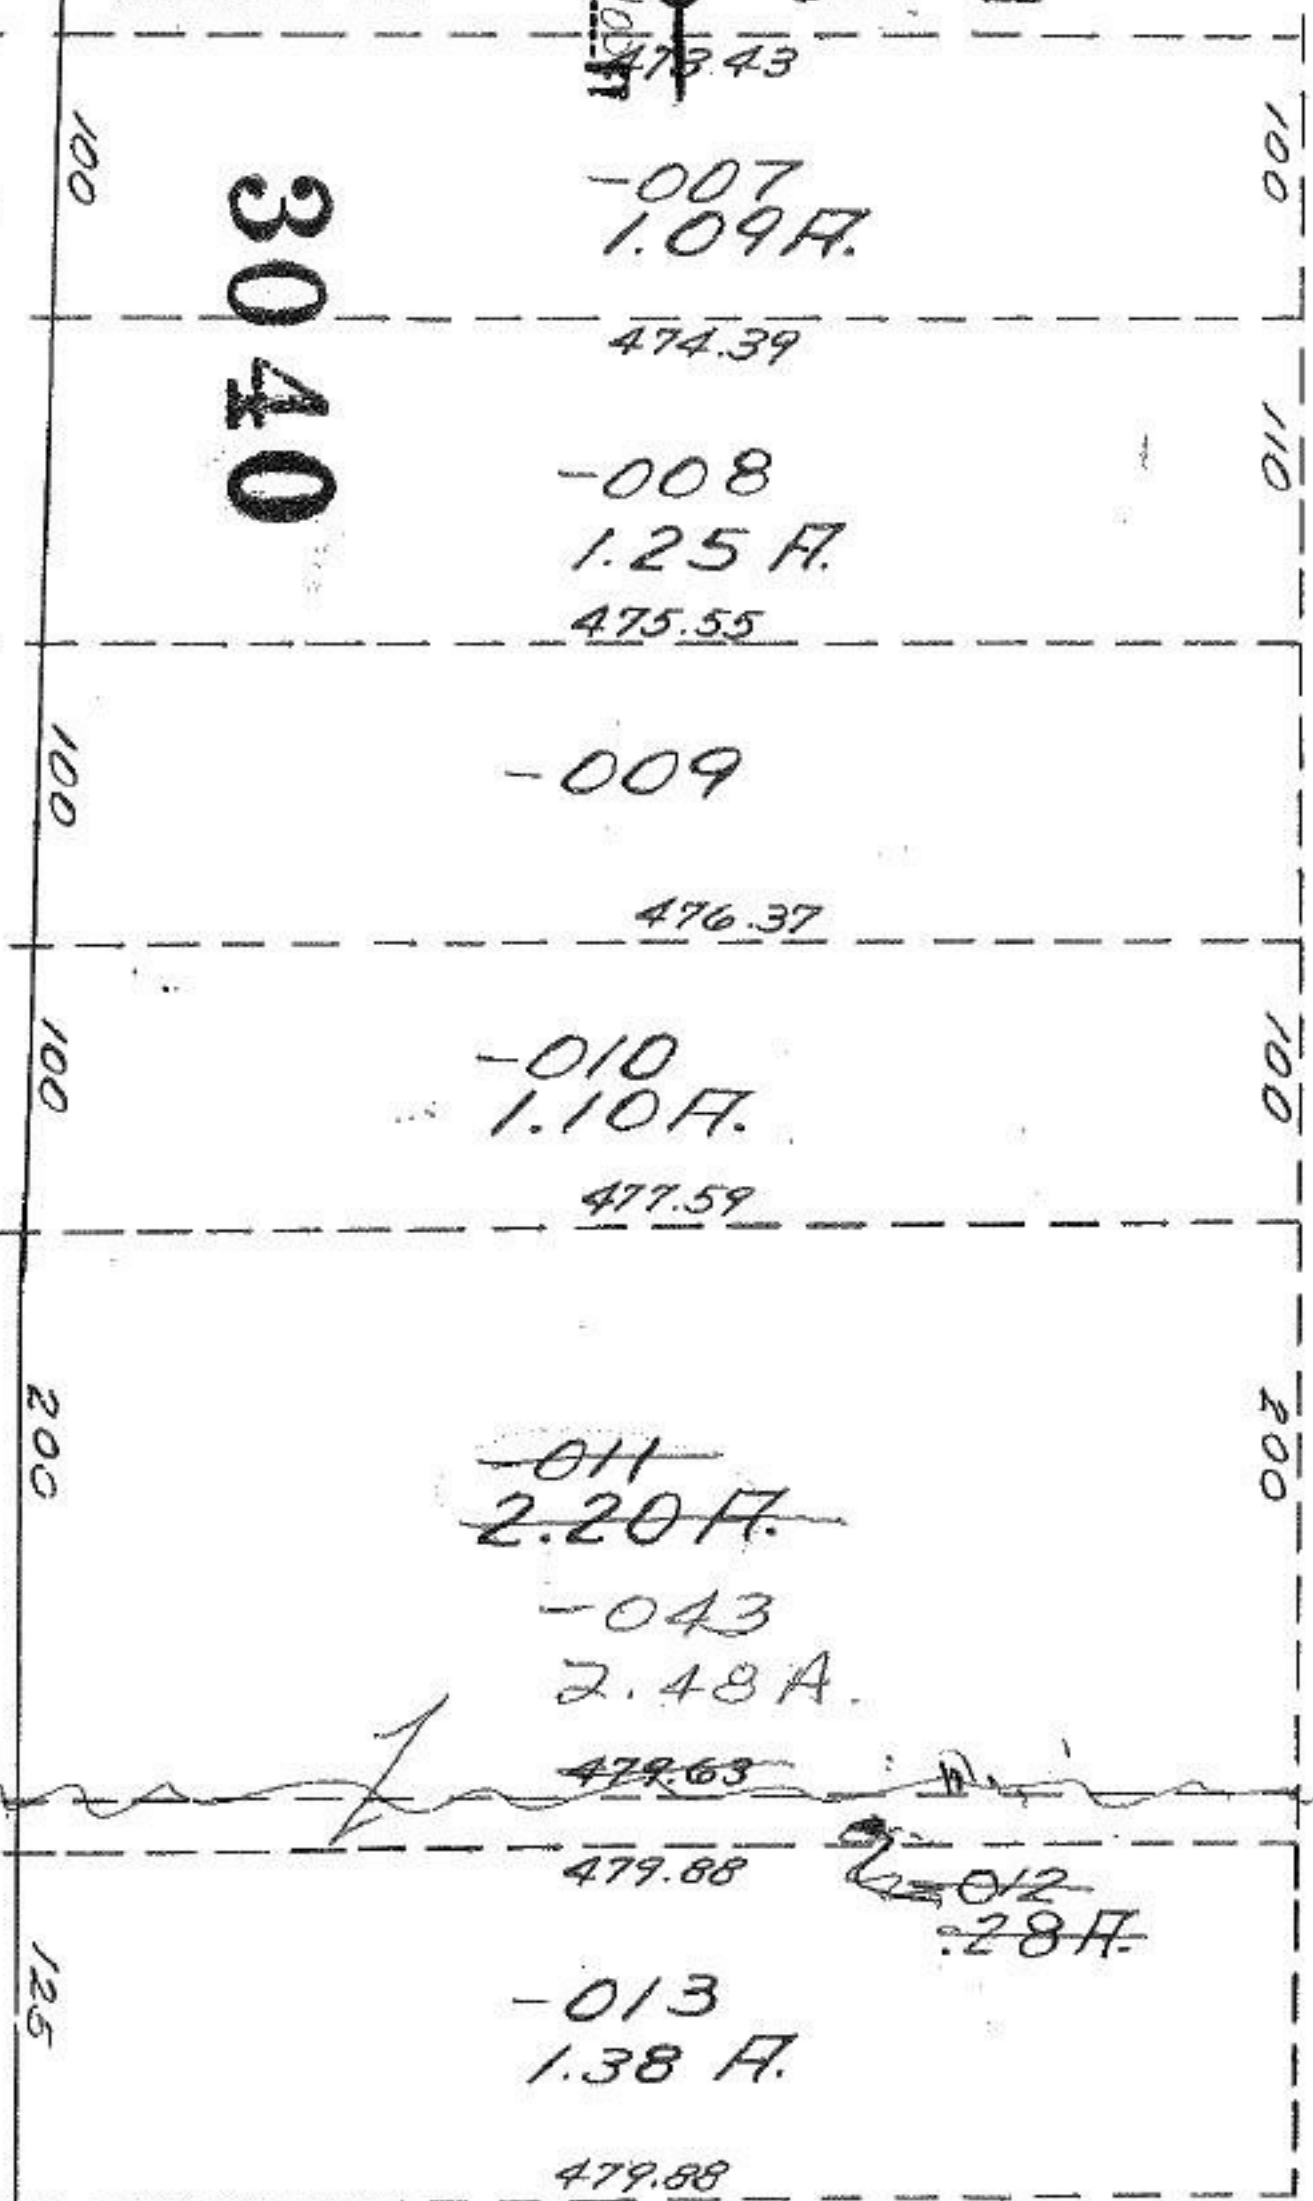

ELYRIA TWP