

3064

APPROVED  
 LORAIN CO.  
 MAP DEPT.  
 DATE 9/24/69  
 139-00-001-C  
 BY  
 R. J. Kellings

7-29-86 L.L.H.


AT 81503

3064

Pt. -021  
Pt. 30.57A.



-00-012-D

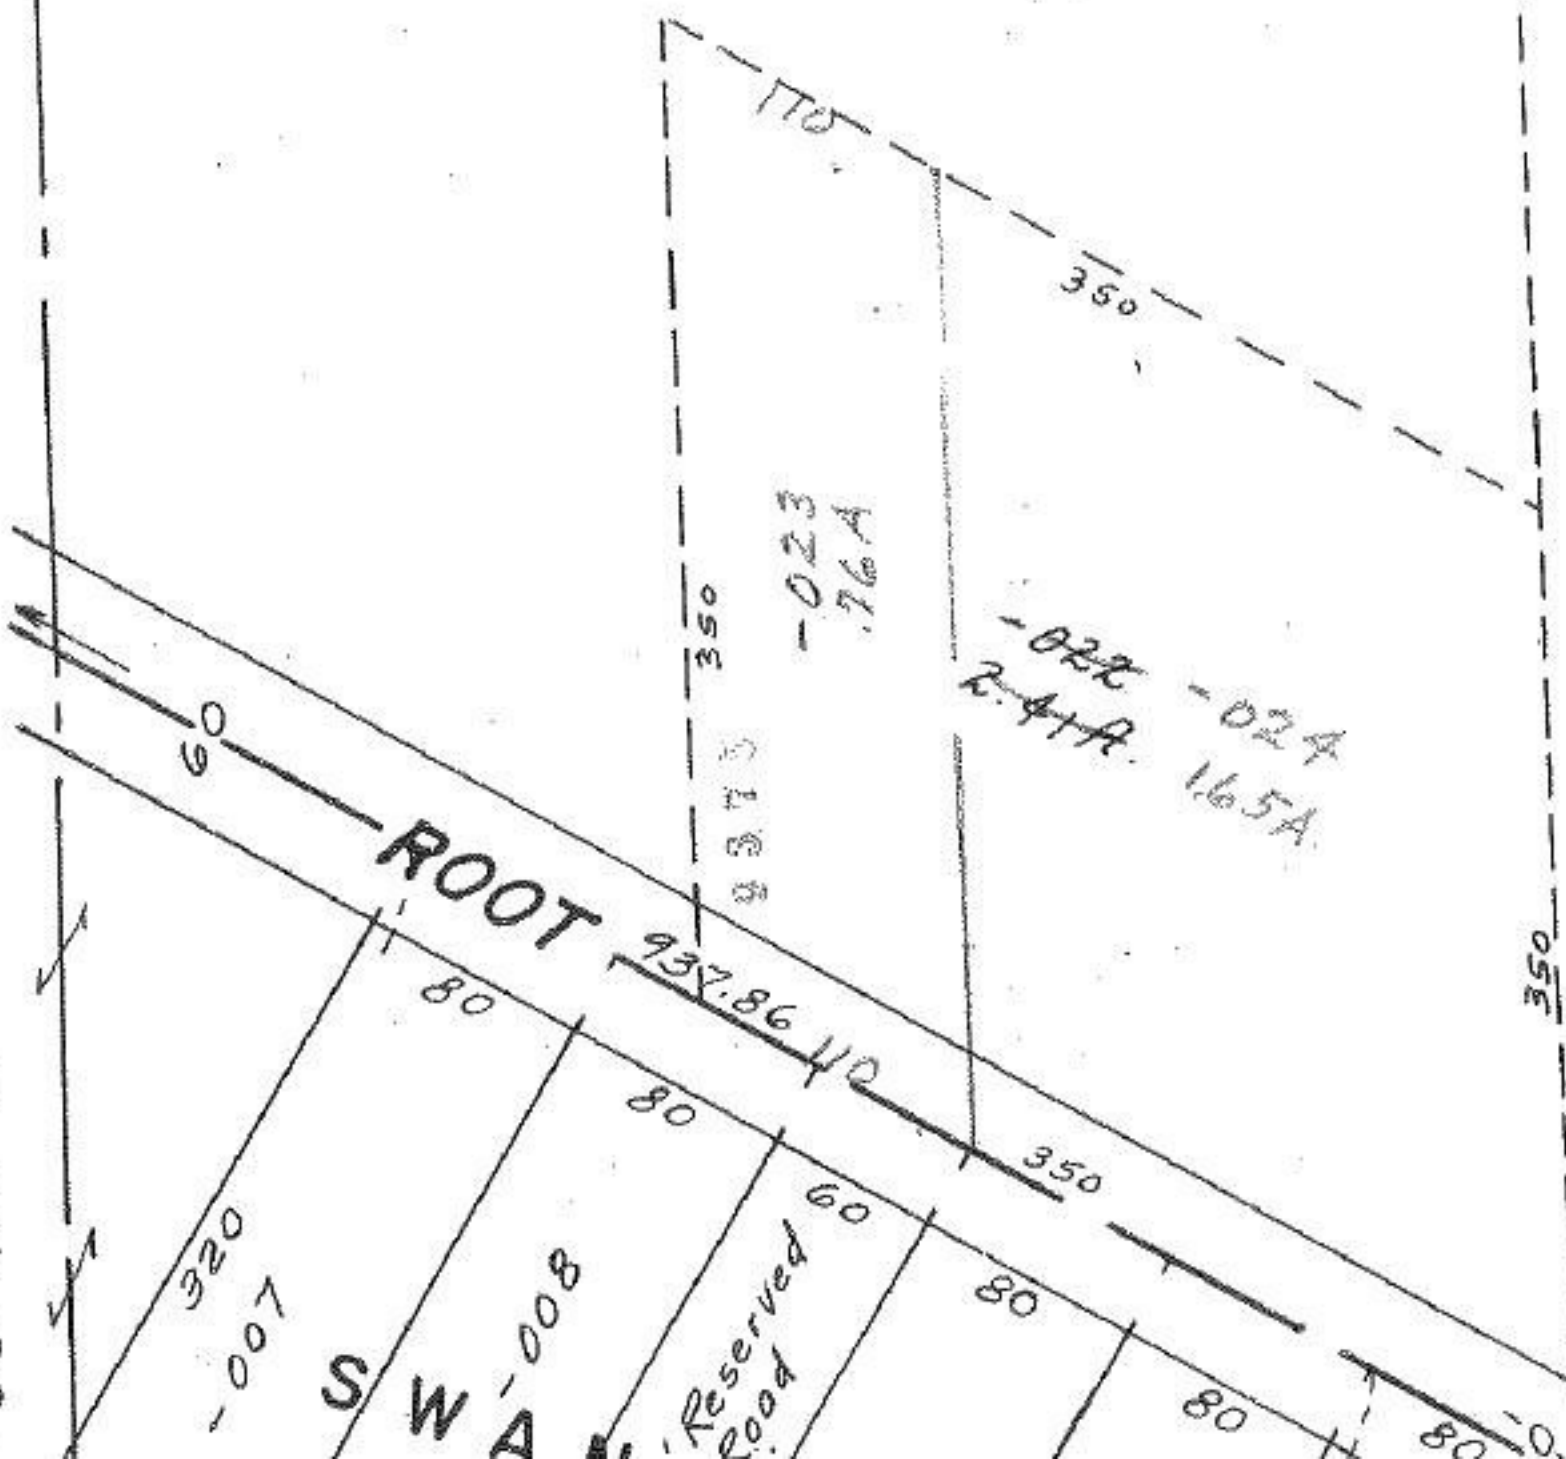

LORAIN