

3075


OCT 28 1969

Pt. -030

Pt. 64.55

3075

| |
|------------------|
| APPROVED |
| LORAIN CO. |
| MAP DEPT. |
| DATE 9/26/69 |
| BY R. J. Redding |

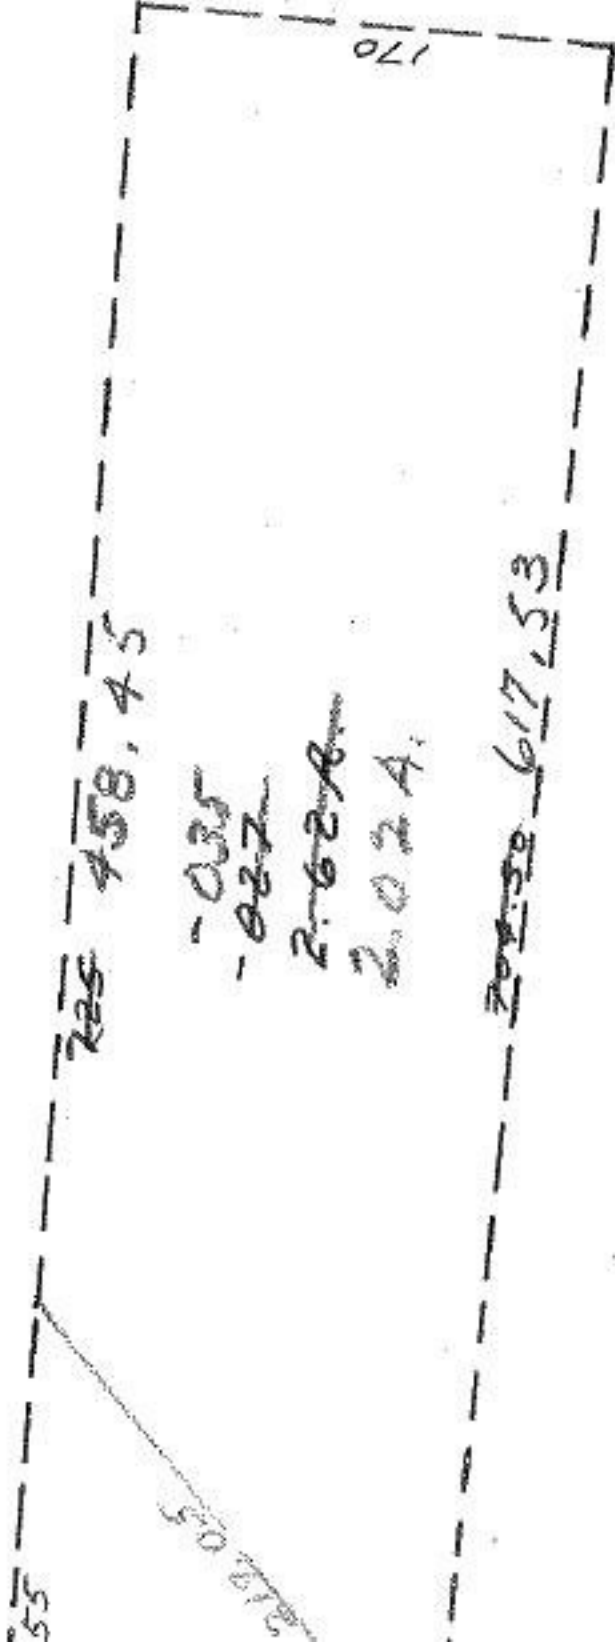

103

725.00
 266.55
 458.45

704.50
 86.97
 617.53