
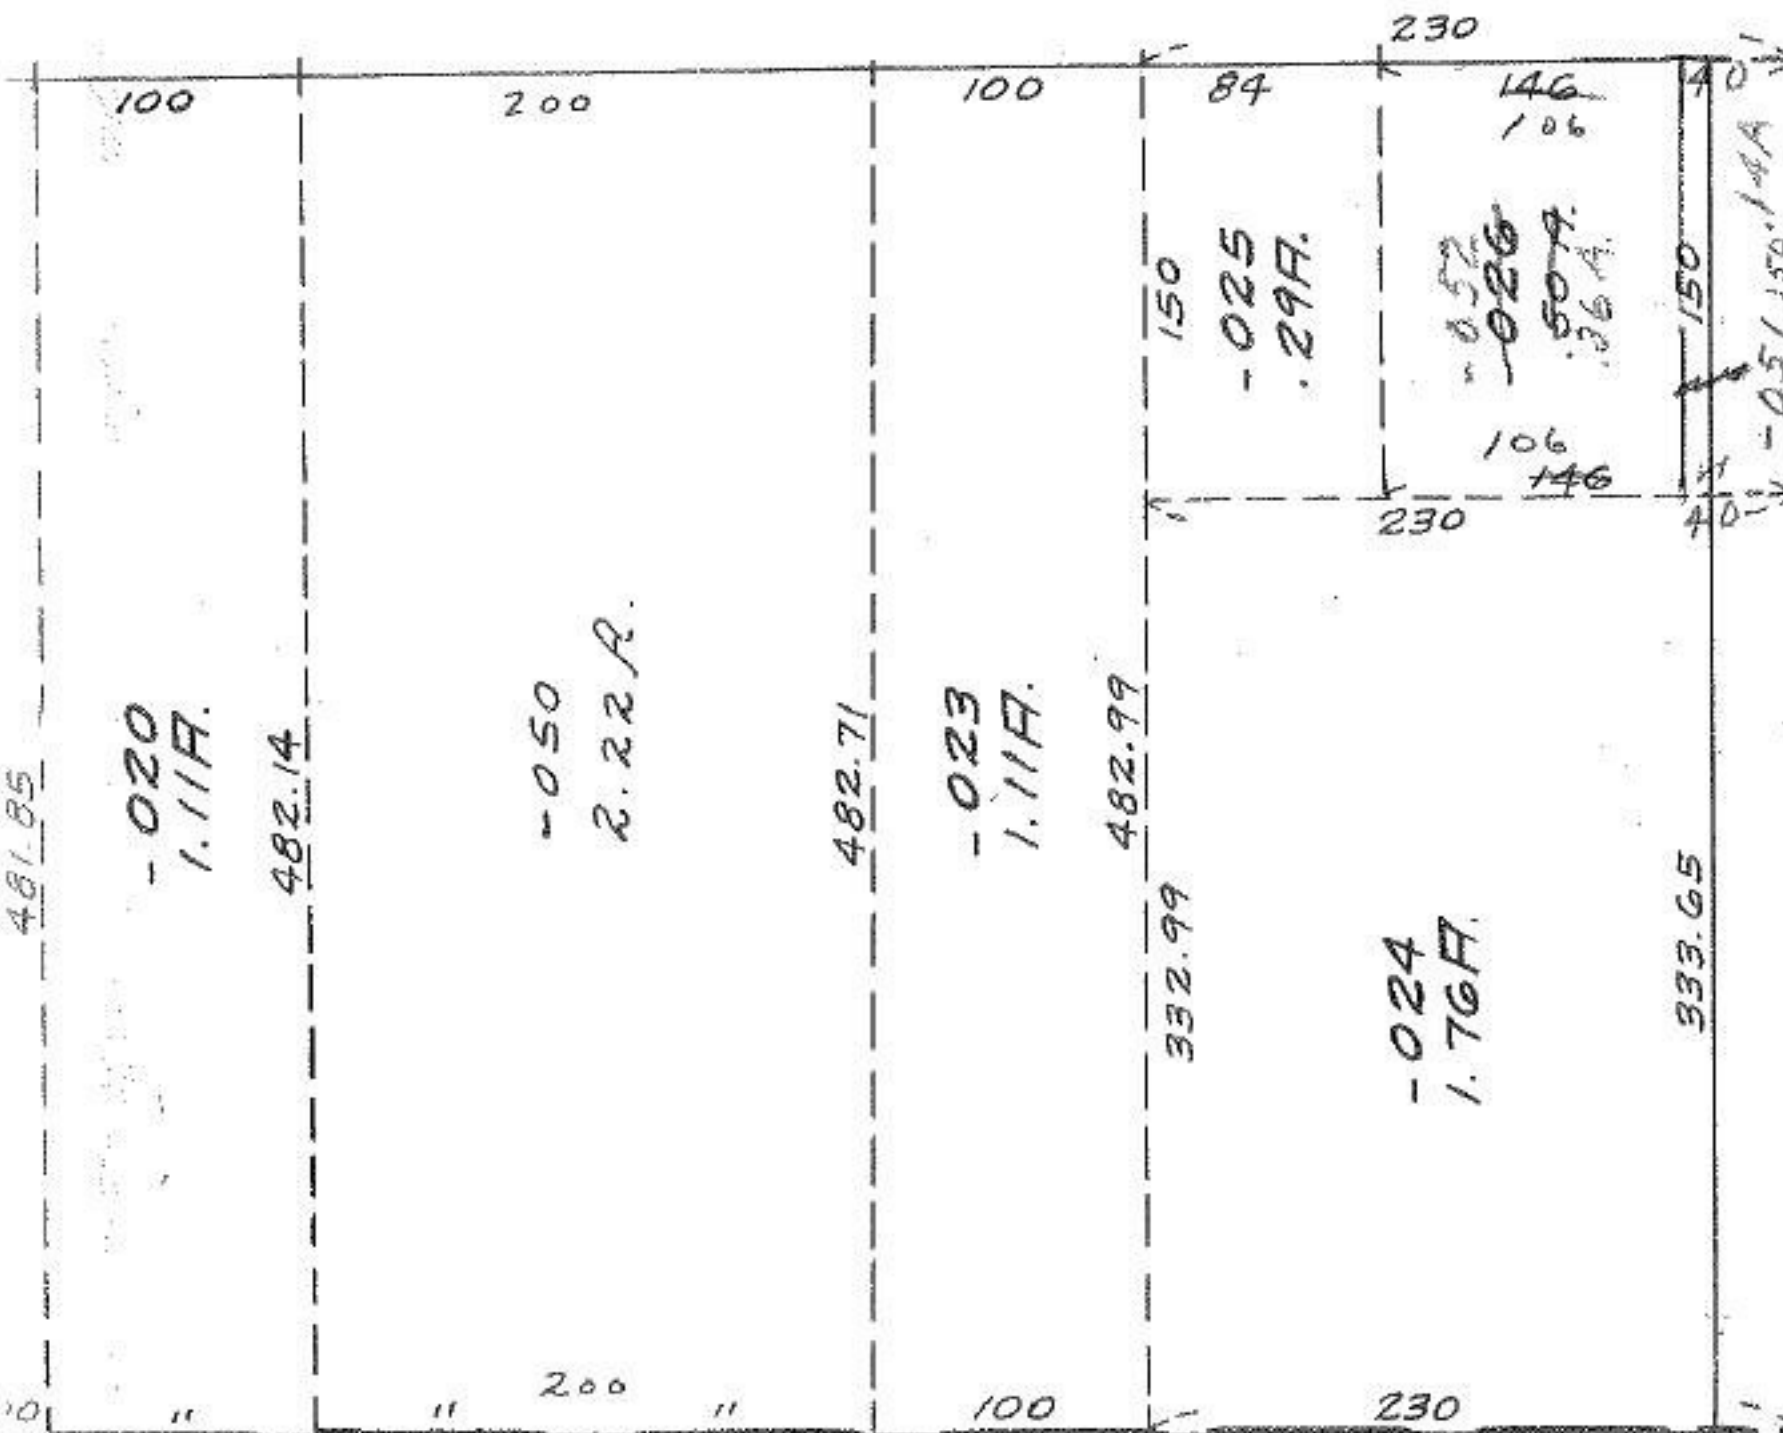


2.88A

3099

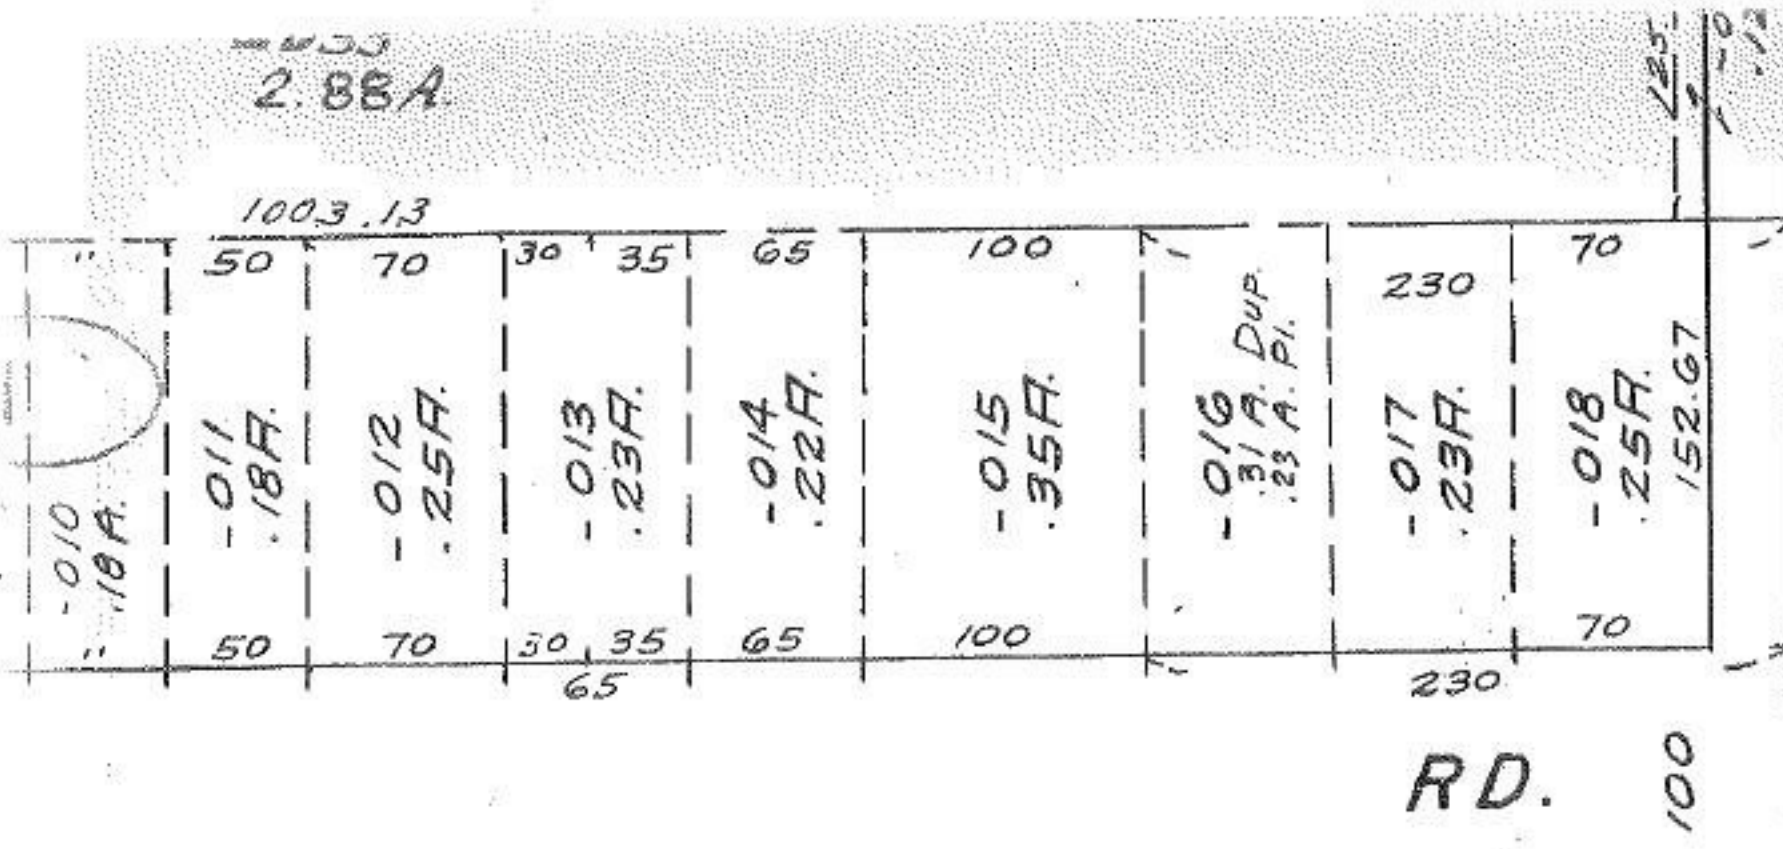

SEE 6-71

3099

APPROVED
 LORAIN CO.
 MAP DEPT.
 DATE 10/6/69
 6-70
 BY R.V. Kelling

OCT 28 1969